


WILLIAM B. BARTON  
 Reg. Land Surveyor No. 4438  
 188 PARKWOOD AVENUE  
 AVON LAKE, OHIO 44012  
 TELEPHONE (216) 933-6662

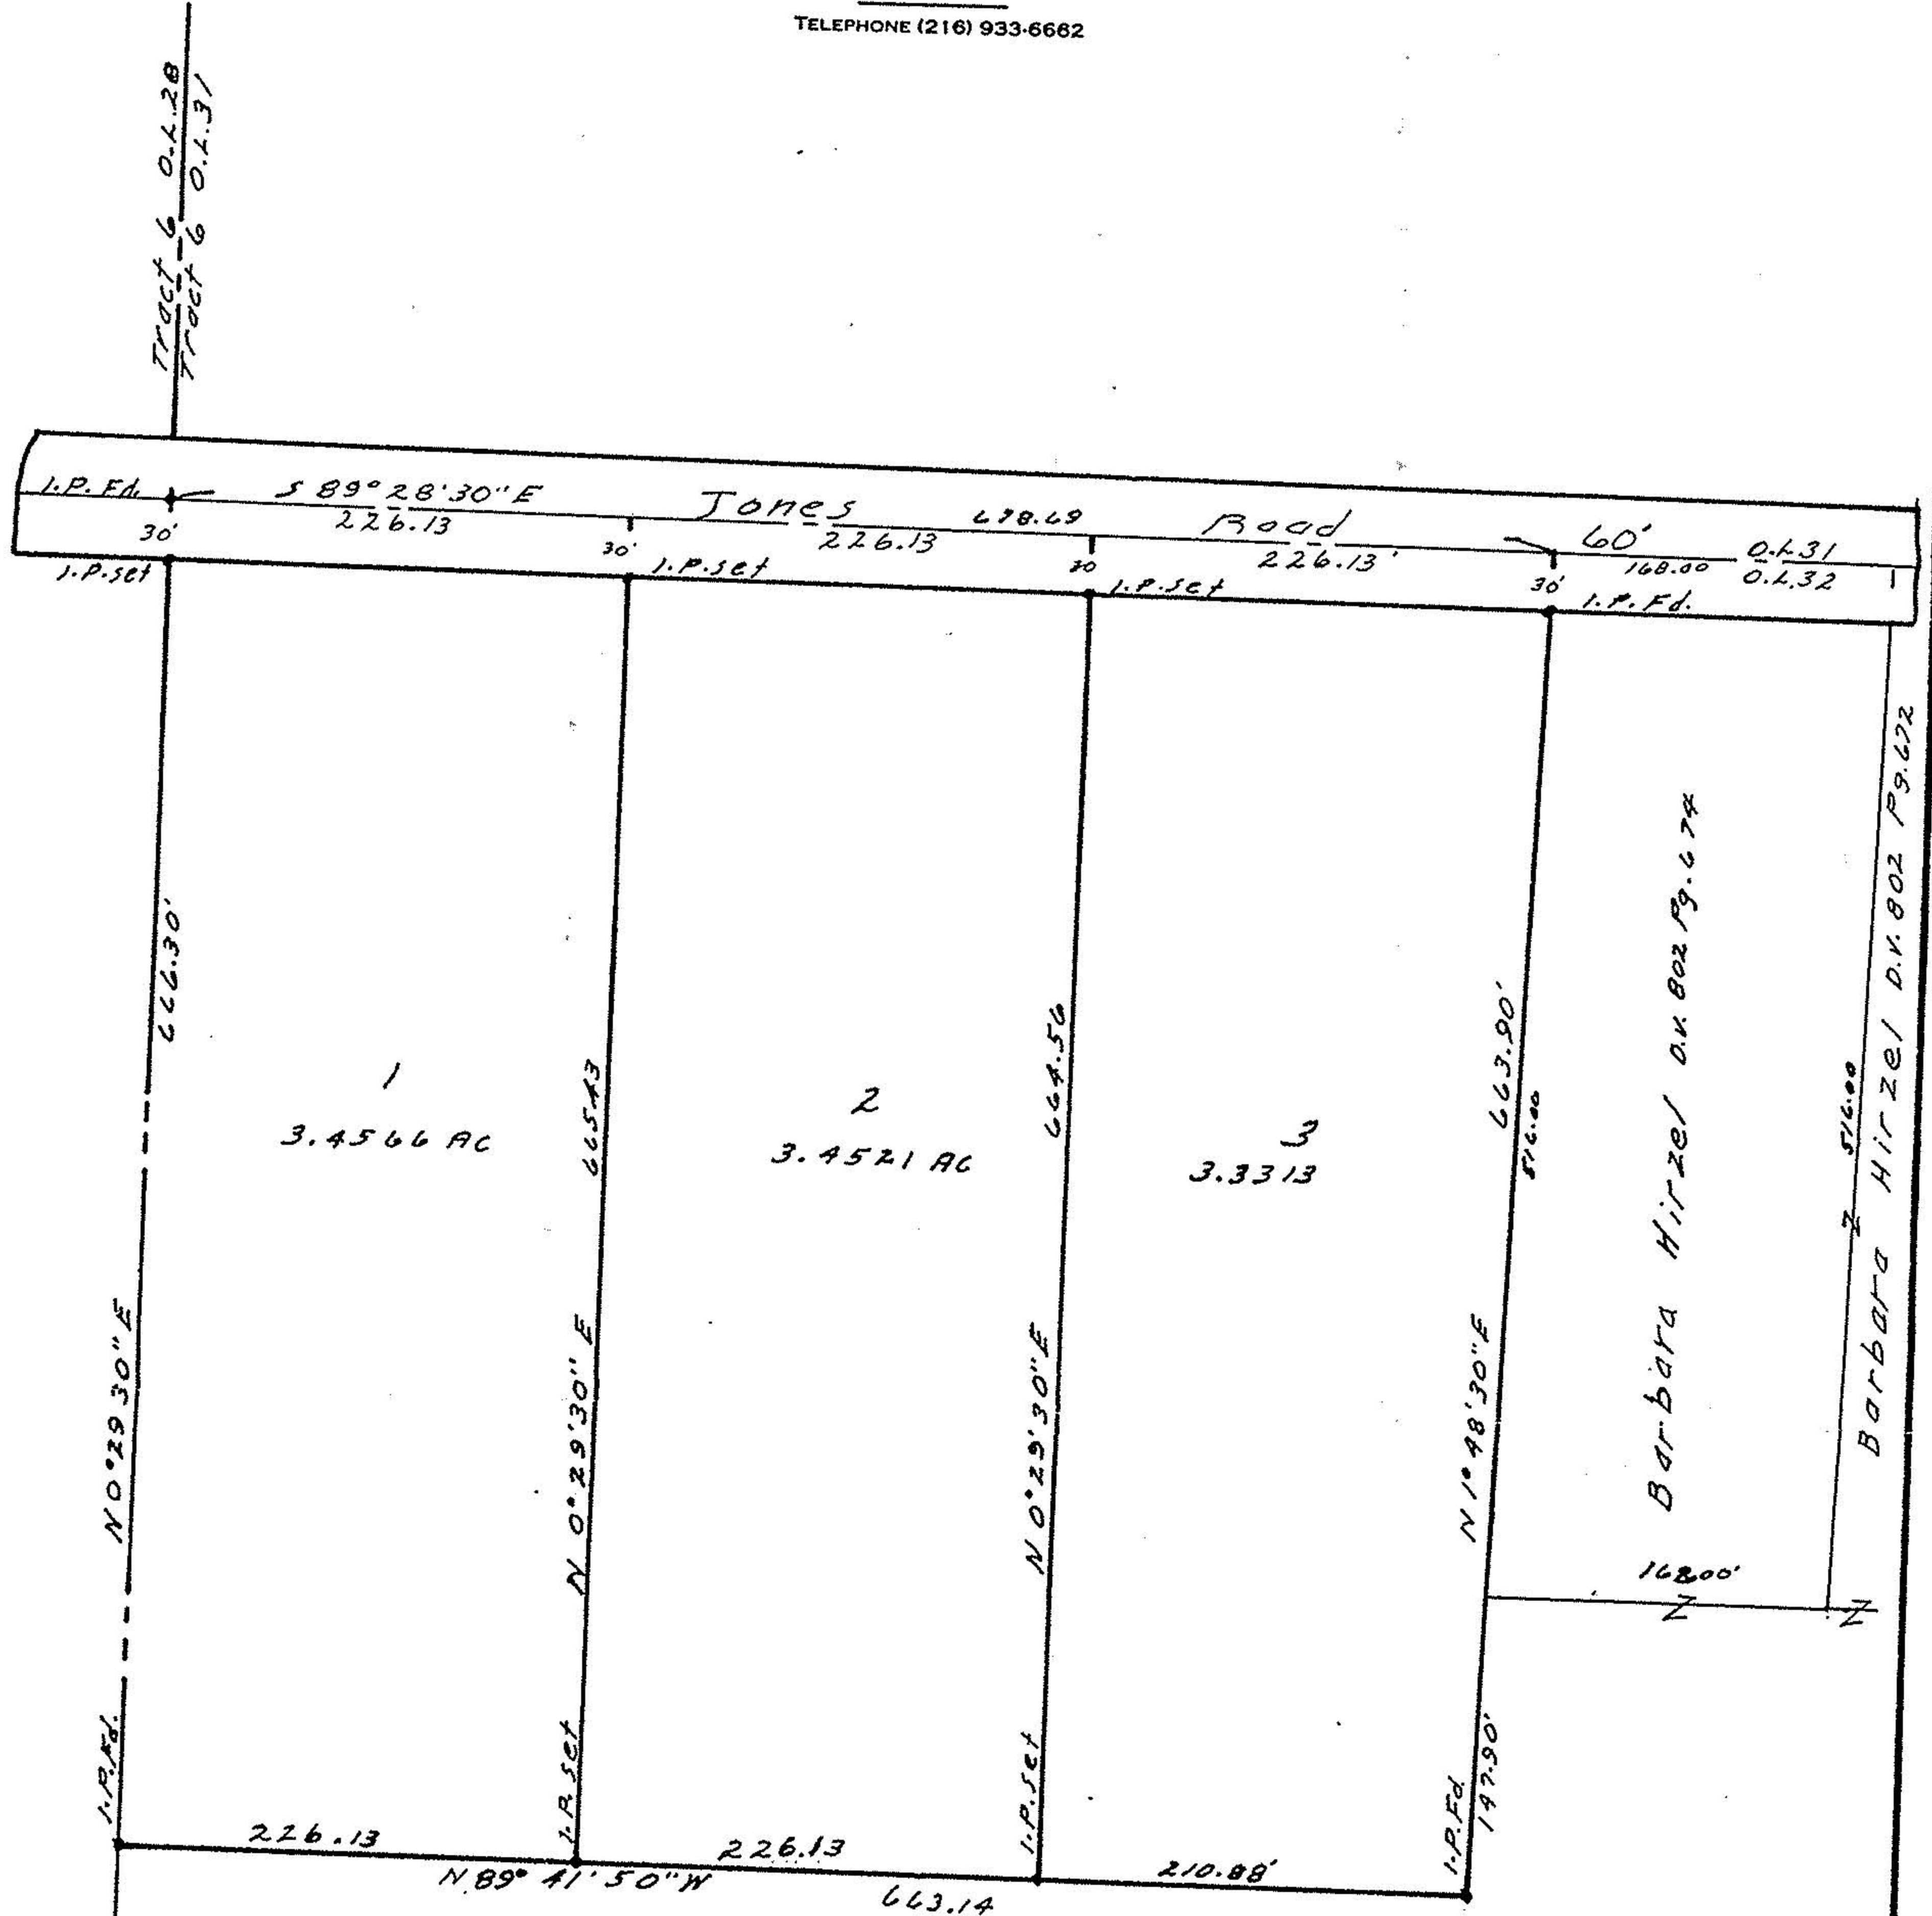

Barbara Hirtzel D.V. 804 Pg. 540

#17115

APPROVED  
 LORAIN CO.  
 MAP DEPT.  
 DATE 11-19-86  
 PAGE 17-14  
 BY T. McMan  
 VOID AFTER

SURVEY  
 of  
 Of part of Tract No. 6 Original  
 Lot No. 32 Brighton Township  
 Lorain County Ohio... Oct. 1986.  
 Scale 1"=100'

