


WILLIAM B. BARTON
 Reg. Land Surveyor No. 4438
 188 PARKWOOD AVENUE
 AVON LAKE, OHIO 44012
 TELEPHONE (216) 933-6662

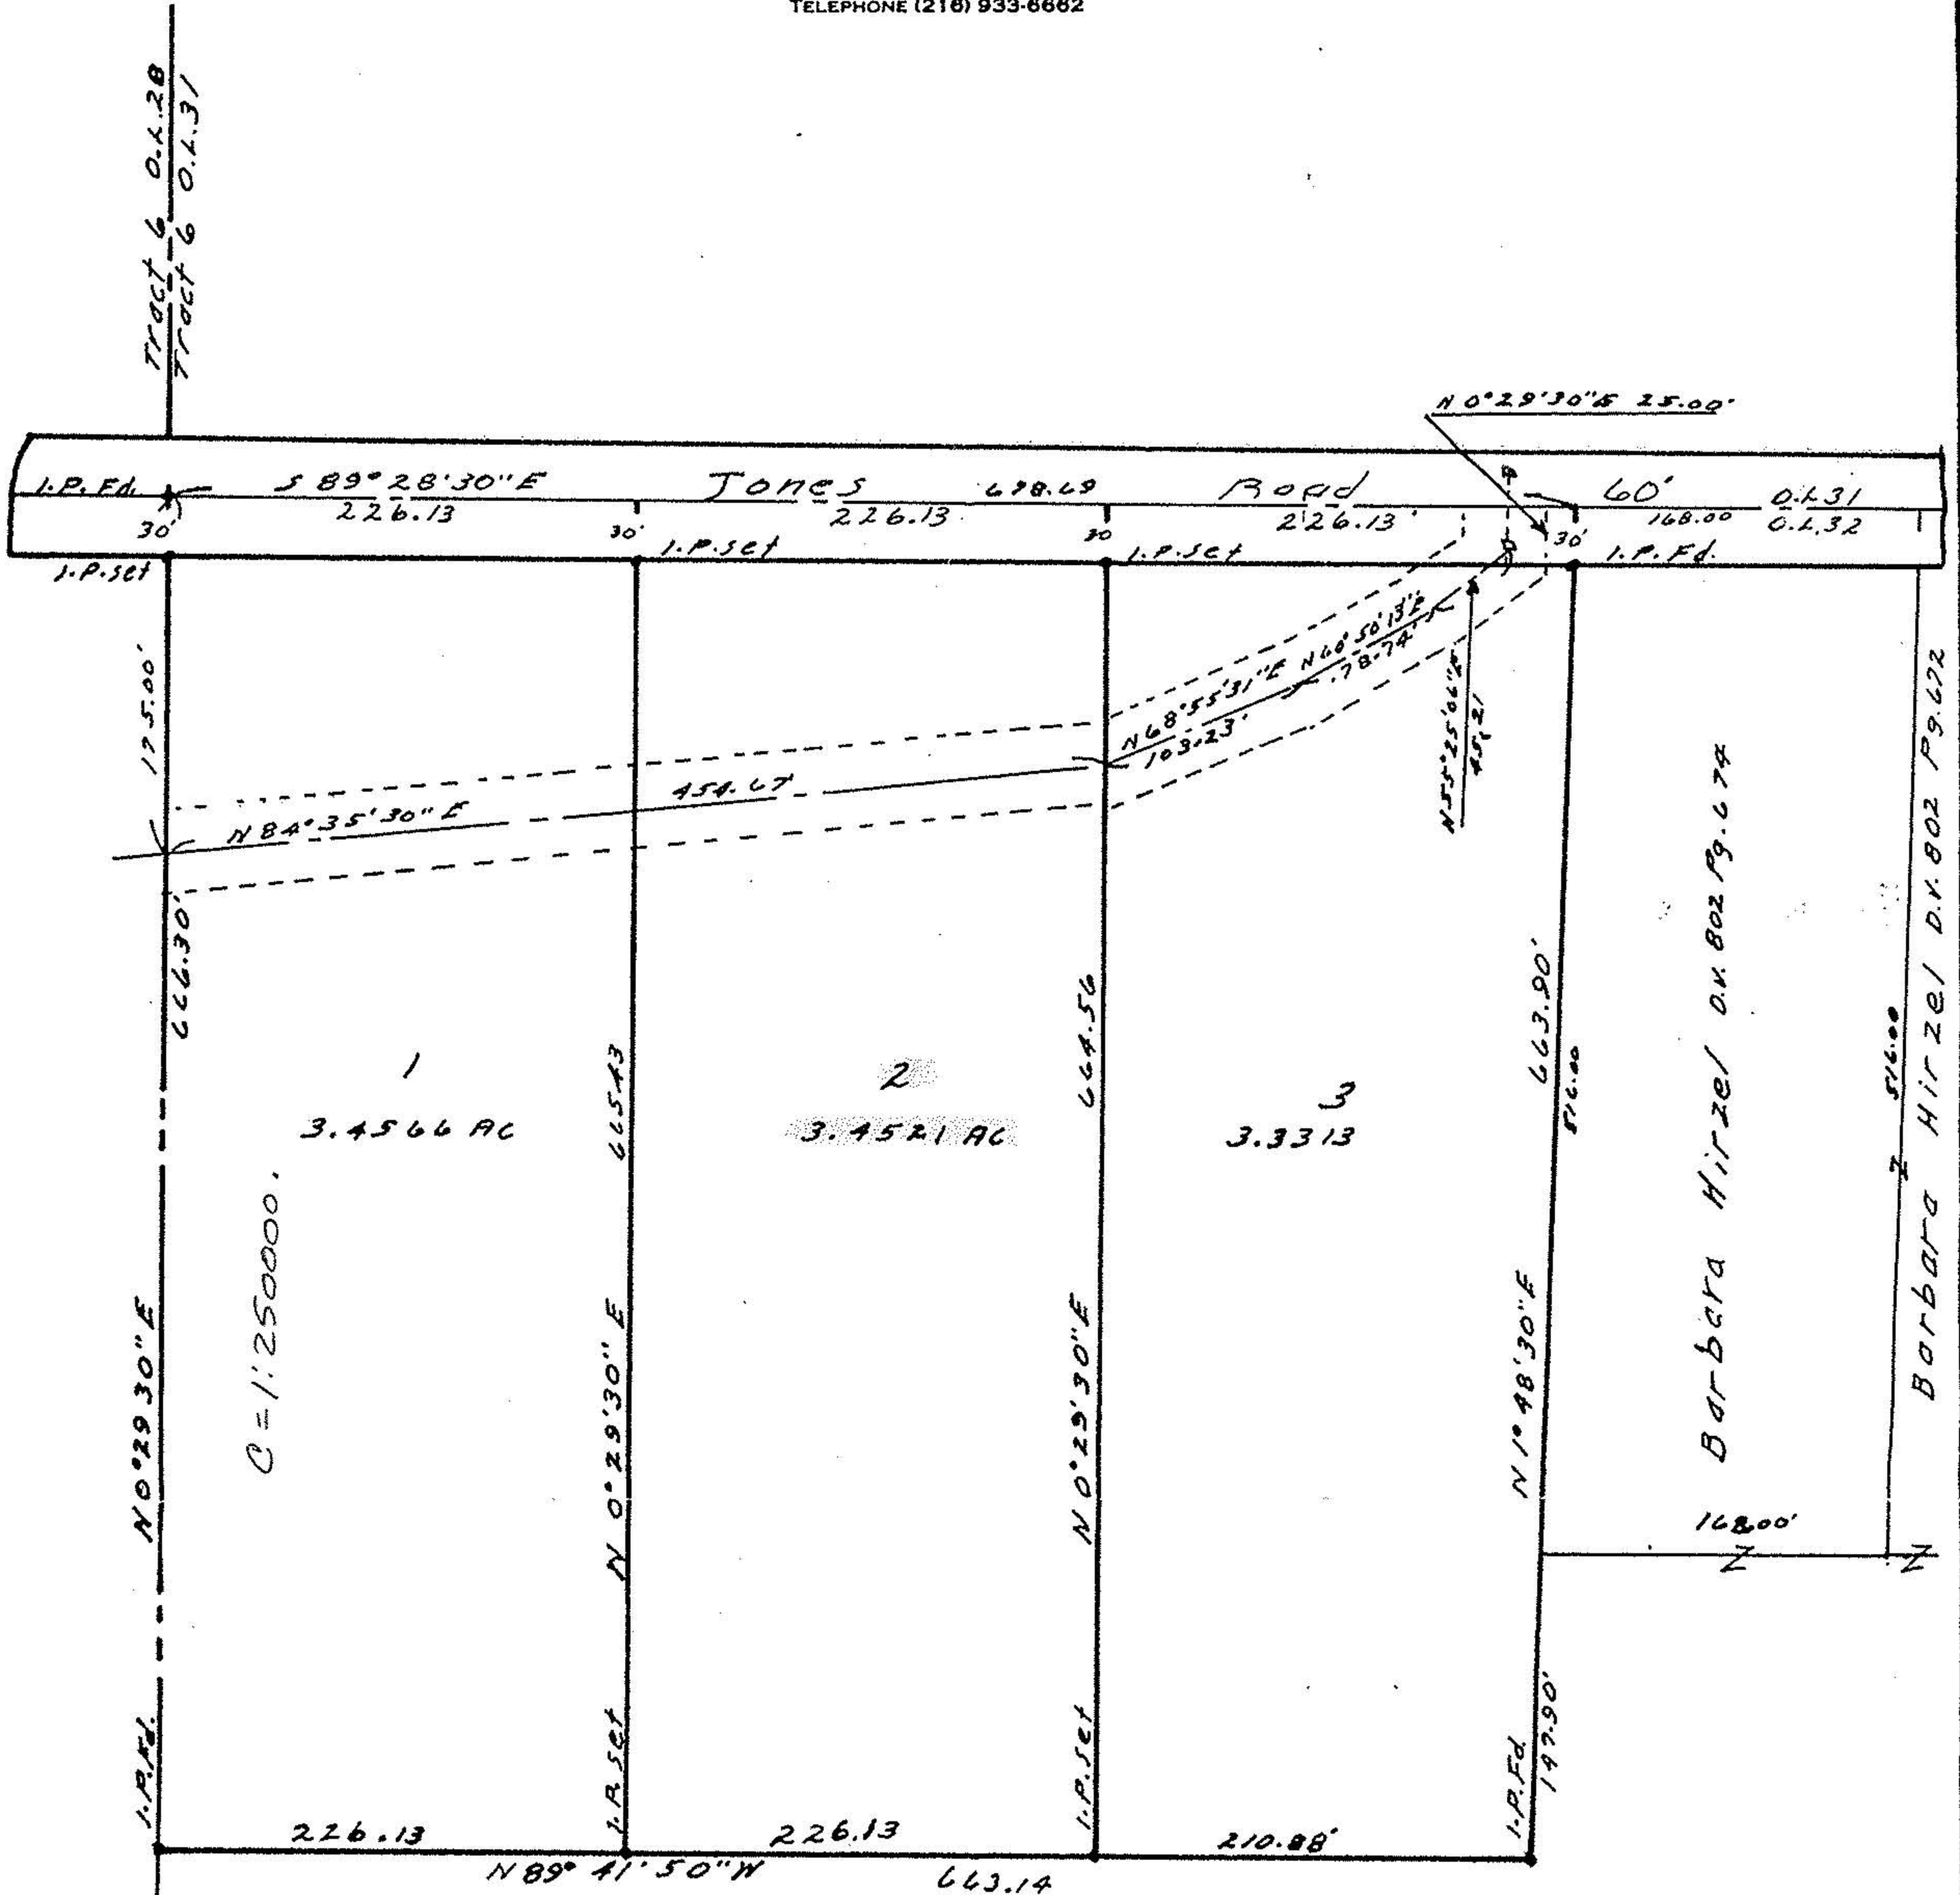

Barbara Hirzel d.v. 804 Pg. 540

#18393

APPROVED
 LORAIN CO.
 MAP DEPT.

DATE 4-20-89

PAGE 17-H

BY CAROL FRANCIS

VOID AFTER # 18393

SURVEY
 of
 Of part of Tract No. 6 Original
 Lot No. 32 Brighton Township
 Lorain County Ohio, Oct. 1986.
 REV. 11-22-86 Scale 1"=100'.



3.22

SURVEYOR
 NO. 4438

#18393