


PLAT OF SURVEY FOR HAROLD WILES
 PART OF ORIGINAL LOT NO. 1, WELLINGTON TWP.
 LORAIN COUNTY STATE OF OHIO

#18247
 12/7/88
 18-H
 T. McMain



LEGEND
 ○ IRON PIN SET
 ● IRON PIN FOUND
 △ RAILROAD SPIKE SET

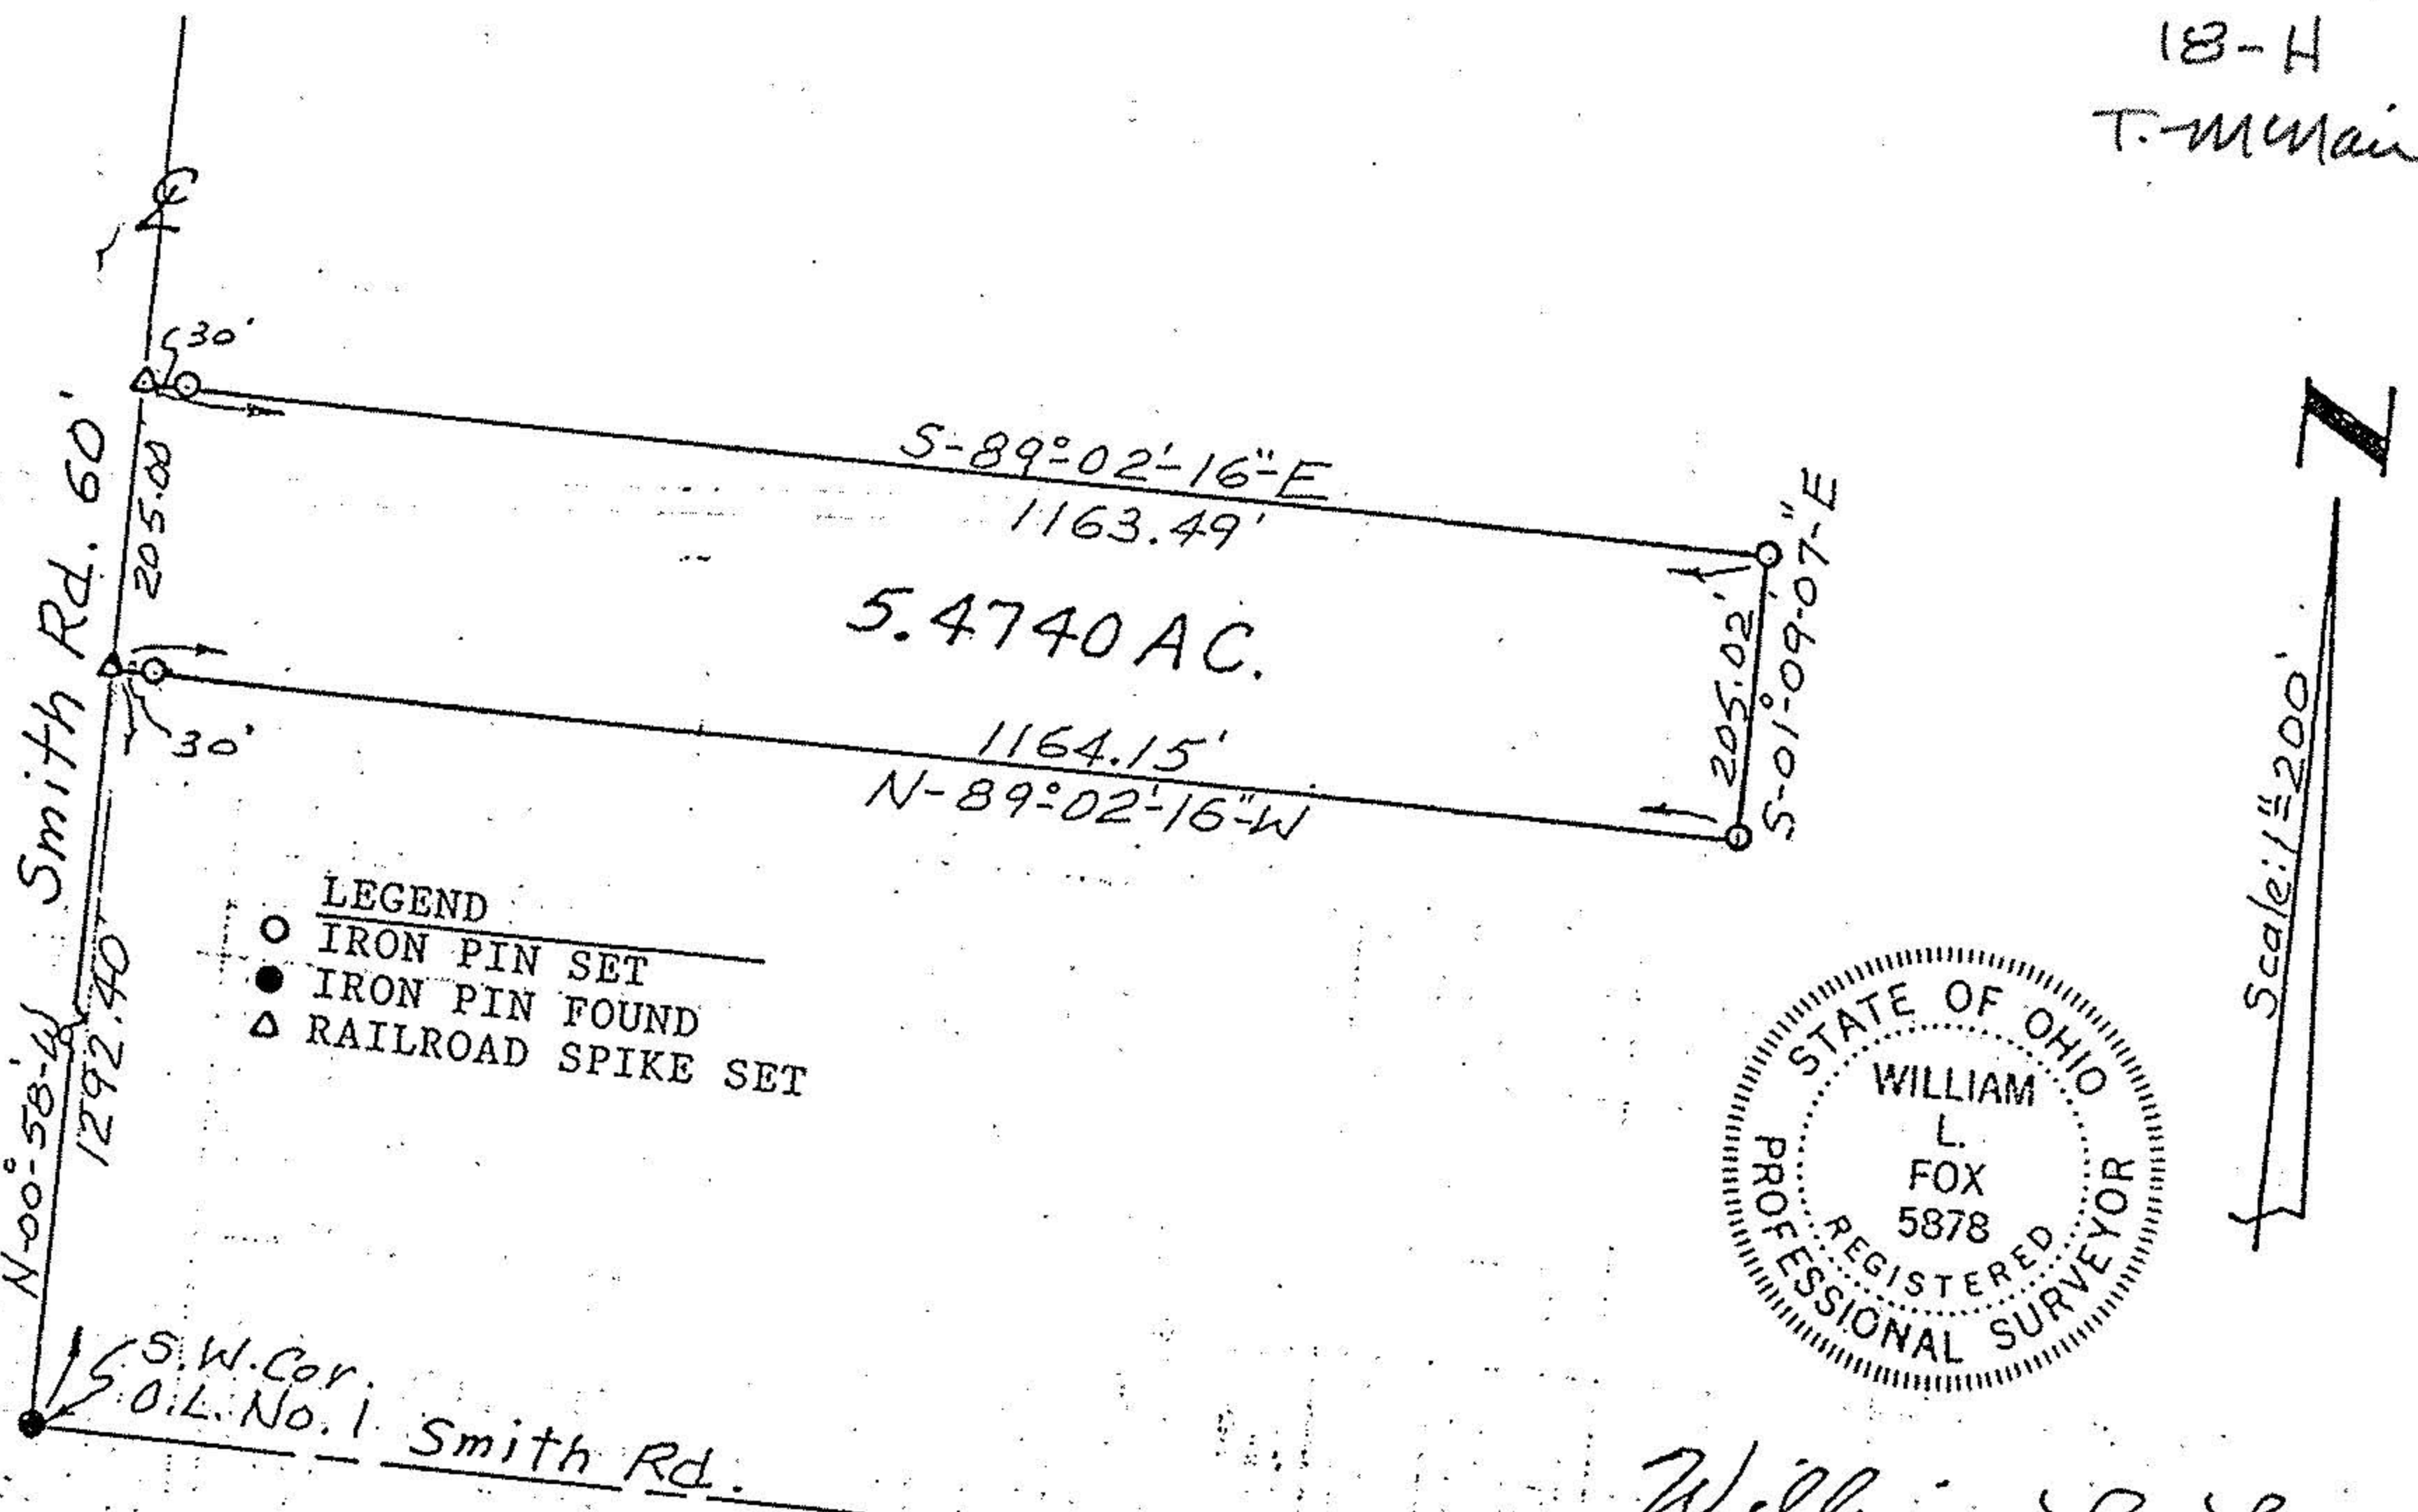


William L. Fox
 William L. Fox, P.S.
 Registered Surveyor No. 5878

FOX SURVEYING
 34 S. Broad St.
 Columbus, Ohio 44805

Job No. 78847 Dec. 5, 1988

PLAT OF SURVEY FOR HAROLD WILES
 PART OF ORIGINAL LOT NO. 1, WELLINGTON TWP.
 LORAIN COUNTY STATE OF OHIO

18-00-001-000

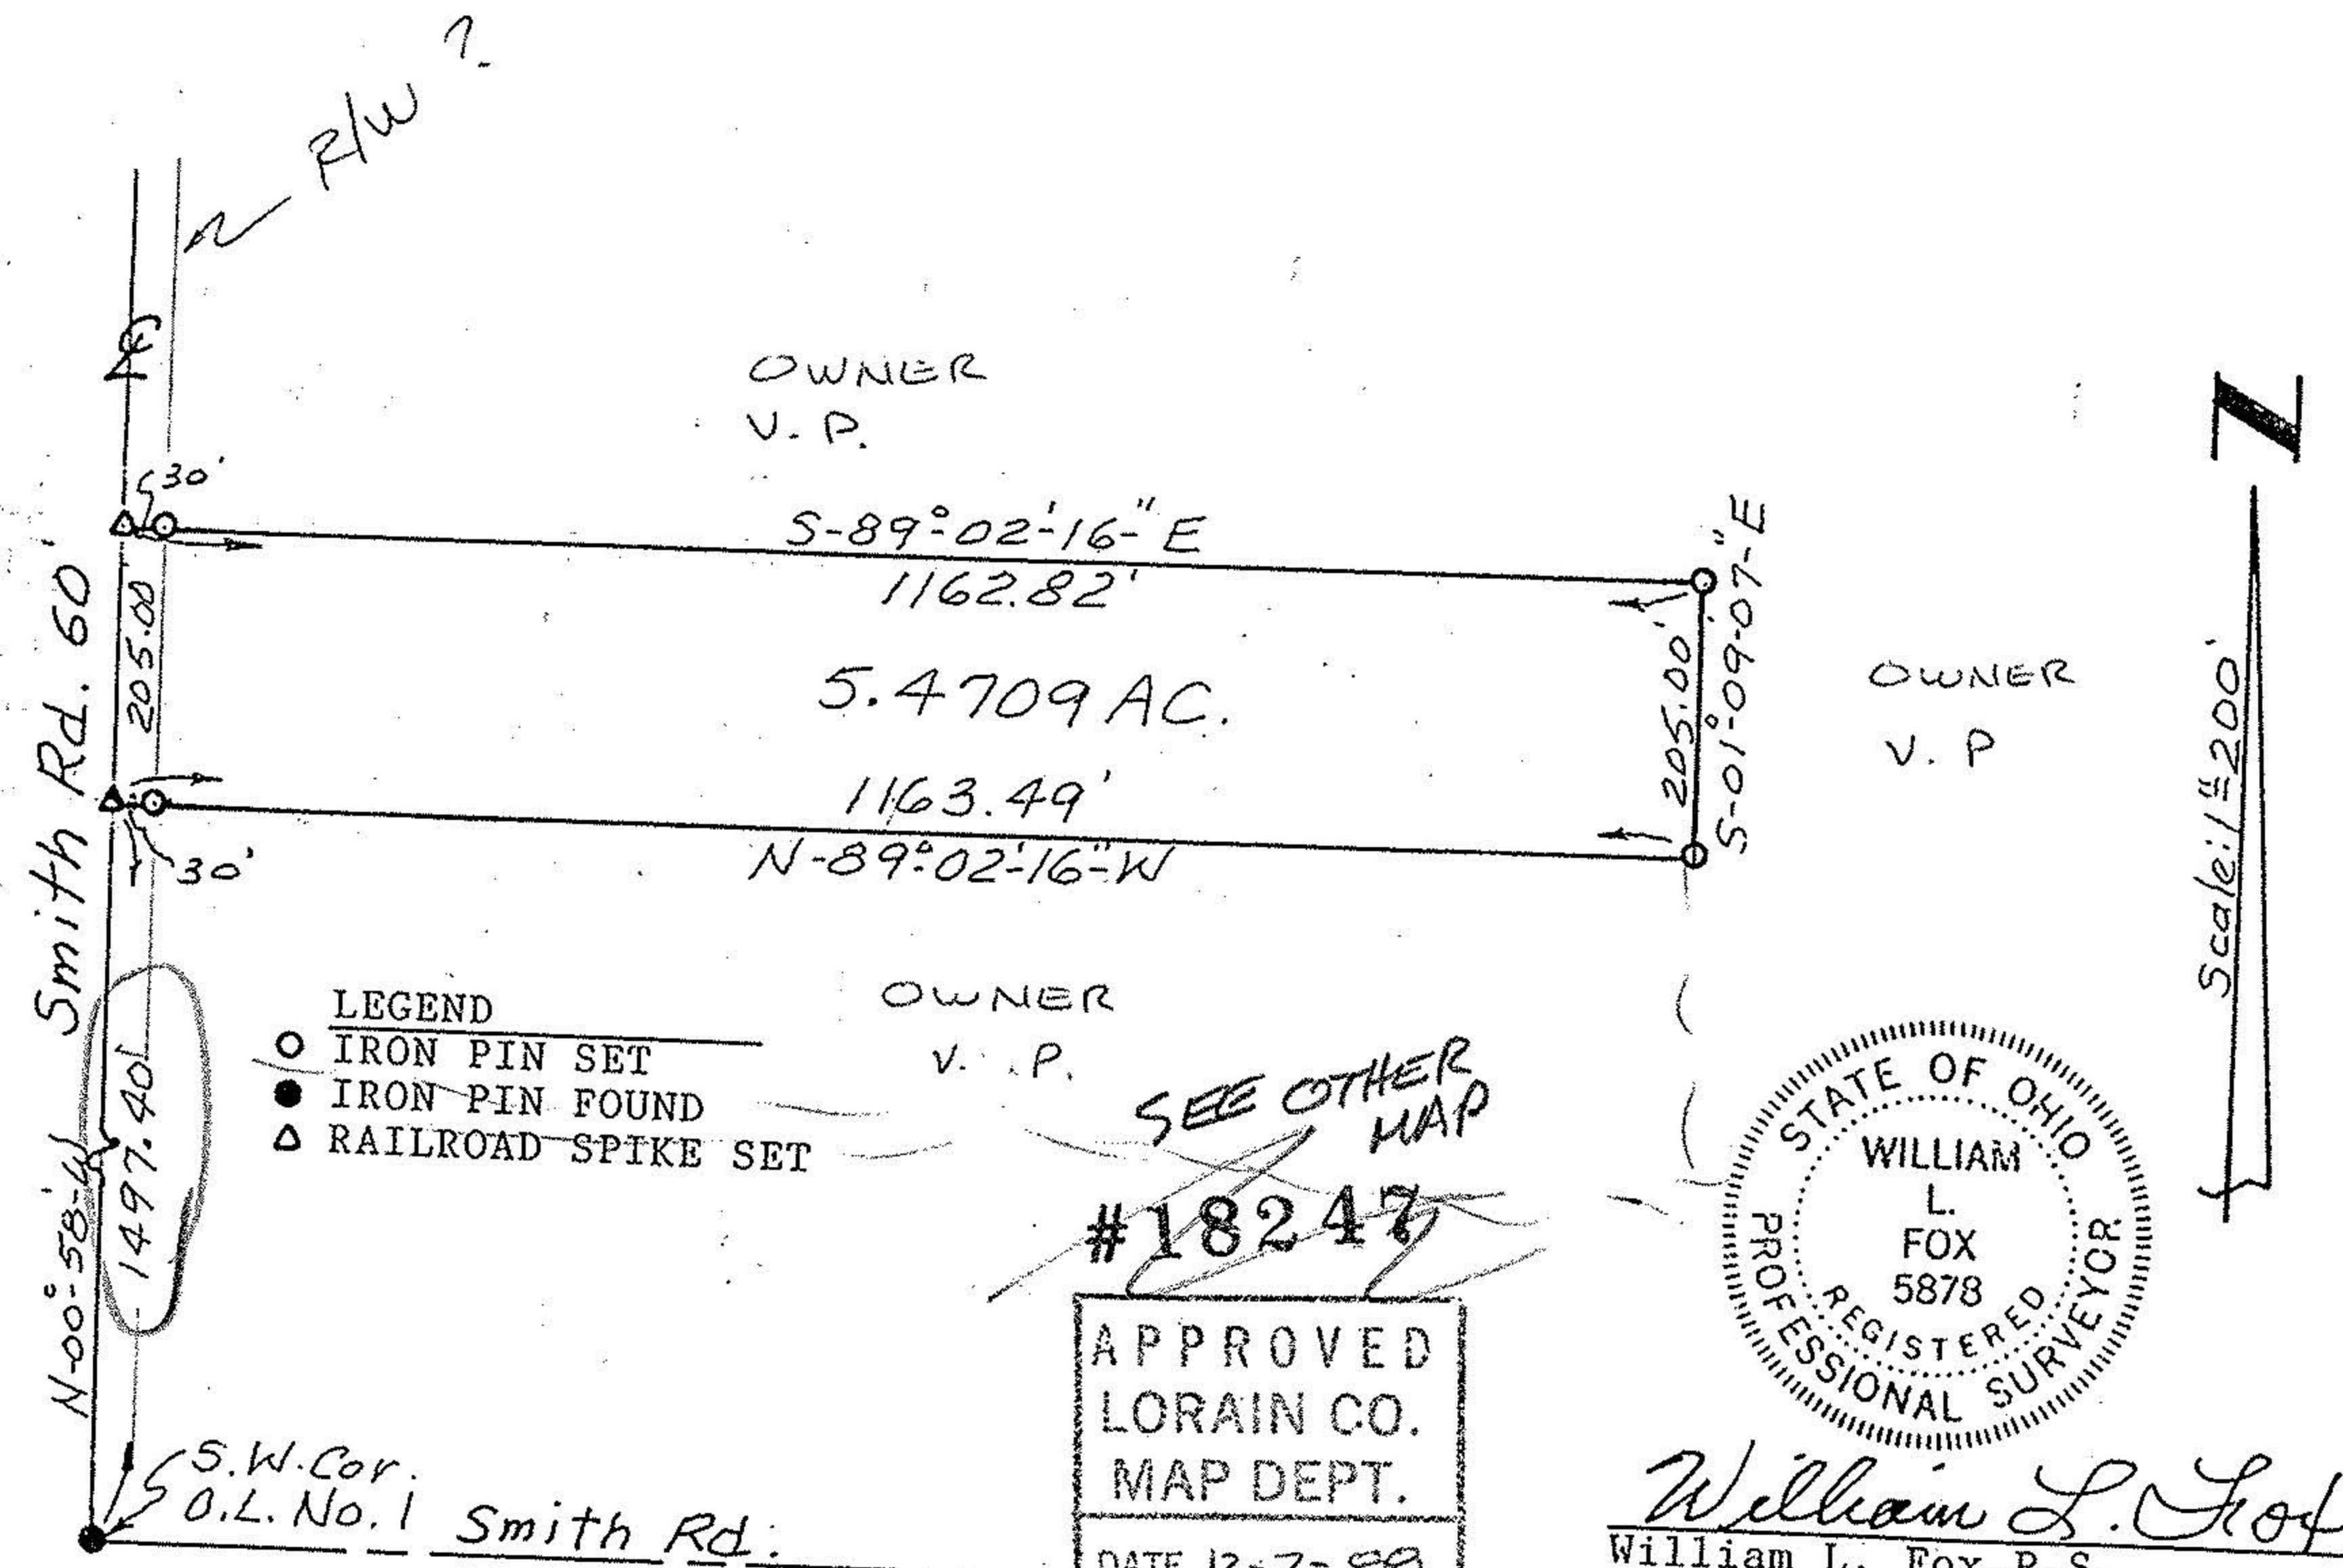

LEGEND
 ○ IRON PIN SET
 ● IRON PIN FOUND
 △ RAILROAD SPIKE SET



William L. Fox
 William L. Fox, P.S.
 Registered Surveyor No. 5878

APPROVED
 LORAIN CO.
 MAP DEPT.
 DATE 12-7-88
 PAGE 18-H
 BY T. McMain
 JOB NO. 18247

Job No. 78847 Dec. 5, 1988

#18247

SEE OTHER MAP

OWNER
 V. P.

OWNER
 V. P.

OWNER
 V. P.

S.W. Cor.
 O.L. No. 1 Smith Rd.

Smith Rd. 60'
 1497.40'

Smith Rd. 60'
 205.00'

30'

30'

S-89°-02'-16" E
 1162.82'

5.4709 AC.

1163.49'

N-89°-02'-16" W

S-01°-09'-07" E
 205.00'

30'

30'

Scale: 1" = 200'



Scale: 1" = 200'



18-H

18-H

#18247