


18-D

#18802

18-00-006-000

CARDINAL SURVEYS
 PLAT OF SURVEY
 PREPARED FOR MR. DICK COLLINS
 PART OF ORIGINAL WELLINGTON TOWNSHIP LOT NO. 6
 Vol. 1036 Pg. 967
 1136.28'

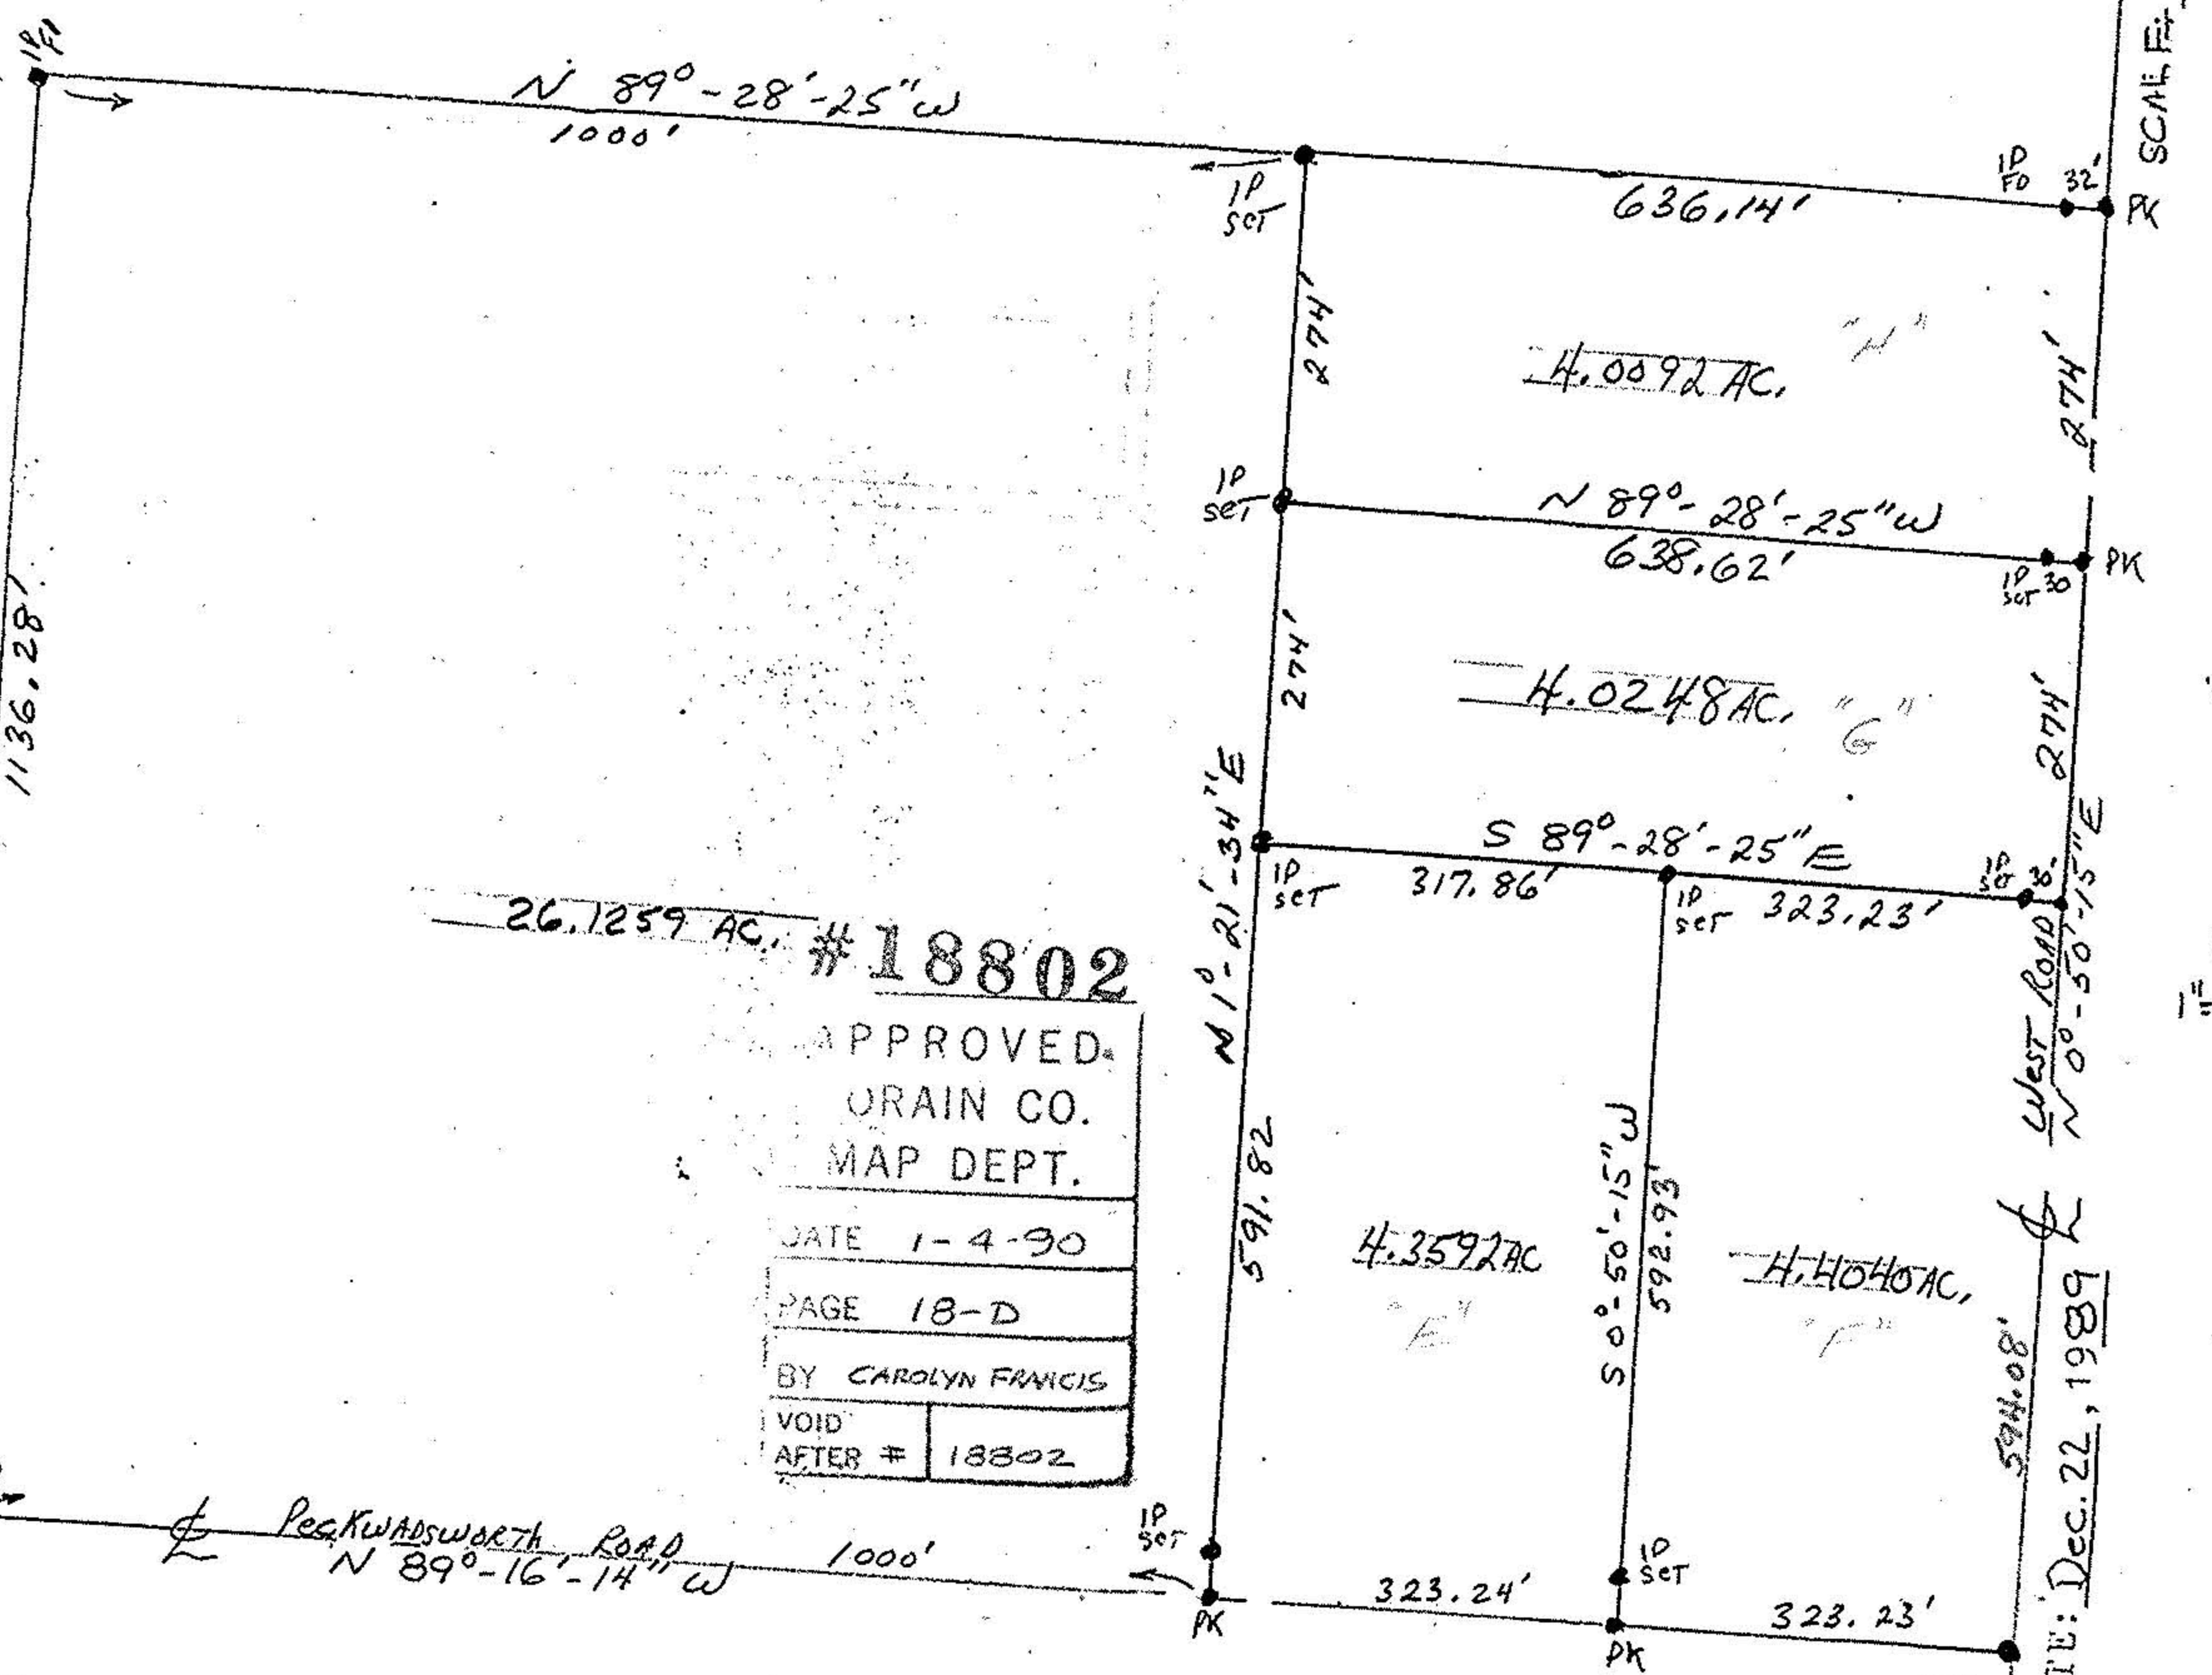

26.1259 AC. #18802

APPROVED
 GRAIN CO.
 MAP DEPT.
 DATE 1-4-90
 PAGE 18-D
 BY CAROLYN FRANCIS
 VOID AFTER # 18802

DATE: Dec. 22, 1989

SCALE 1" = 200'

1" = 200'