

PLAT OF SURVEY



STATE OF OHIO
COUNTY OF Lorain

PROJECT # 76010
DATE Jan 1976

TOWNSHIP, VILLAGE, CITY - Wellington LOT 17 TRACT _____
SUBDIVISION _____ SUBLOT # _____

PROPERTY OWNER Tewksbury

18-00-017-000

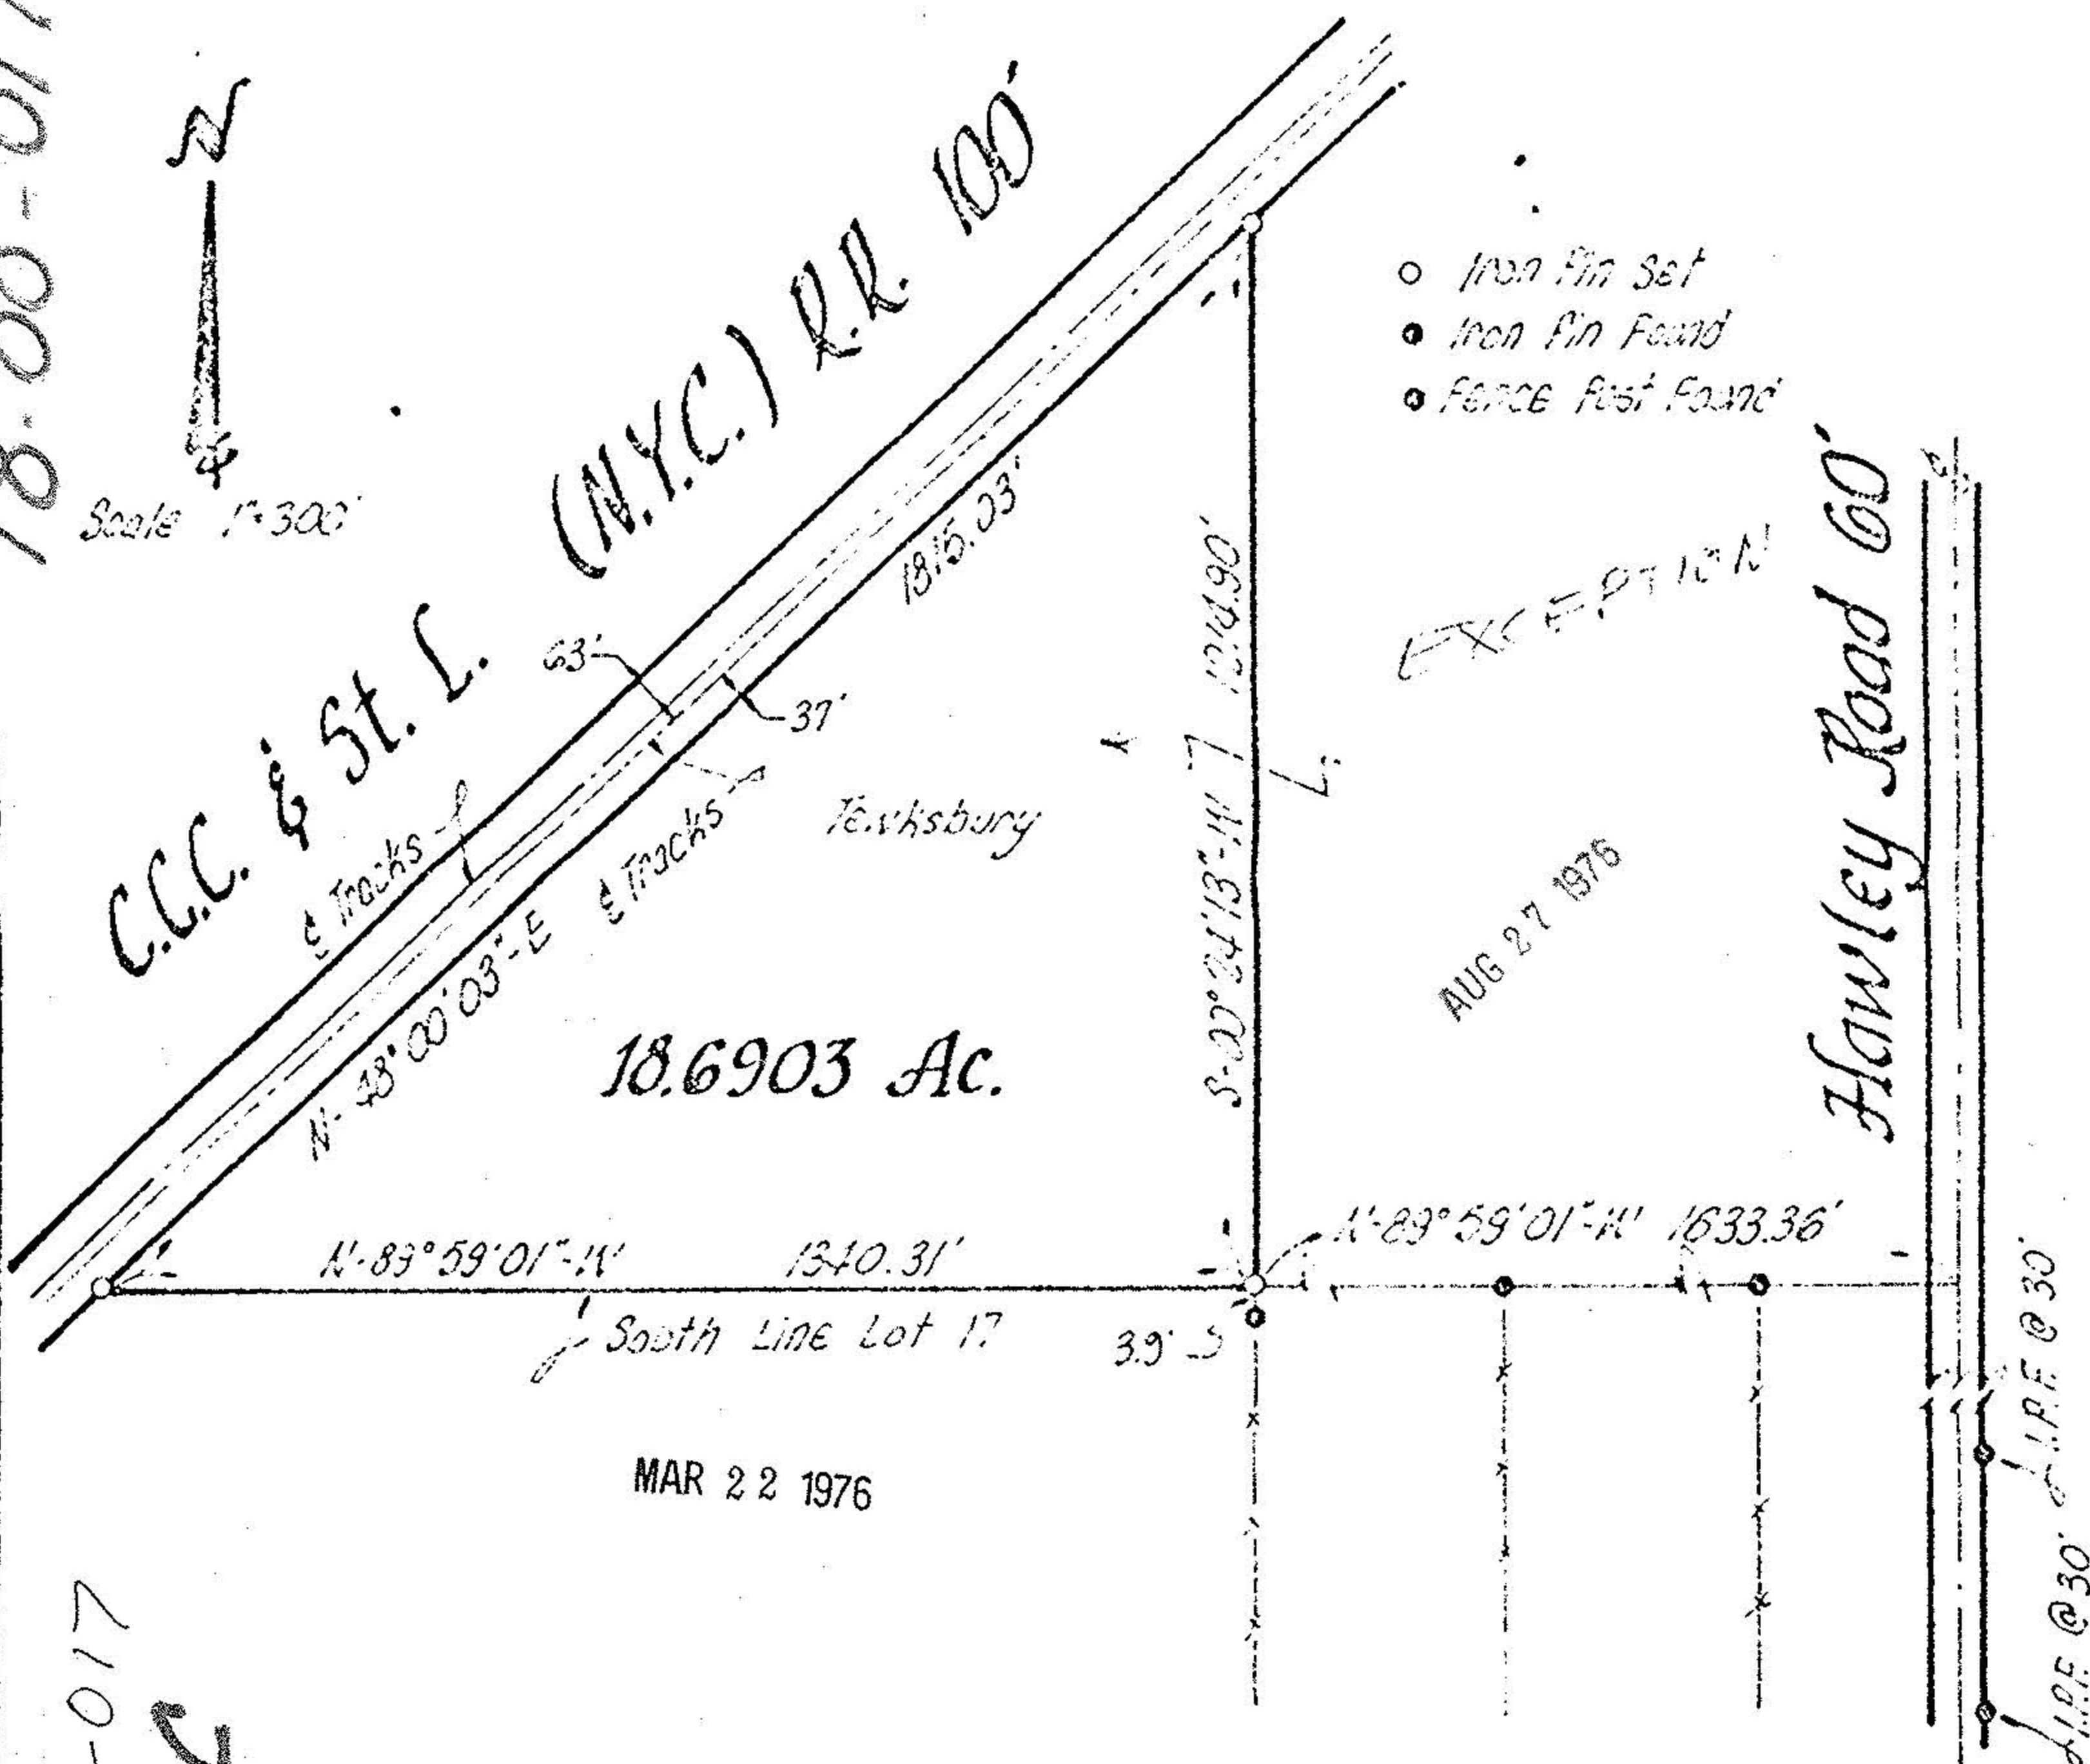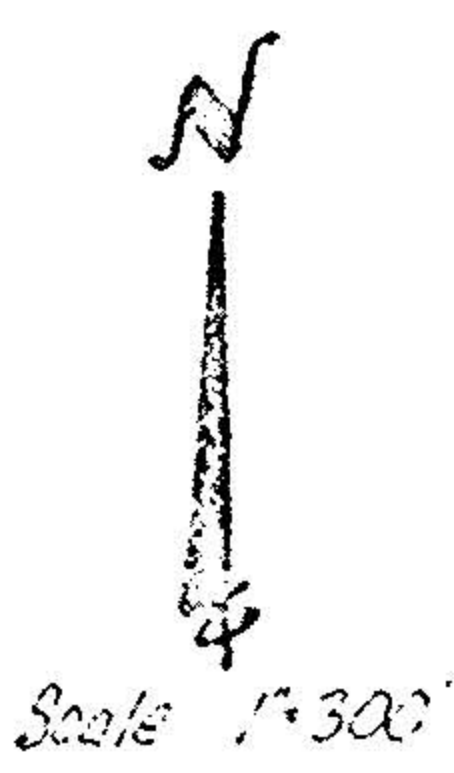

- Iron Pin Set
- Iron Pin Found
- Fence Post Found

EXCEPTION

AUG 27 1976

18.6903 Ac.

South Line Lot 17

MAR 22 1976

18-00-017
18-C

SANTEI ASSOCIATES
ENGINEERS SURVEYORS

[Signature]
David W. Santei, Jr.
P.E. Surveyor #236