


SCALE: 1" = 100'
11-21-00

PECK WADSWORTH RD. 60'

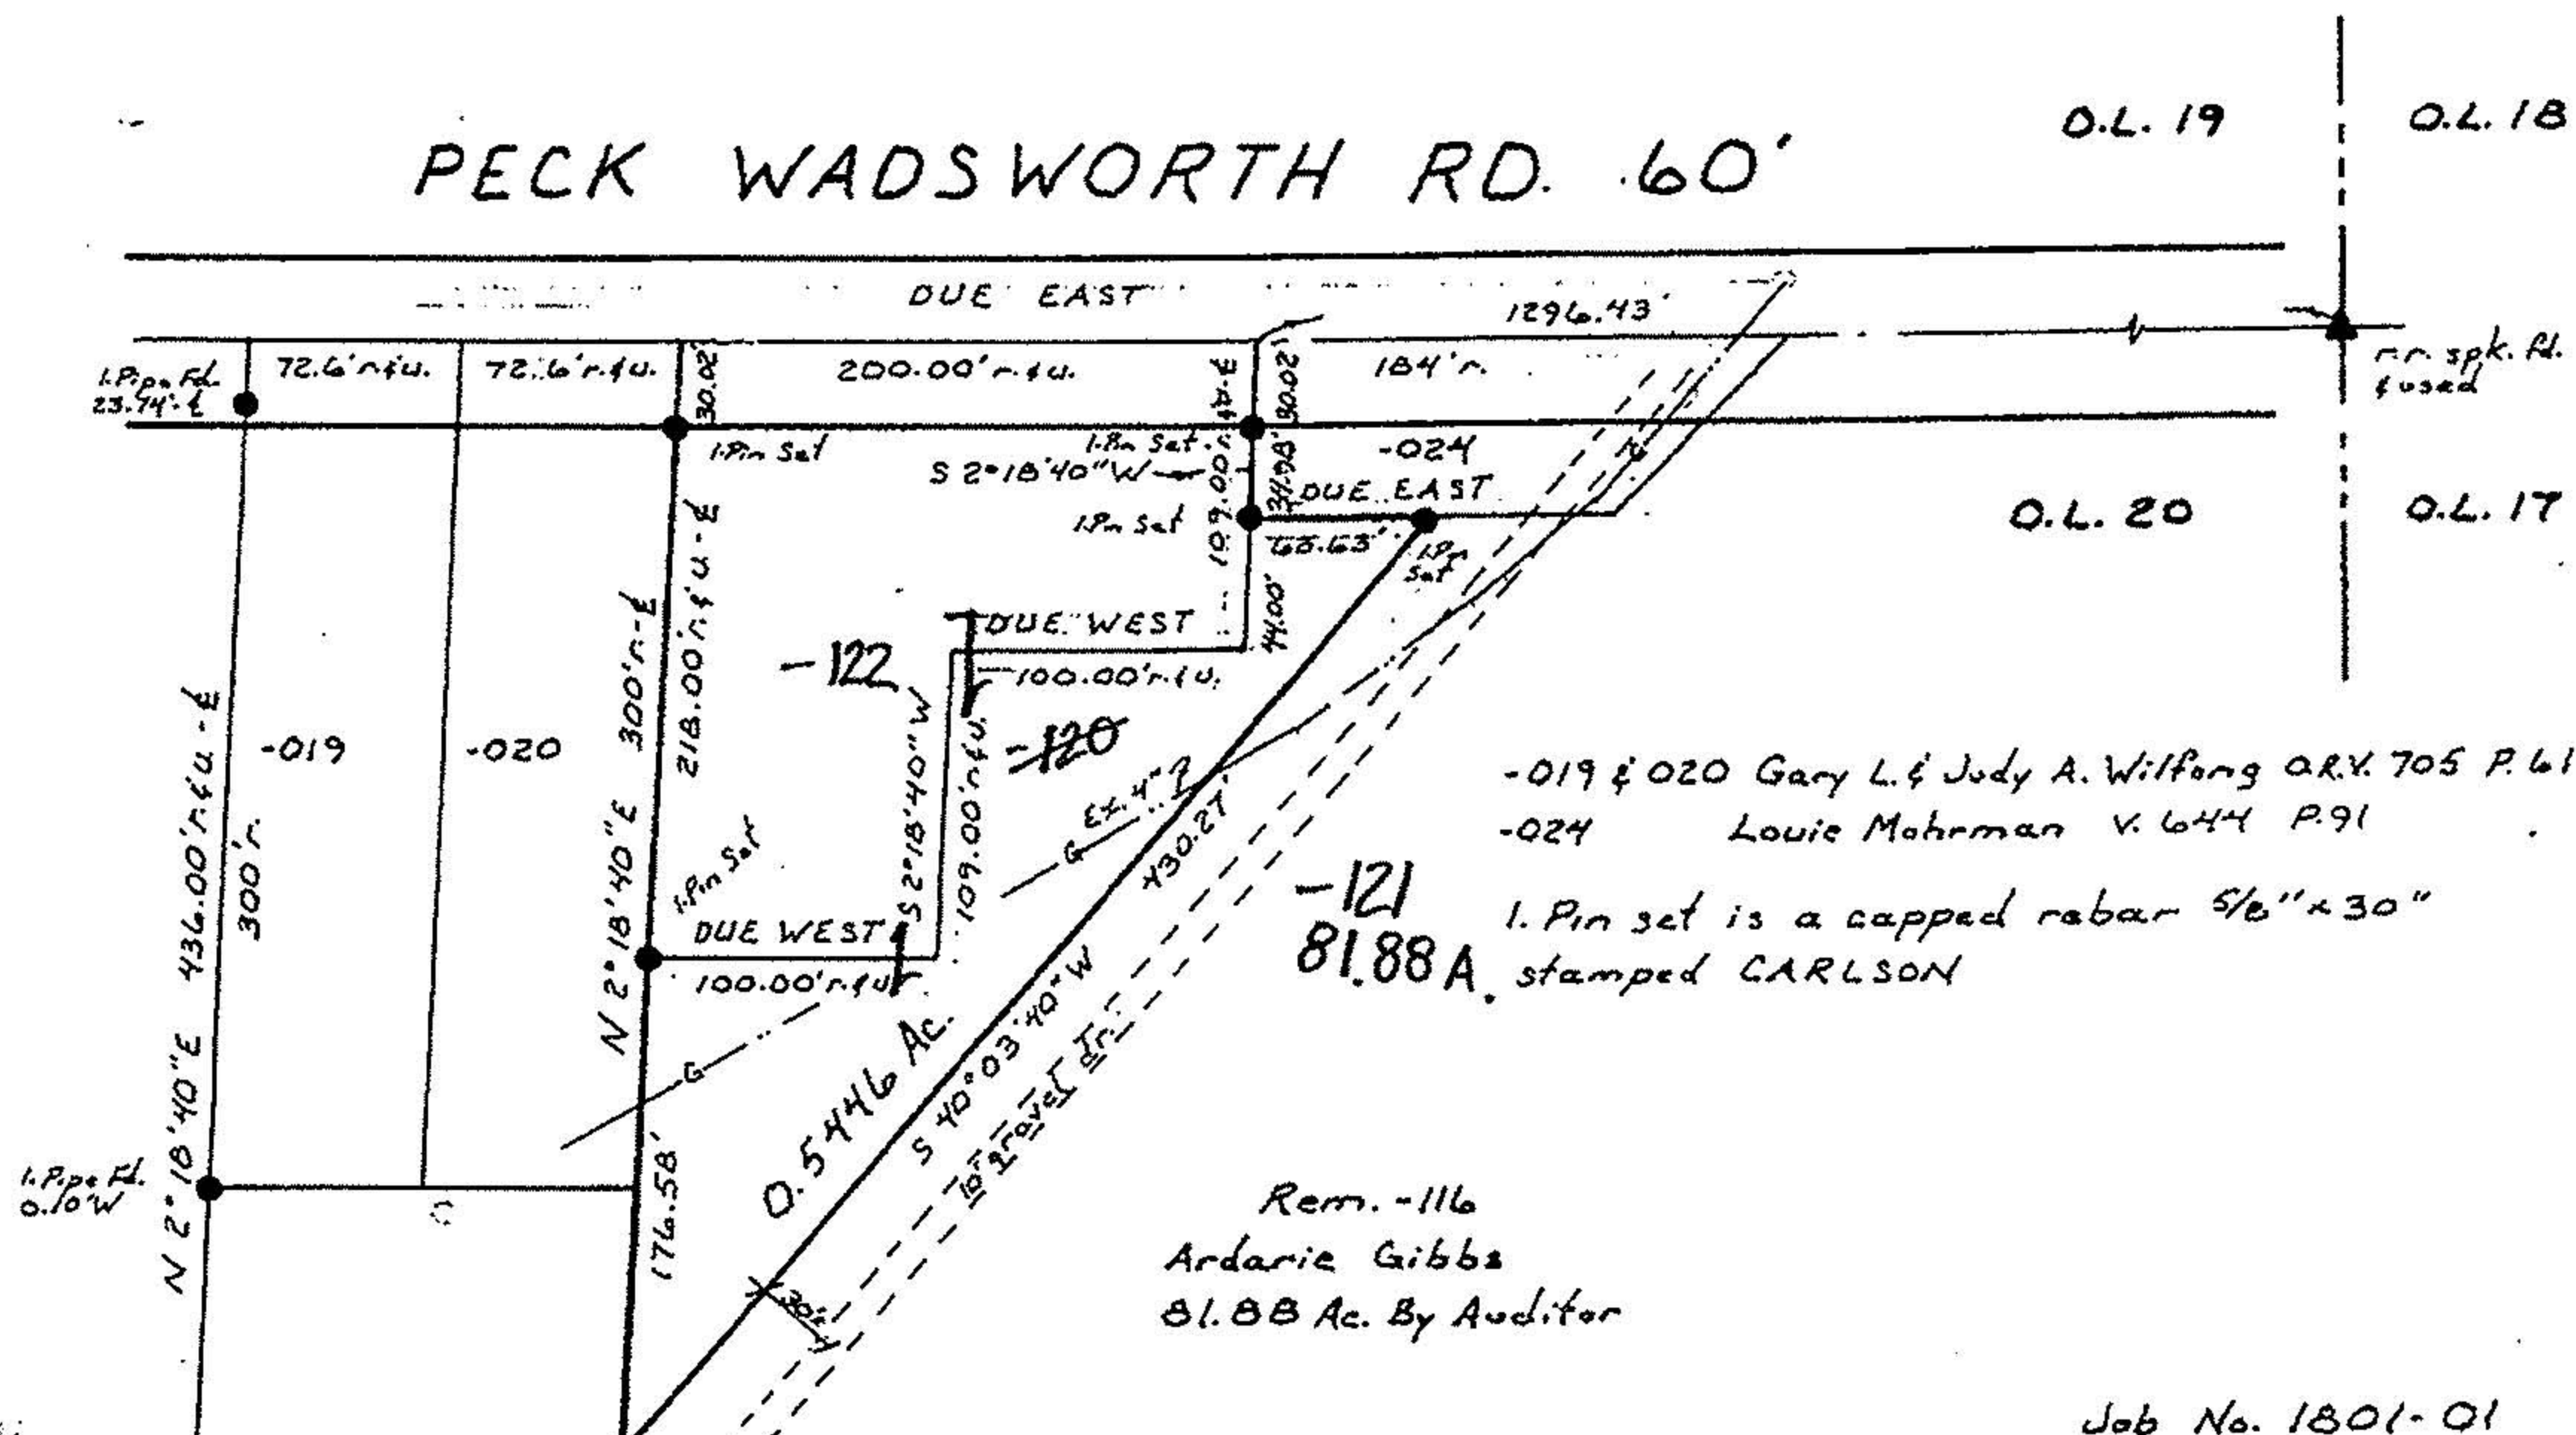

-019 & 020 Gary L. & Judy A. Wilfong O.R.V. 705 P. 61
-024 Louie Mohrman V. 644 P. 91

-121
81.88 A. 1. Pin set is a capped rebar 5/8" x 30" stamped CARLSON

Rem. -116
Ardairie Gibbs
81.88 Ac. By Auditor

Job No. 1801-01

SURVEY FOR


EVERETT & DAWN METZ

WELLINGTON TWP.
COUNTY OF LORAIN

O.L. 20
STATE OF OHIO

BY

CARLSON SURVEYS
440-926-0200

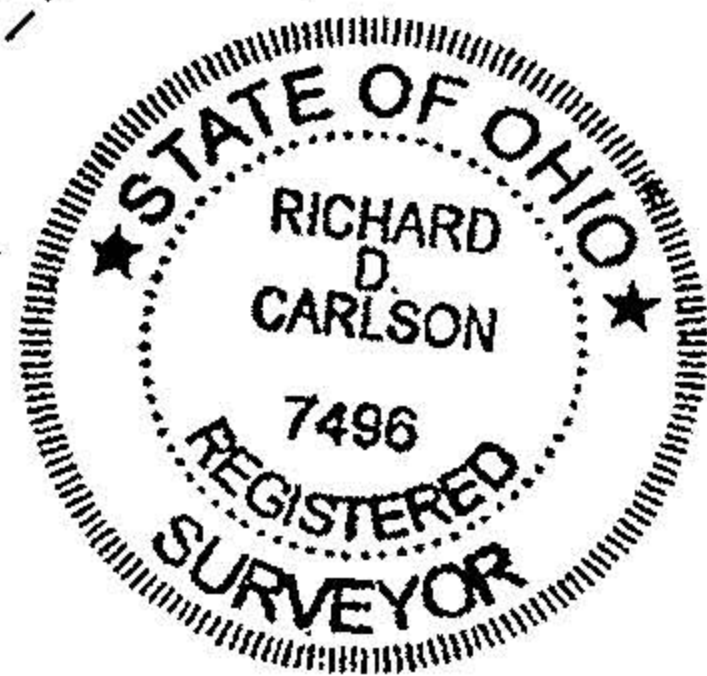

00867

APPROVED
LORAIN CO.
MAP DEPT

DATE 9-17-01

PAGE 18-00-020-A

BY JHATFIELD

01-00867