

R/W ADAMS ST.

18-00-021-C

PLAT OF SURVEY
VILLAGE OF WELLINGTON

18-00-021-103

AS SURVEYED BY NEFF & ASSOC. INC. REG. SURVEYORS

BLOCK NO. 3

159.23' REC.

I.P. FND.

S-0°05'-W

206.90' OBS.
210.37' REC.

(8)

132.00 REC.

N-89°25'-E
103.60' OBS.
103.25' REC.

(5)

AUG 13 1974

1033

(7)

103.25' REC.
103.30' OBS.

N-89°58'-E

HAMILTON ST. 66'

I.P. FND.

68'±


I.P.

210.37' REC.
205.91' OBS.

DUE NORTH I.P.

I.P. FND.

237.60' REC.
LOT 5
LOT 4

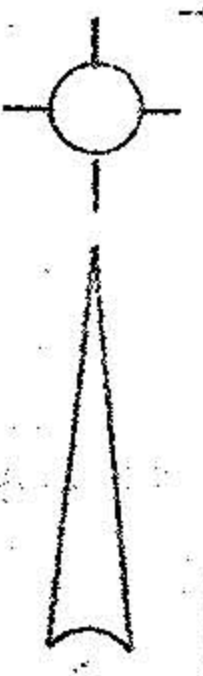

(9)

ROY MANNING
VOL. 272 PG. 71 OCT. 1, 1934

563.50'

DUE NORTH MAIN ST. 66'

#6908

JOB No. 517
MAY 23, 1974
SCALE: 1" = 30 FT.