



# KLEINOEDER-SCHMIDT

and ASSOCIATES

ENGINEERS — SURVEYORS — CONSULTANTS IN LAND PLANNING

ELYRIA - NORWALK - MEDINA

OHIO

## SURVEY

ALL OF S/L 34  
Sublot(s) S'LY 34' OF S/L 33

Subd'n A.A. WITBECKS ADDN.  
P.V. 3 P. 23

Township WELLINGTON

Tract \_\_\_\_\_

Orig. Lot(s) 21

Sec. \_\_\_\_\_

County of LOZAIN


State of Ohio

Corporation WELLINGTON VILLAGE

#17621 18-00-021-106

BARKEZ ST.

(NORTH & SOUTH ASSUMED)

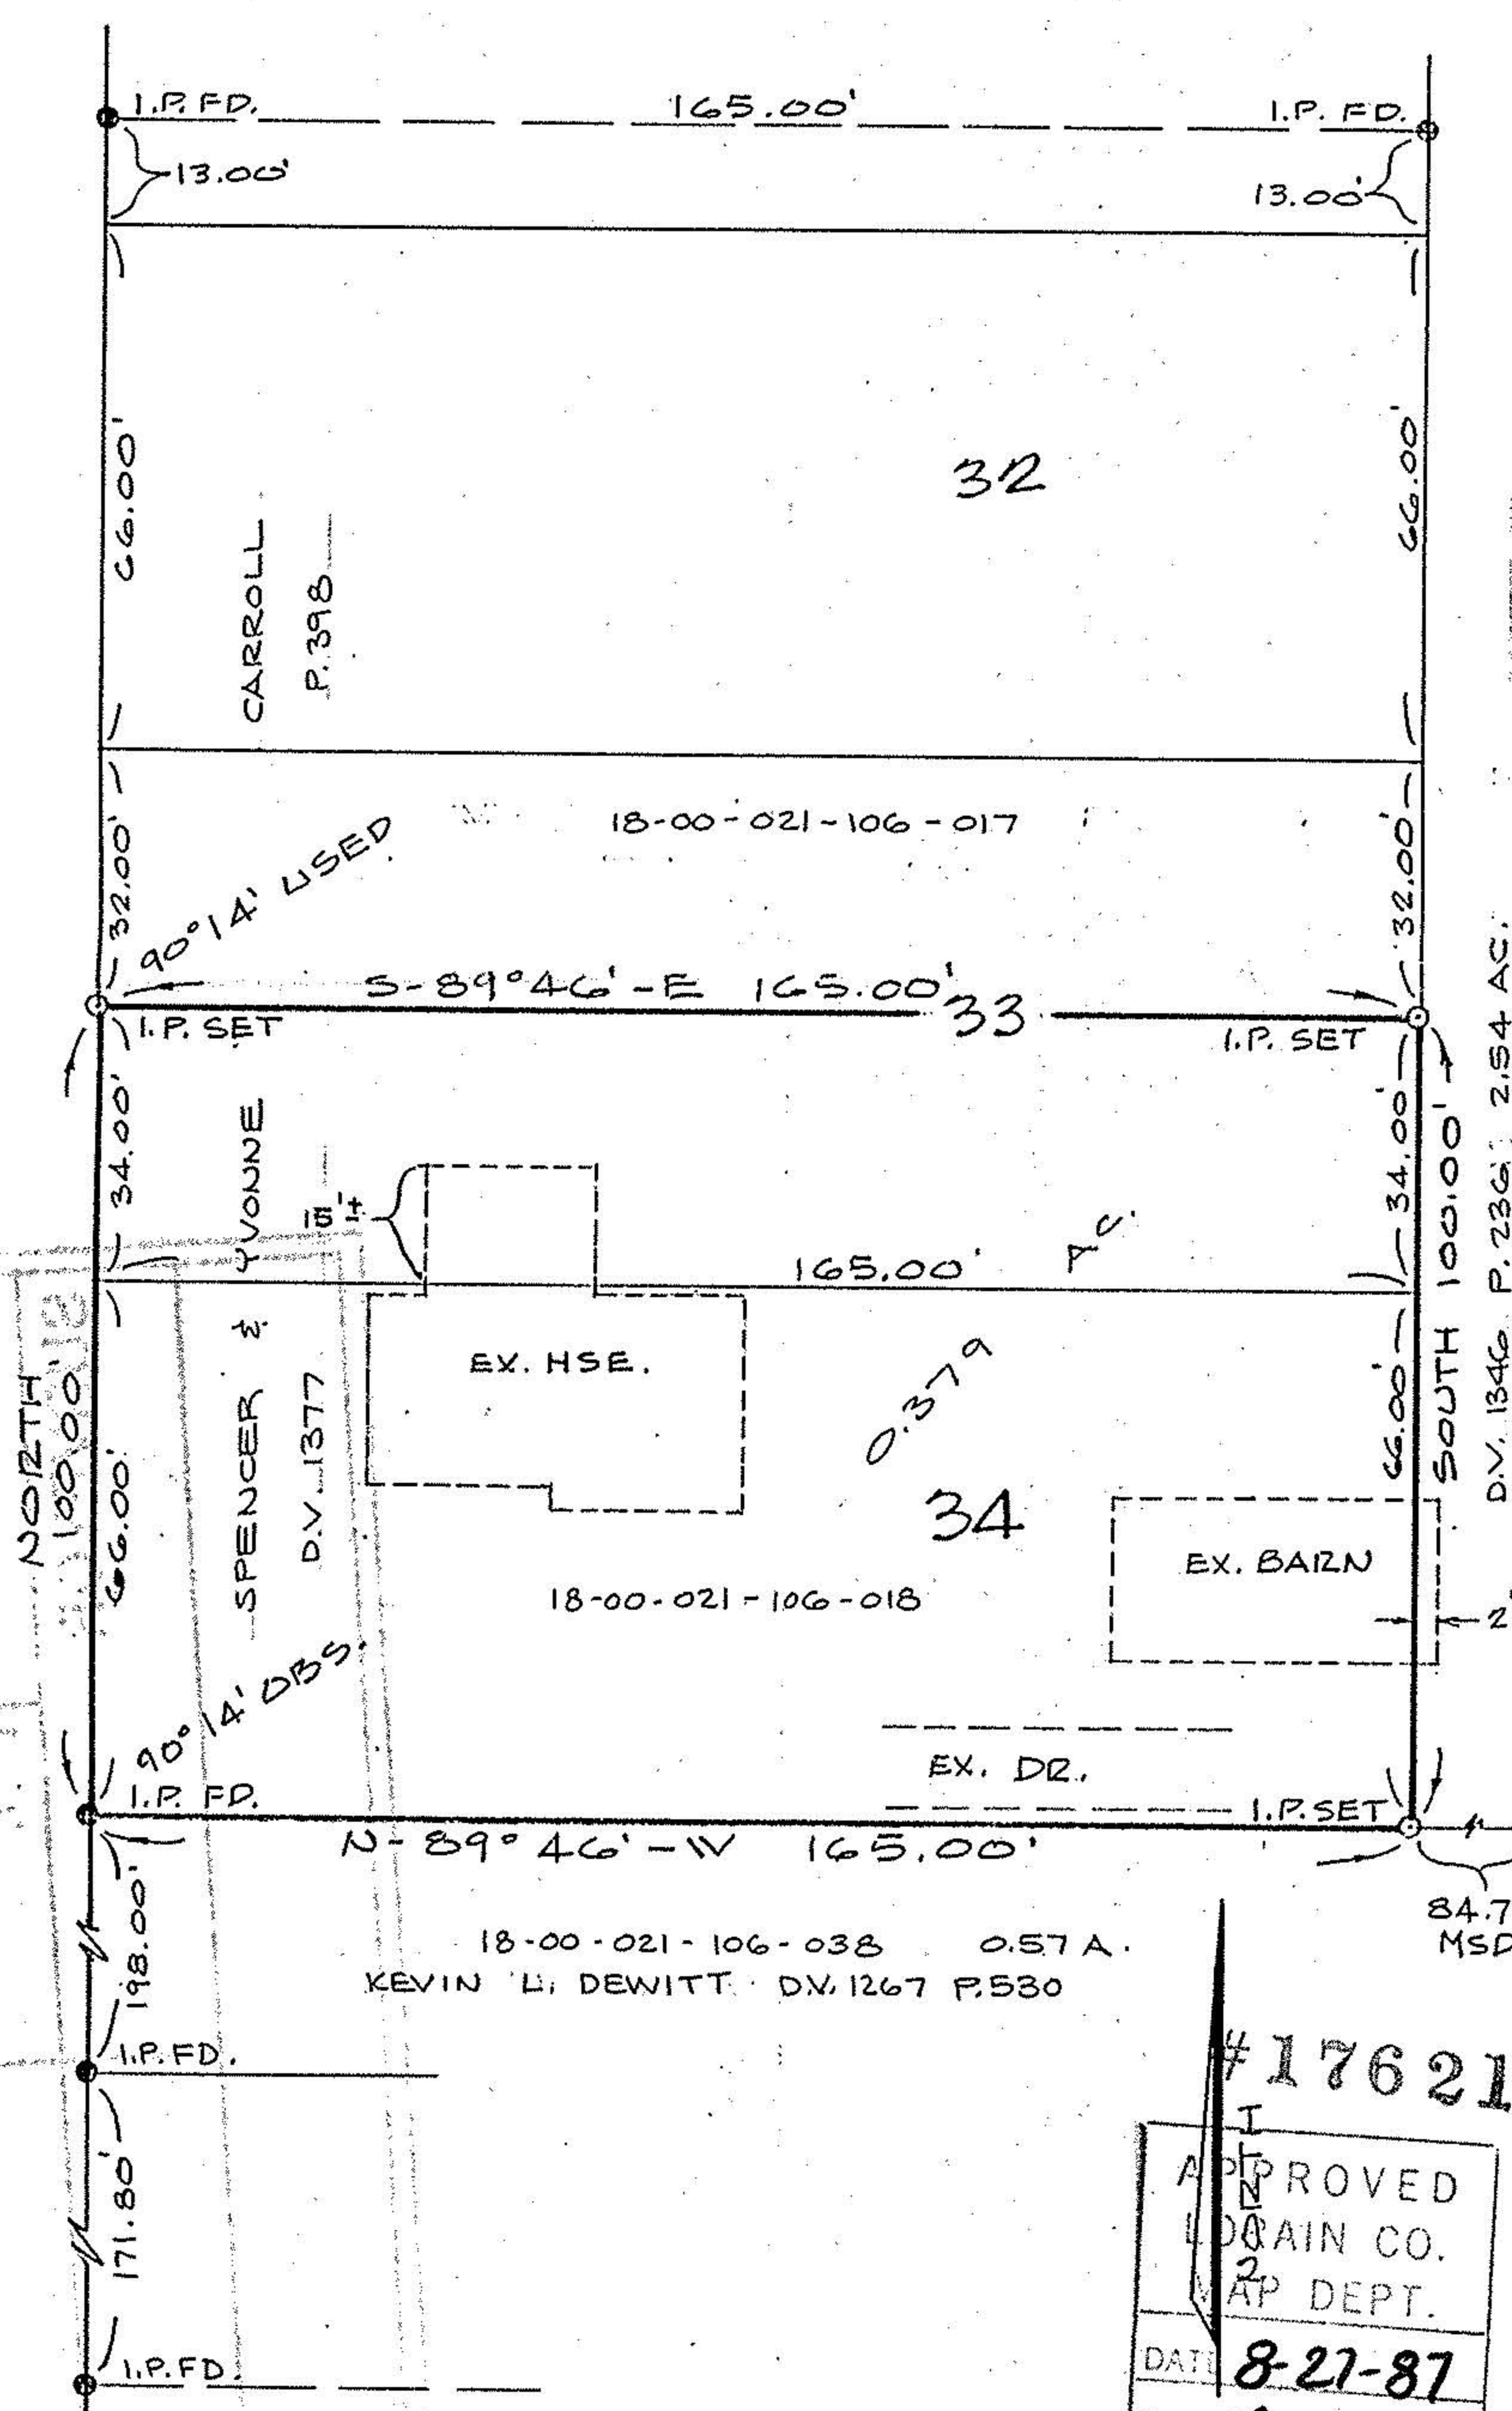

D.V. 1346 P. 236 2.54 AC.  
JACK C. & PATRICIA SUMPTER

84.7  
MSD.

#17621

APPROVED
LOZAIN CO.
MAP DEPT.
DATE 8-27-87
PAGE 18-00-021-A
BY C. FRANCIS
VOID AFTER 17621

Prepared for: LCTC