


GEORGE C. AND ALICE THIERET
PART OF LOT 53, WADSWORTH, TRIPP AND DEWOLF ADD.
VILLAGE OF WELLINGTON, LORAIN COUNTY, OHIO


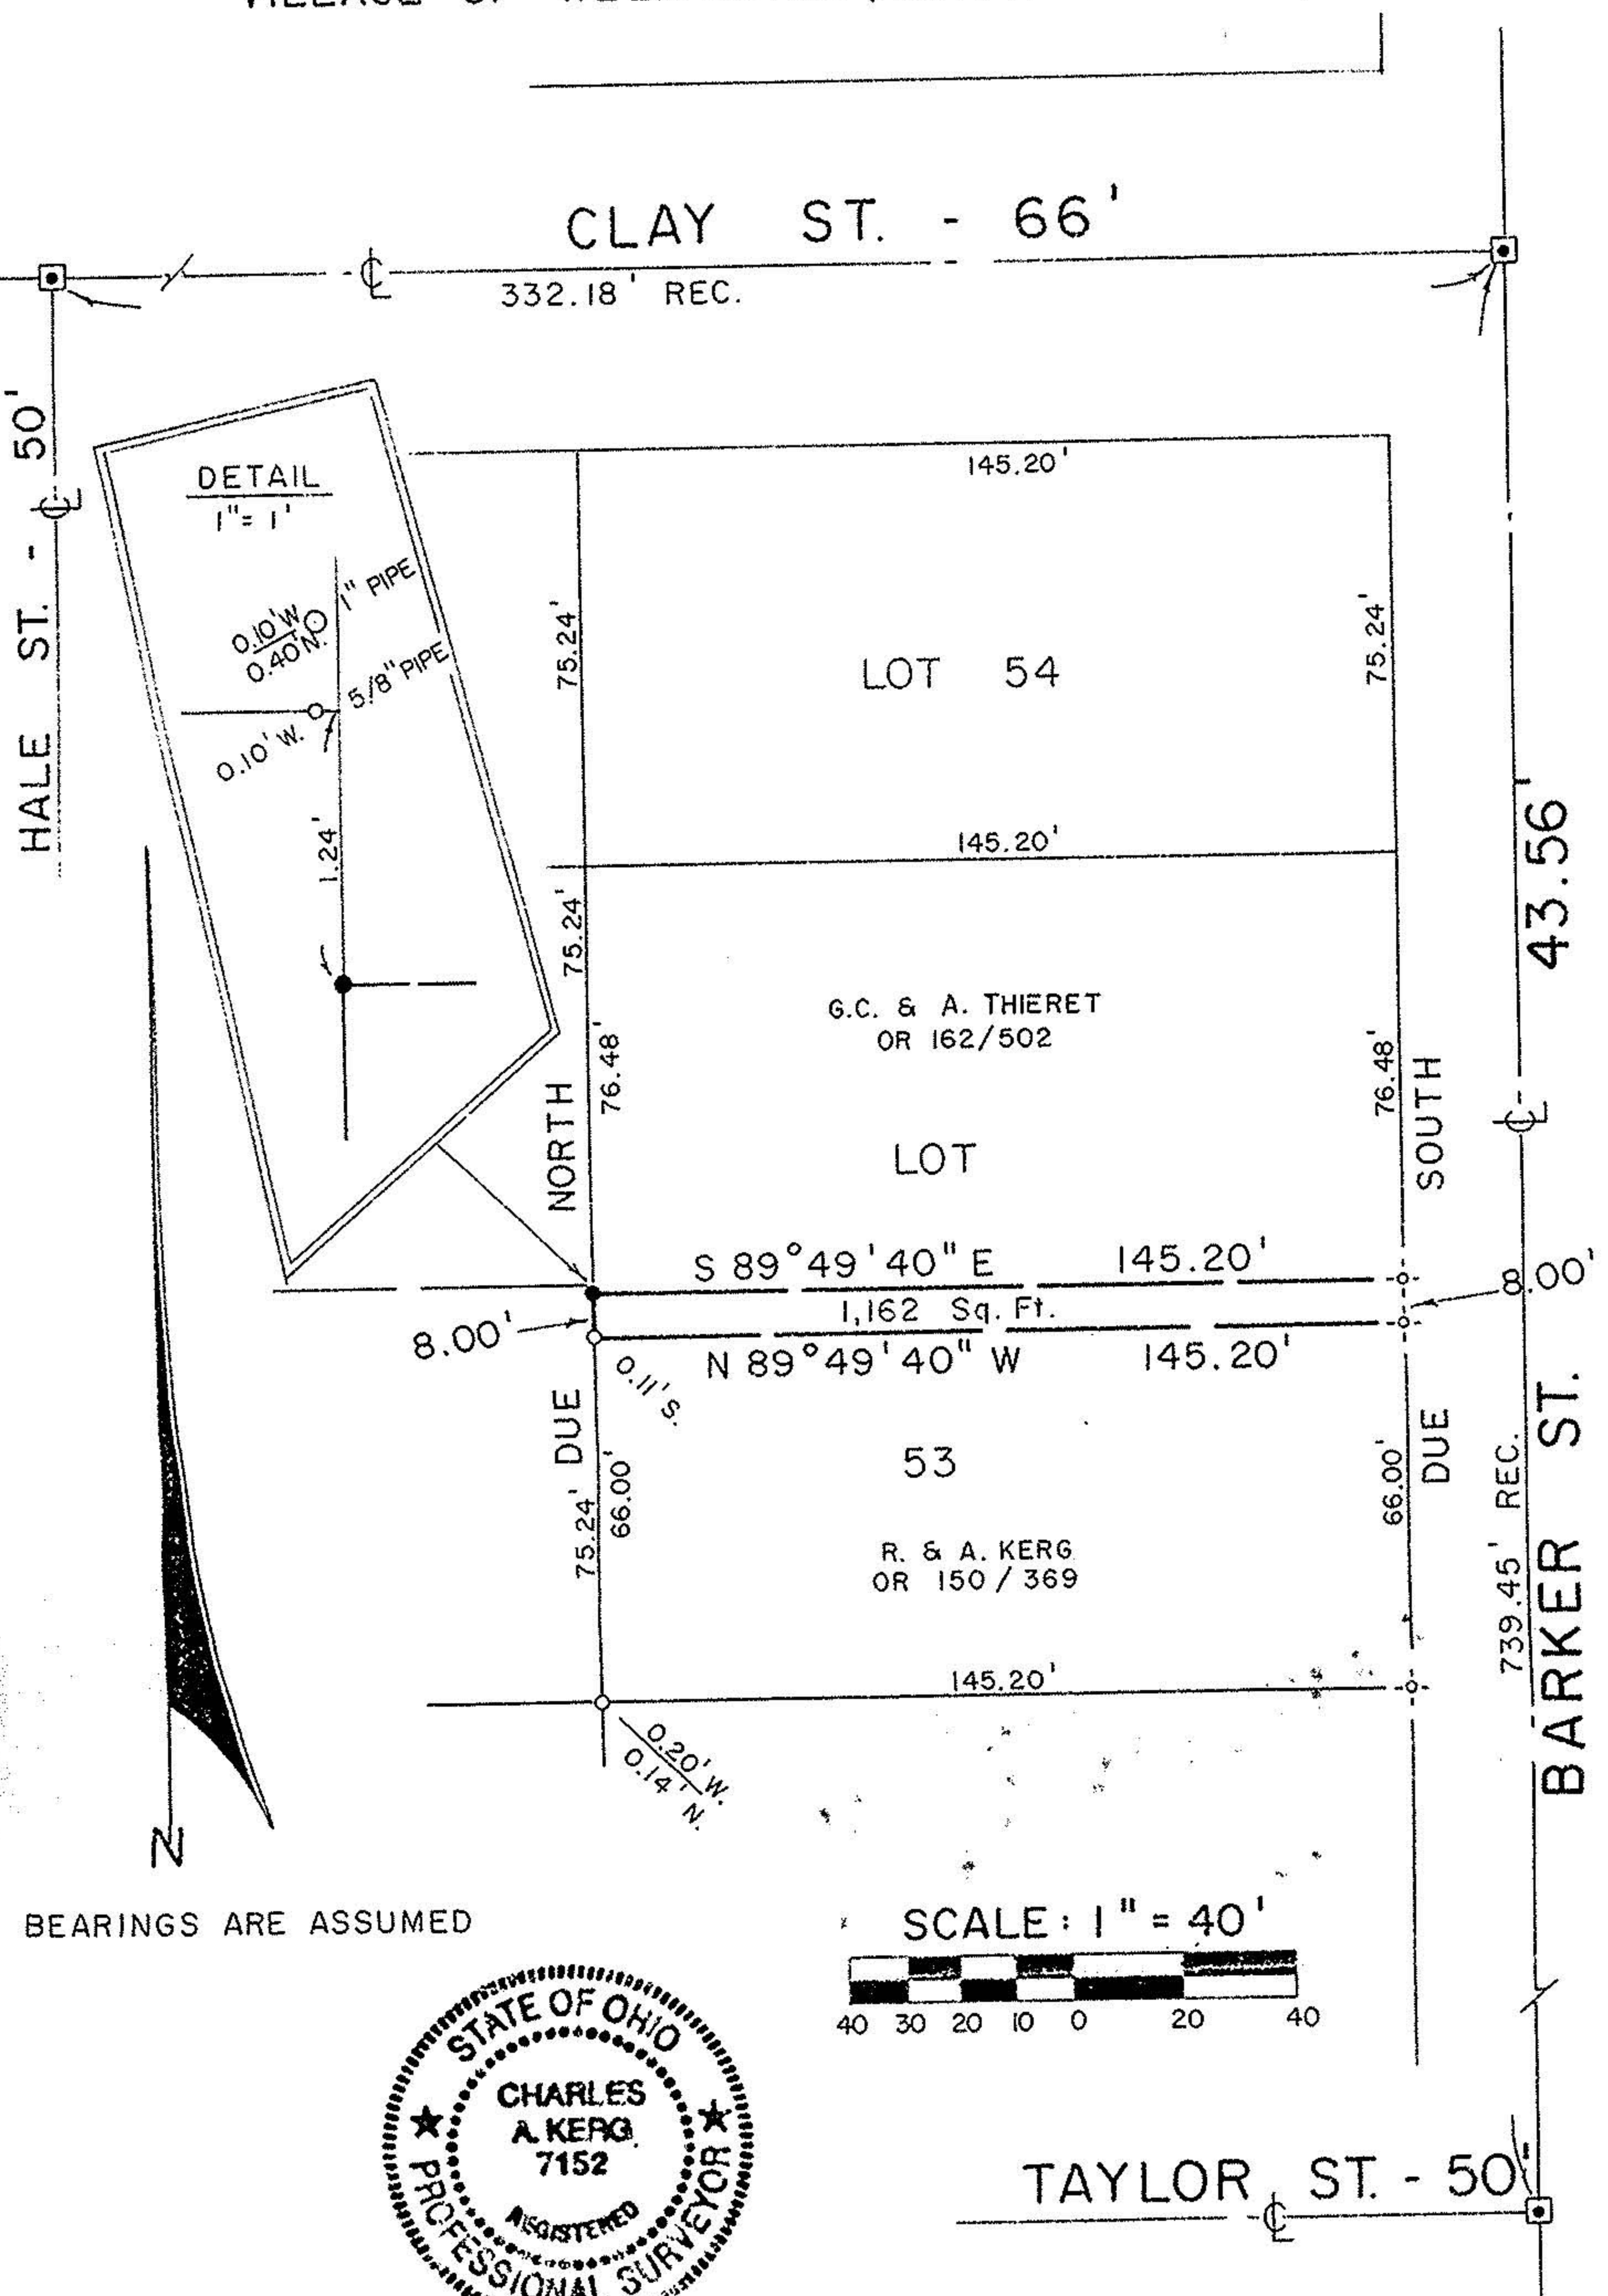


DETAIL
1" = 1'

0.10' W. 1" PIPE
0.40' N. 1" PIPE
0.10' W. 5/8" PIPE
1.24'

G.C. & A. THIERET
OR 162/502

53
R. & A. KERG
OR 150/369

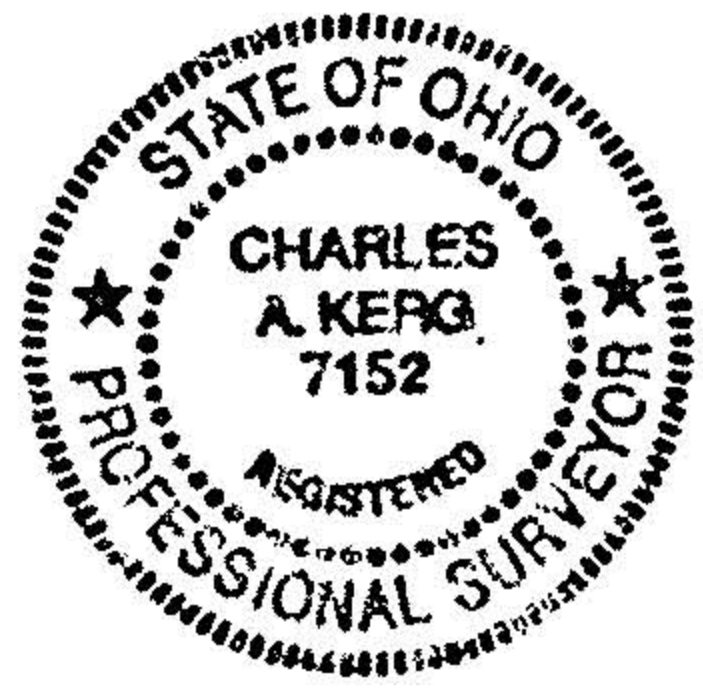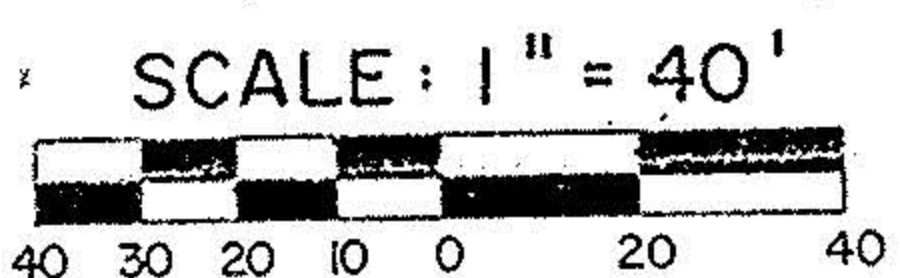

LEGEND

- - IRON PIPE FOUND
- ◻ - IRON PIN MONUMENT FOUND
- ⊕ - DRILLHOLE AND CROSS SET
- - 5/8" IRON PIN SET WITH CAP STAMPED "C. KERG, RLS 7152"

PREPARED BY
KERG SURVEYING

Charles A. Kerg
 CHARLES A. KERG
 REGISTERED OHIO SURVEYOR NO. 7152
 DATE: DECEMBER 6, 1989

BEARINGS ARE ASSUMED