



KS ASSOCIATES, INC.
 424 Middle Ave. P.O. Box 89
 ELYRIA, OHIO 44036
 (216) 322-6317

PROPERTY SURVEY MAP

PART OF
 ORIGINAL WELLINGTON TWP. LOT No 22
 VILL. OF WELLINGTON - COUNTY OF LORAIN
 STATE OF OHIO

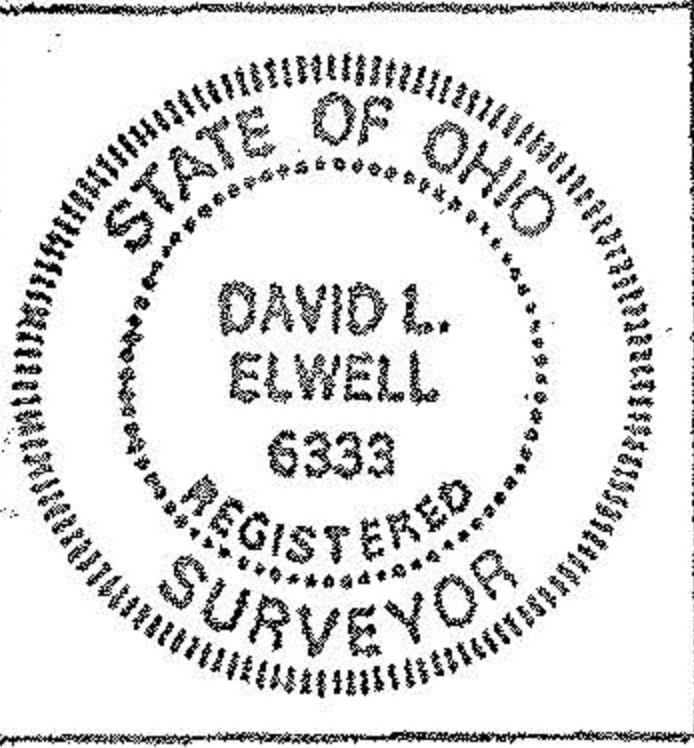


David L. Elwell
 REG. SURVEYOR
 2-15-89
 REV. 4-20-89

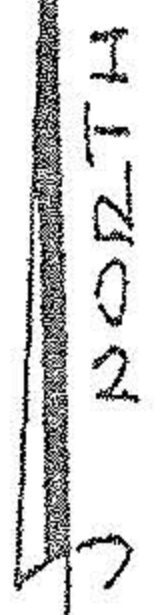

SCALE
 1" = 40'

#18408

0199
 R. A. HORIZ'S ADD.
 P.V. 20AR 8
 DATE
 PIPE FD. 1" V.

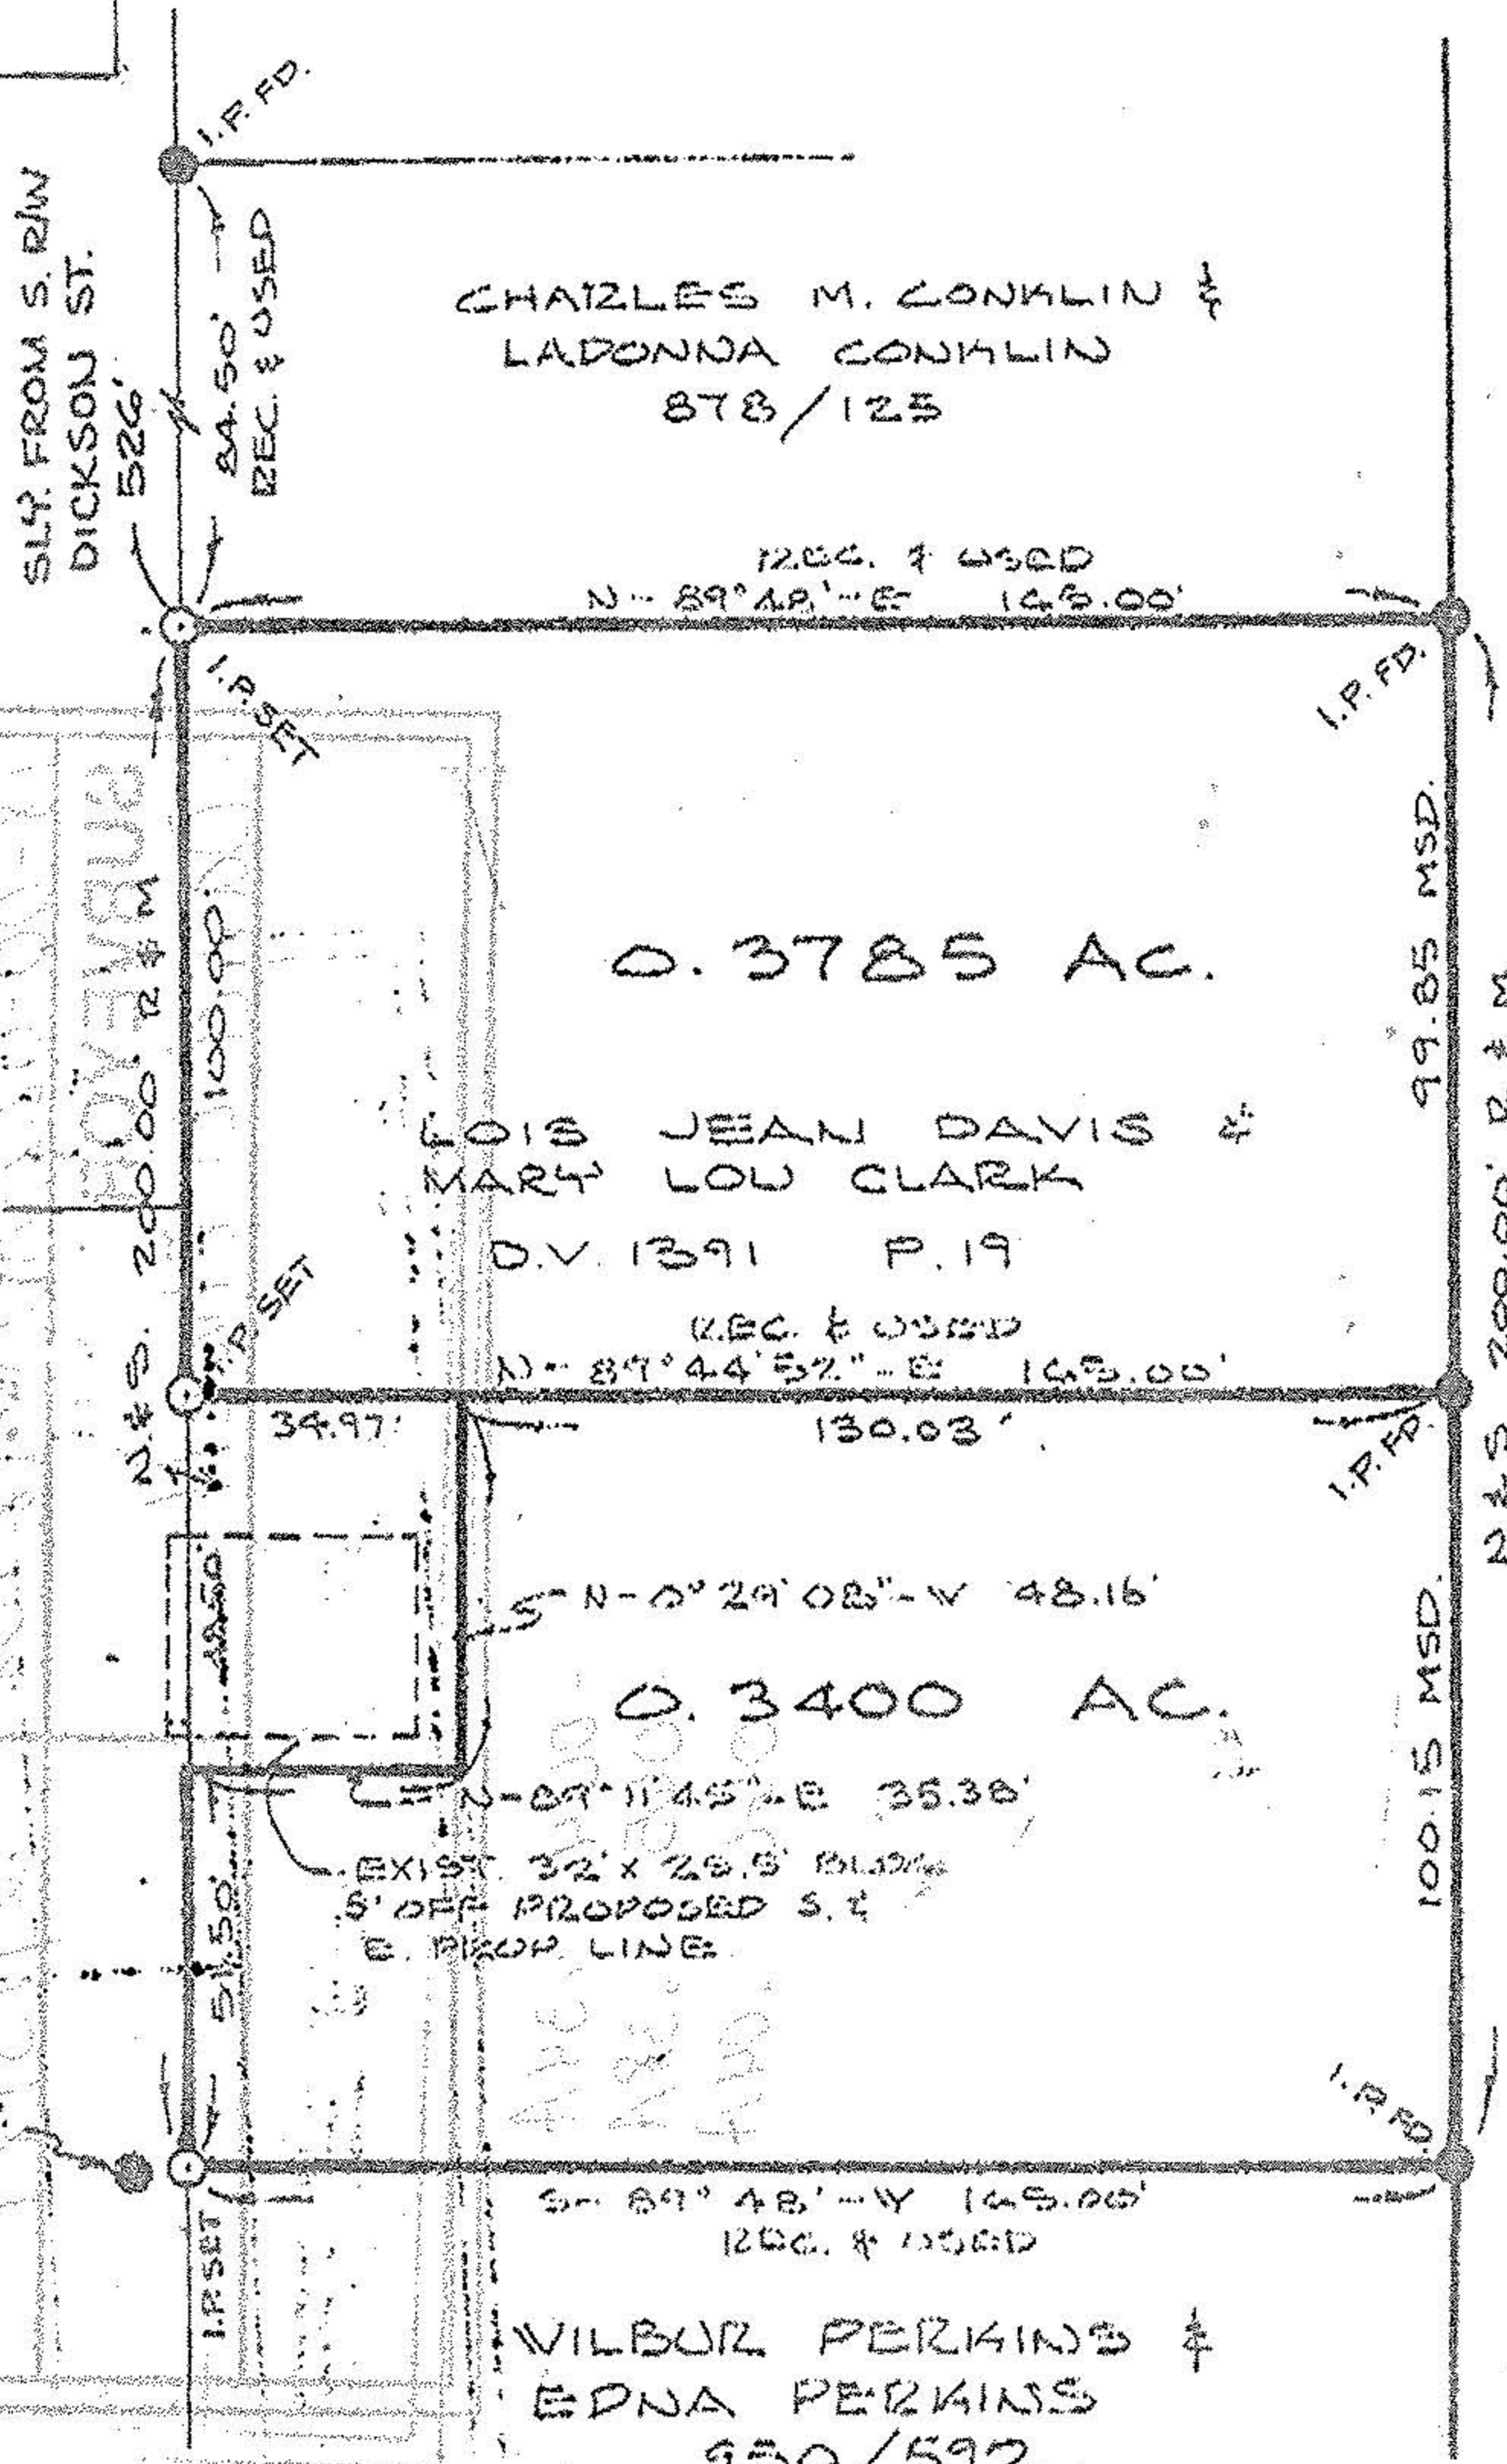

FOREST ST. 66' (EXTENDED)

VILL. OF WELLINGTON

#18408

APPROVED LORAIN CO. MAP DEPT.
DATES - 1-89
PAGE 18-00-022-A
BY Carol-Franus
VOID # 18408 AFTER - 060