


18-00-027-102

18-00-027-

Map of Part of Bennett and Kirk Co. Add.
Wollington Village Lorain Co. Ohio.
Scale 1" 100' June 10, 1978

Volume 1 Page 33 Lorain Co. Records

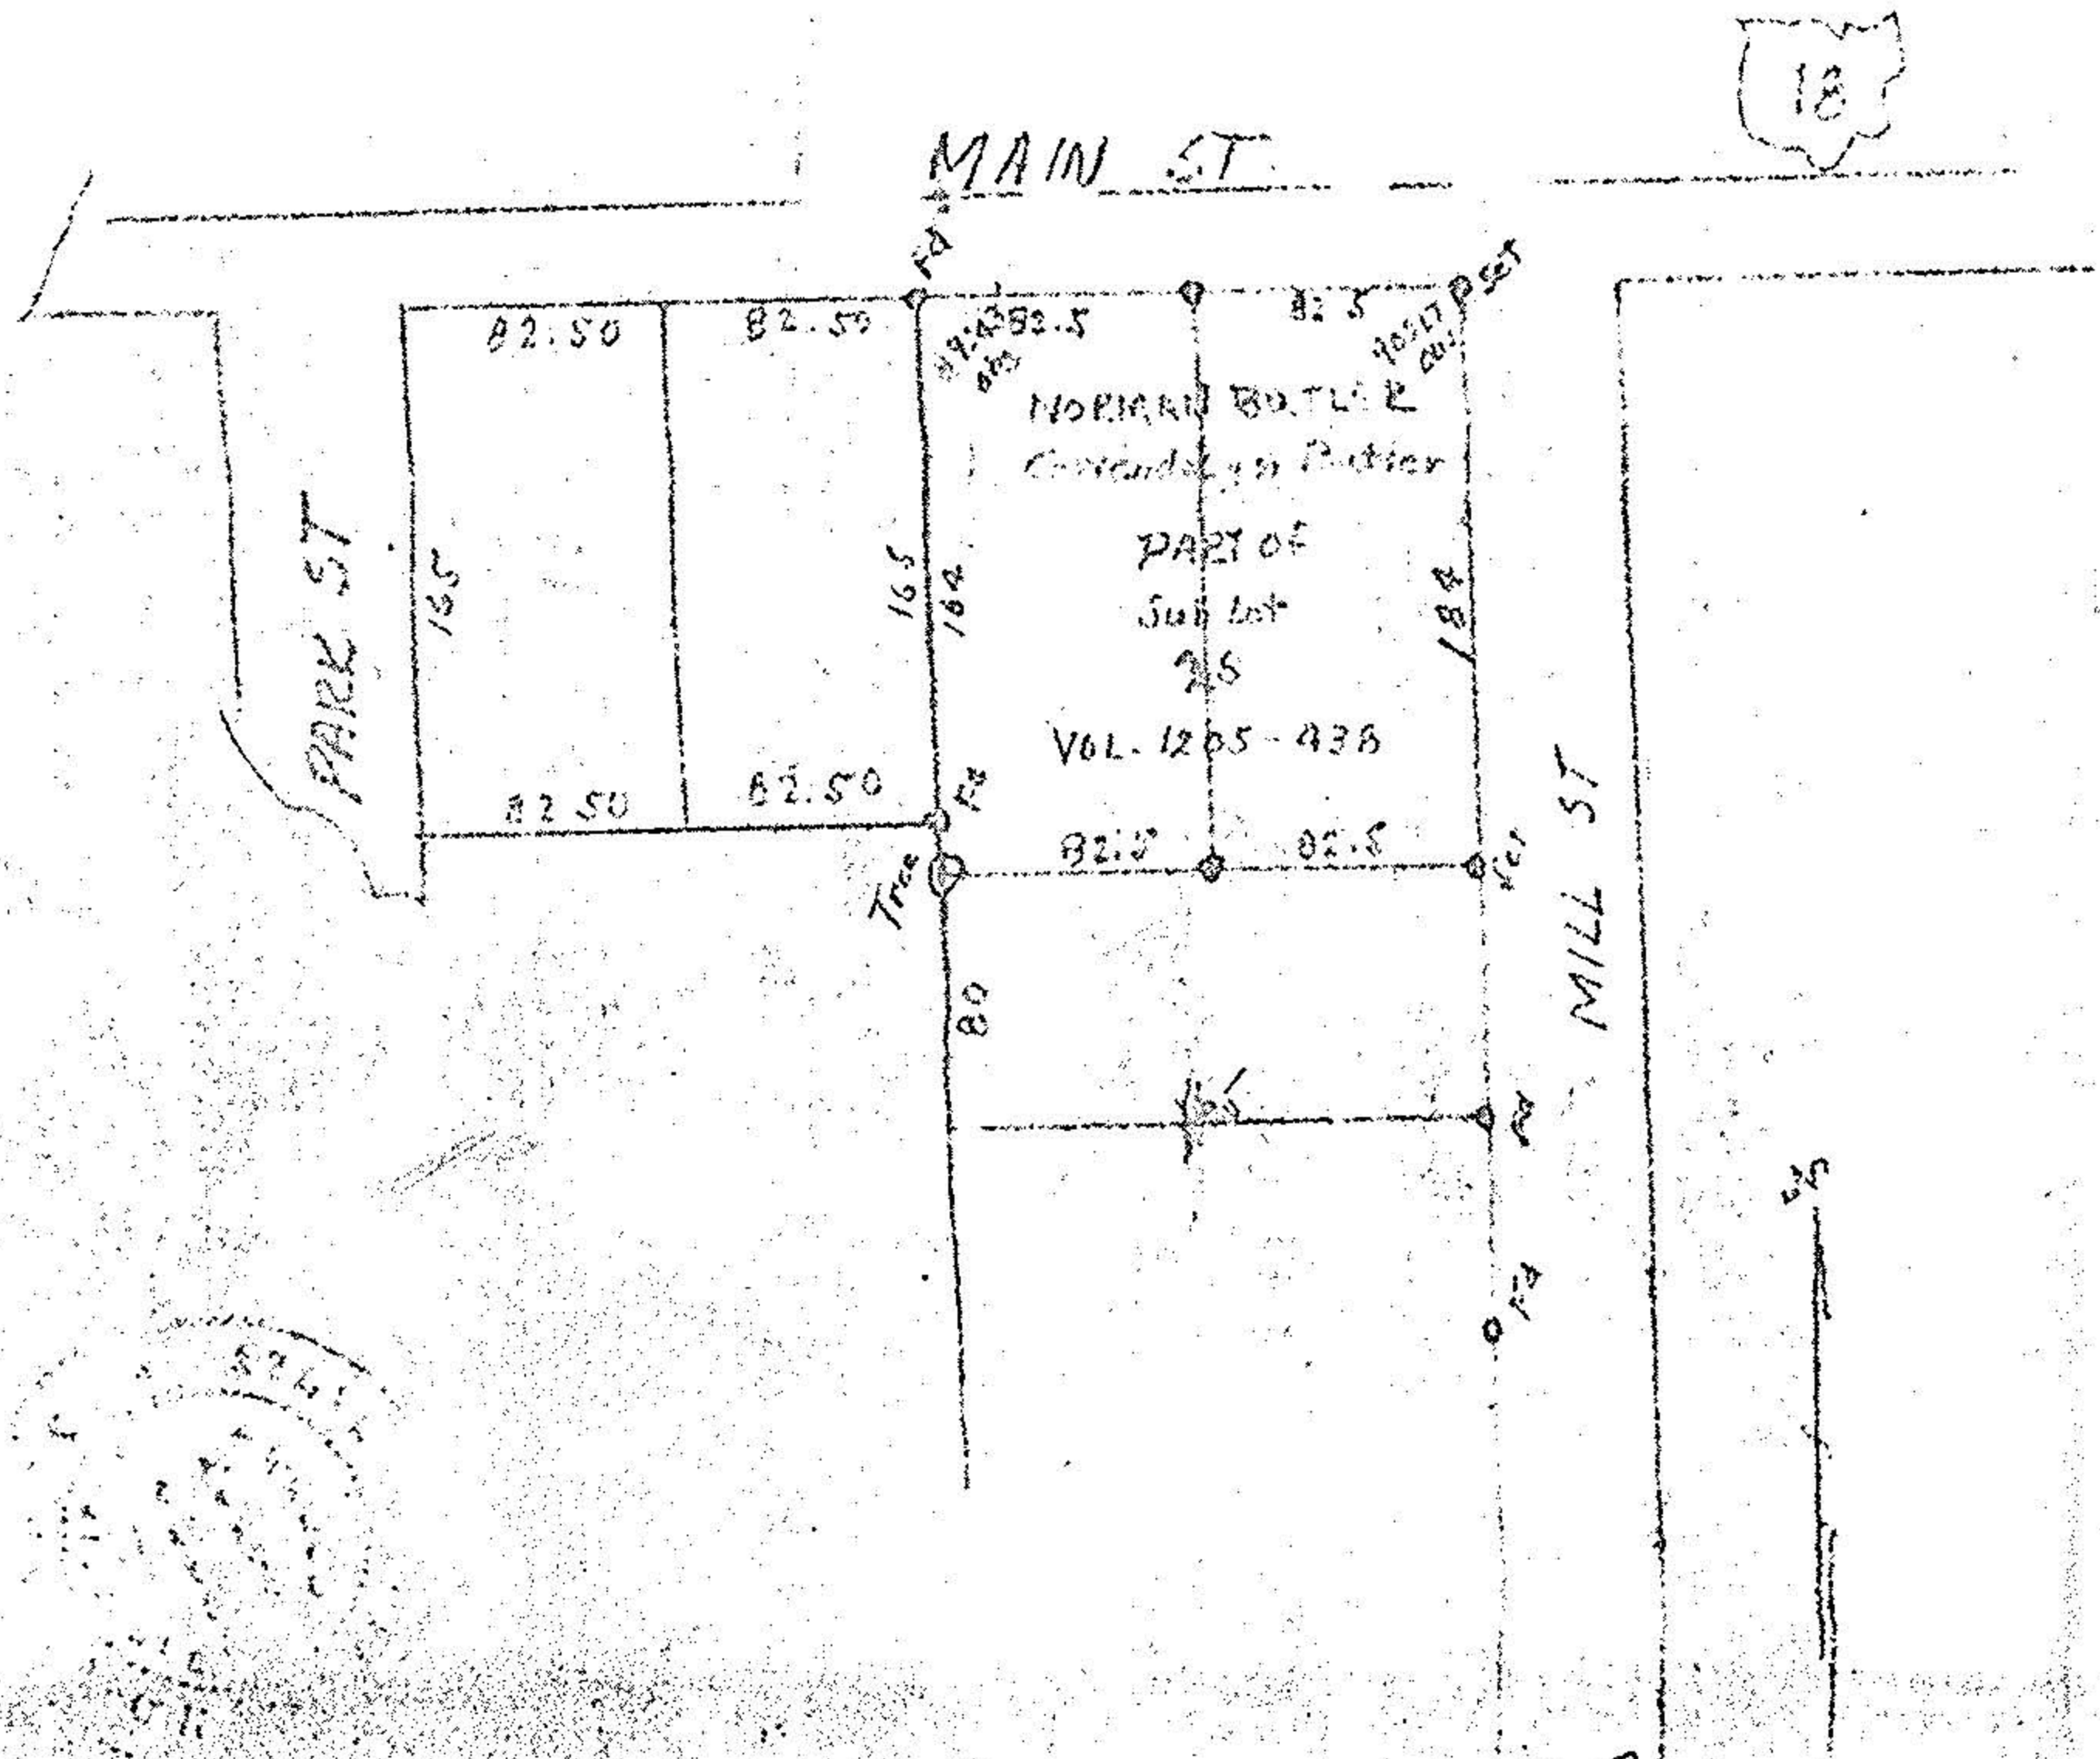

18-00-027-A

18-00-027-102

The Wellington Planning Com.
James Guerin
7/24/78