


CARDINAL SURVEYS  
 PLAT OF SURVEY  
 PREPARED FOR JIMMIE LAND

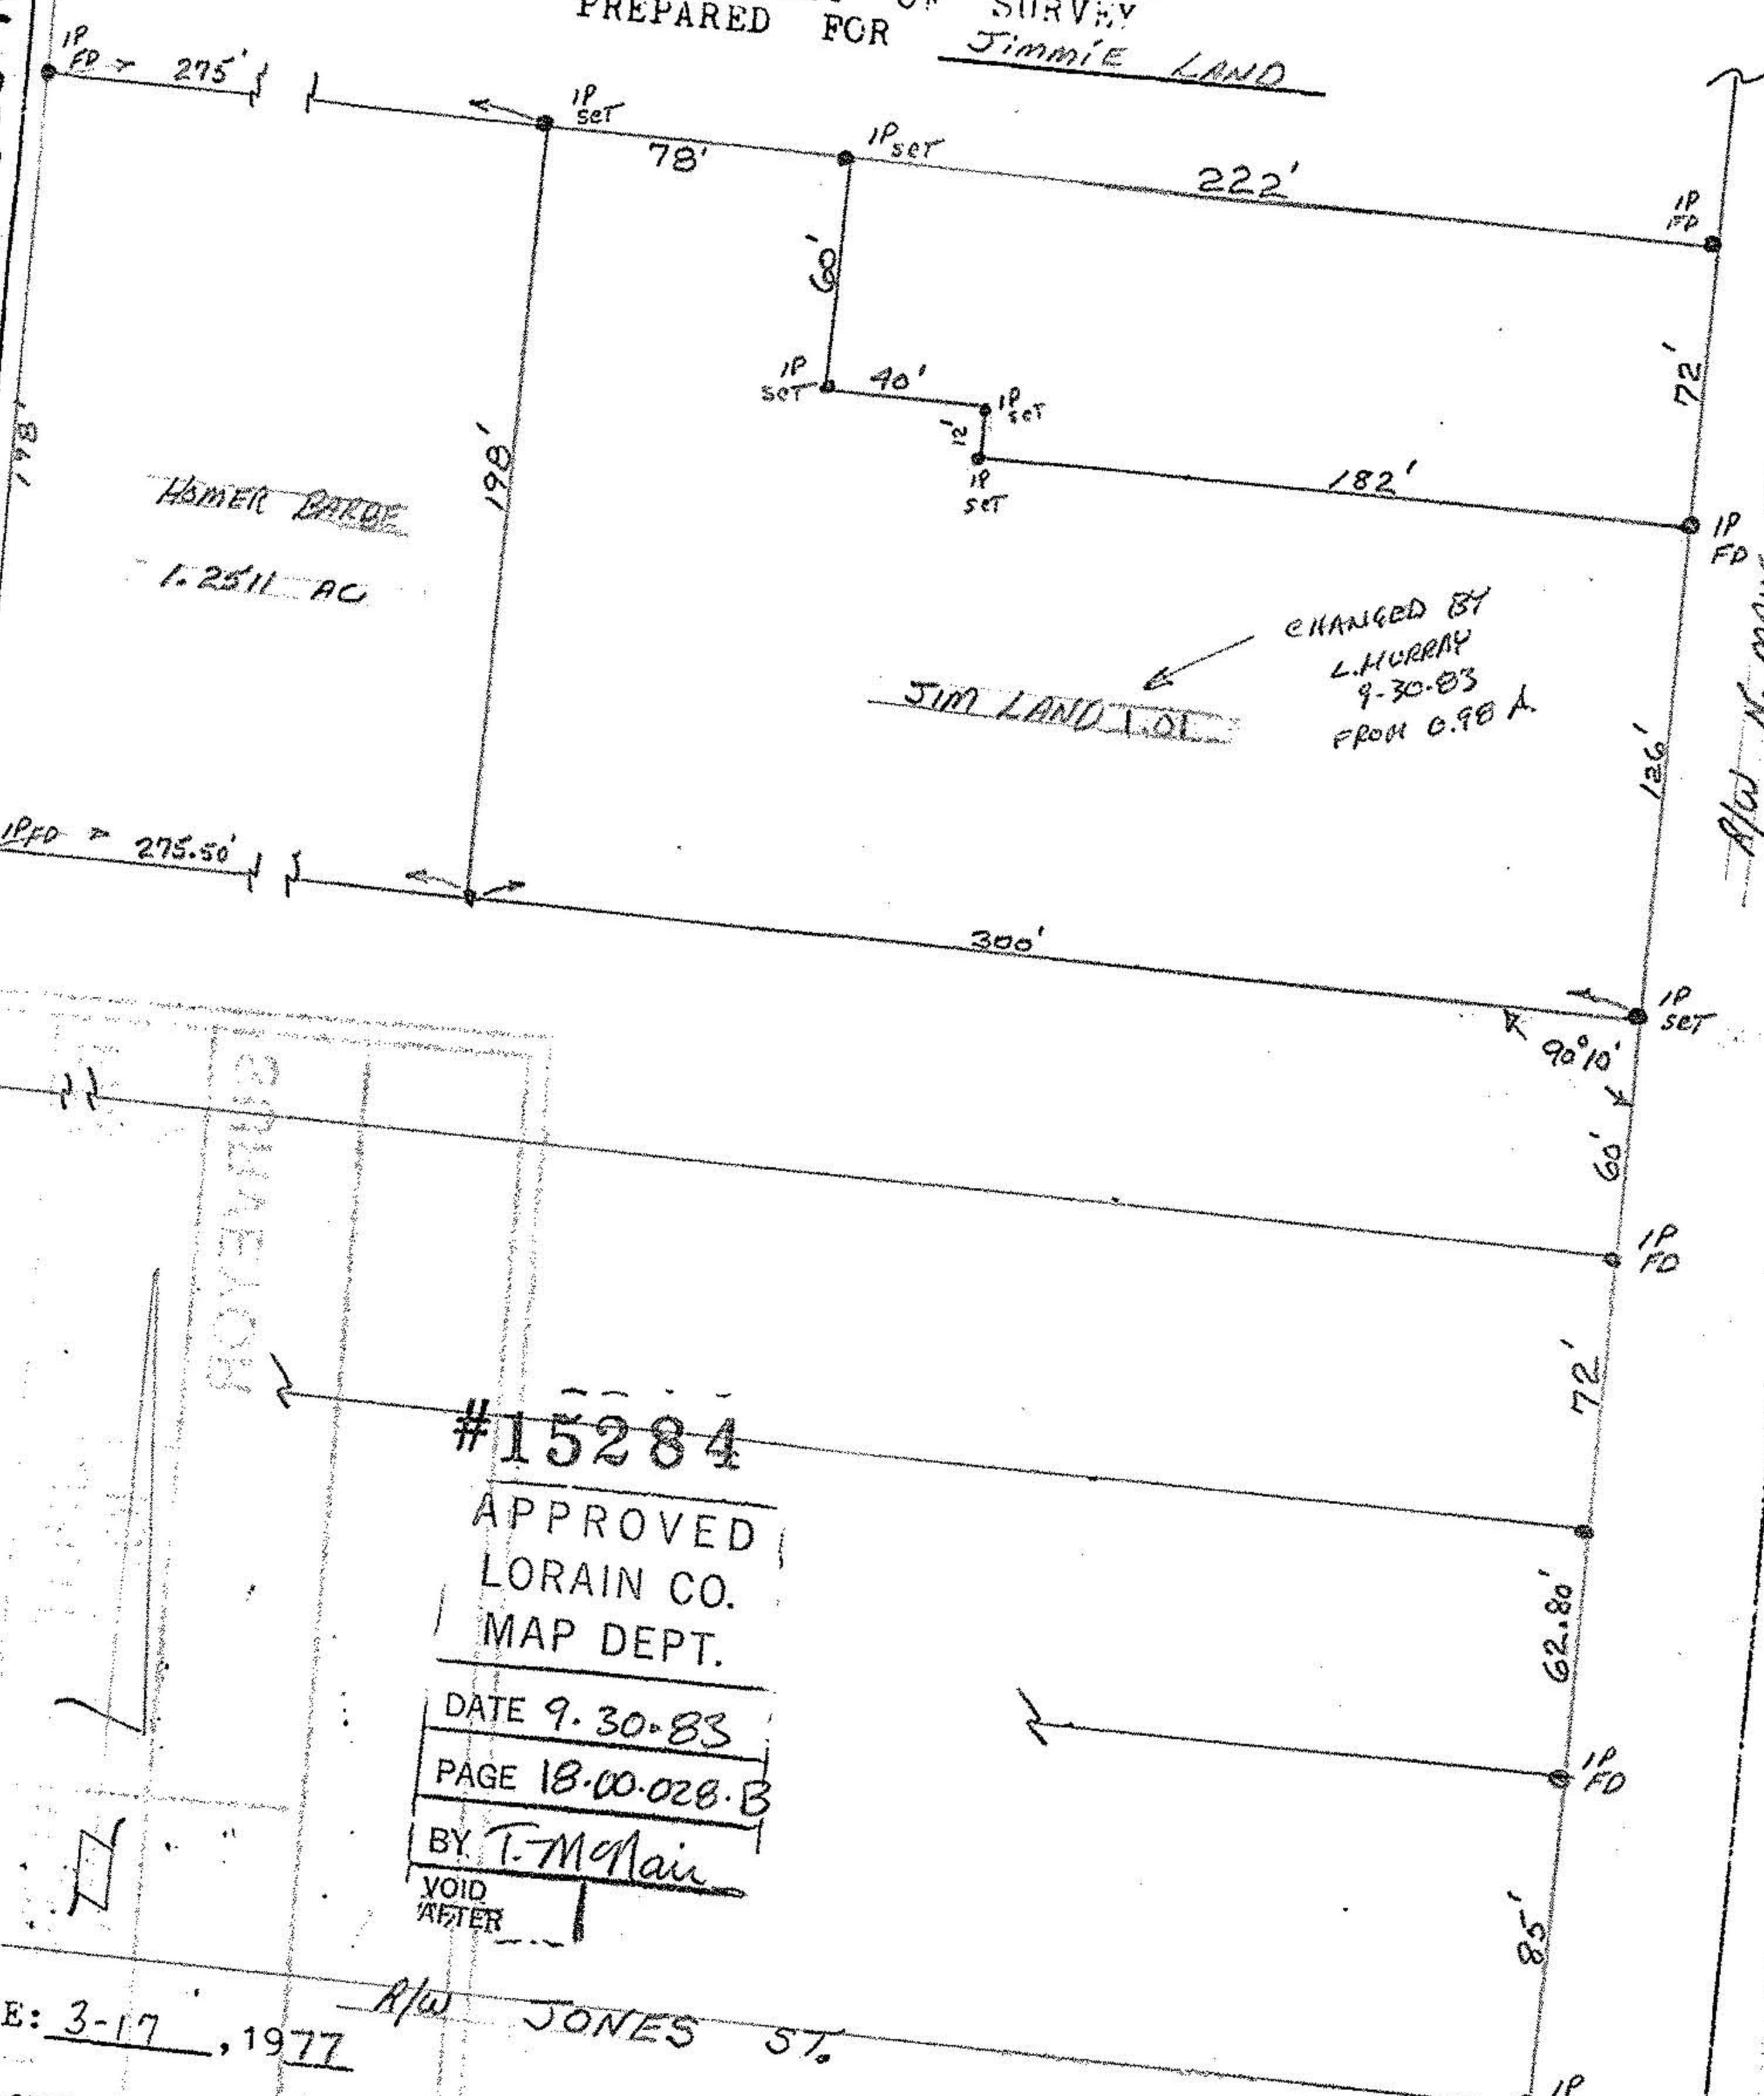

CHANGED BY  
 L. MURPHY  
 9-30-83  
 FROM 0.98 A.

#15284  
 APPROVED  
 LORAIN CO.  
 MAP DEPT.  
 DATE 9.30.83  
 PAGE 18.00.028.B  
 BY T. McMain  
 VOID  
 AFTER

RE: 3-17, 1977  
 APPROVED BY WELLINGTON PLANNING COMMISSION  
 NO PLAT. REQUIRED

SCALE: 1" = 60'

*T. McMain* 9/24/83