
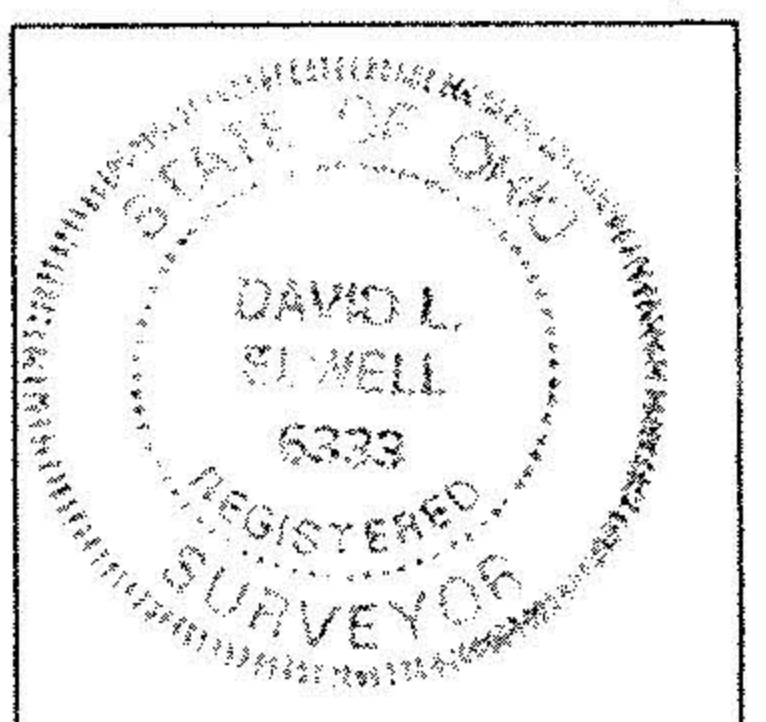


- ABBREVIATIONS**
- C - CALCULATED
 - R - RECORD
 - U - USED
 - M - MEASURED
 - FND - FOUND
- LEGEND**
- Ⓜ - MONUMENT BOX FOUND
 - ⊙ - IRON PIPE/PIN FOUND
 - - 5/8" REBAR SET

BEARINGS ARE TO AN ASSUMED MERIDIAN AND ARE USED TO DENOTE ANGLES ONLY.

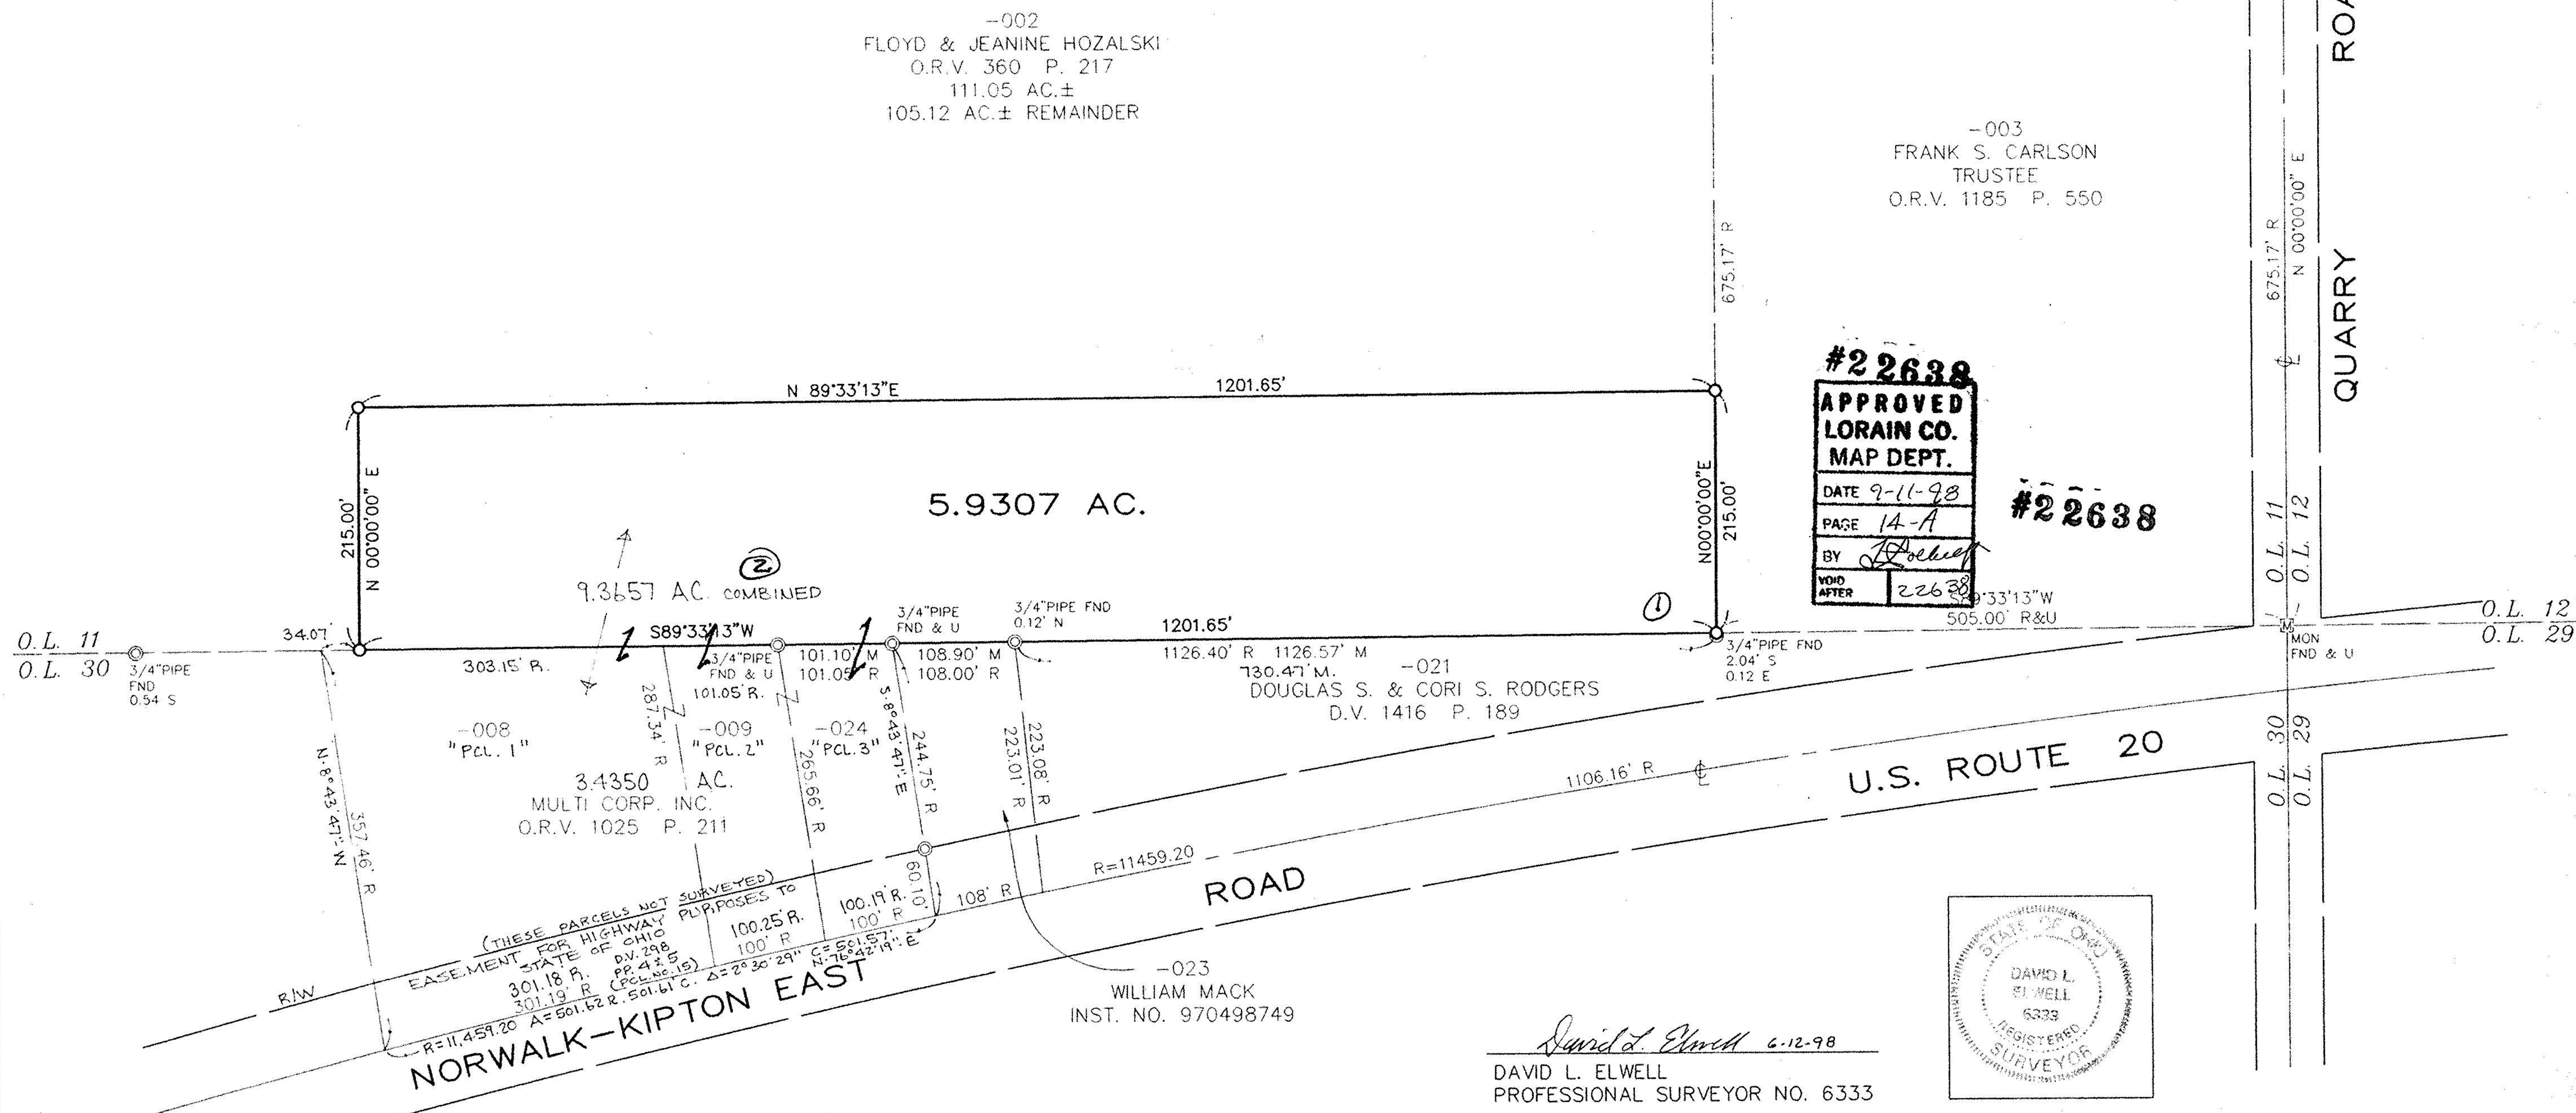

David L. Elwell 6-12-98
 DAVID L. ELWELL
 PROFESSIONAL SURVEYOR NO. 6333

DATE: 06-01-98	
DRAWN BY: YJ	
CHK'D BY: DLE	
F.B.	
DWG. NAME: 88126-C-SURV	
REVISIONS	
5-25-98	COMBINED PARCEL DATA

BOUNDARY SURVEY
 PART OF ORIGINAL PITTSFIELD TOWNSHIP LOT NO. 11
 TOWNSHIP OF PITTSFIELD
 COUNTY OF LORAIN STATE OF OHIO

KS ASSOCIATES, INC.
 ENGINEERS/SURVEYORS
 424 Middle Avenue
 P.O. Box 89
 Elyria, Ohio 44036
 PHONE: (216) 322-6317 * FAX: (216) 284-0623

SHEET 1 OF 1
 JOB NO. 98126