


4-C

17-00
04.44
J4400

Part of C.L. W. Pittsfield, Sp. Loc. in Co. Ohio
Aug. 12, 1877 By Arnold P. Koepf Reg. Surveyor No. 4301

Vol 1055 - 15
Glen & Virginia Diamond

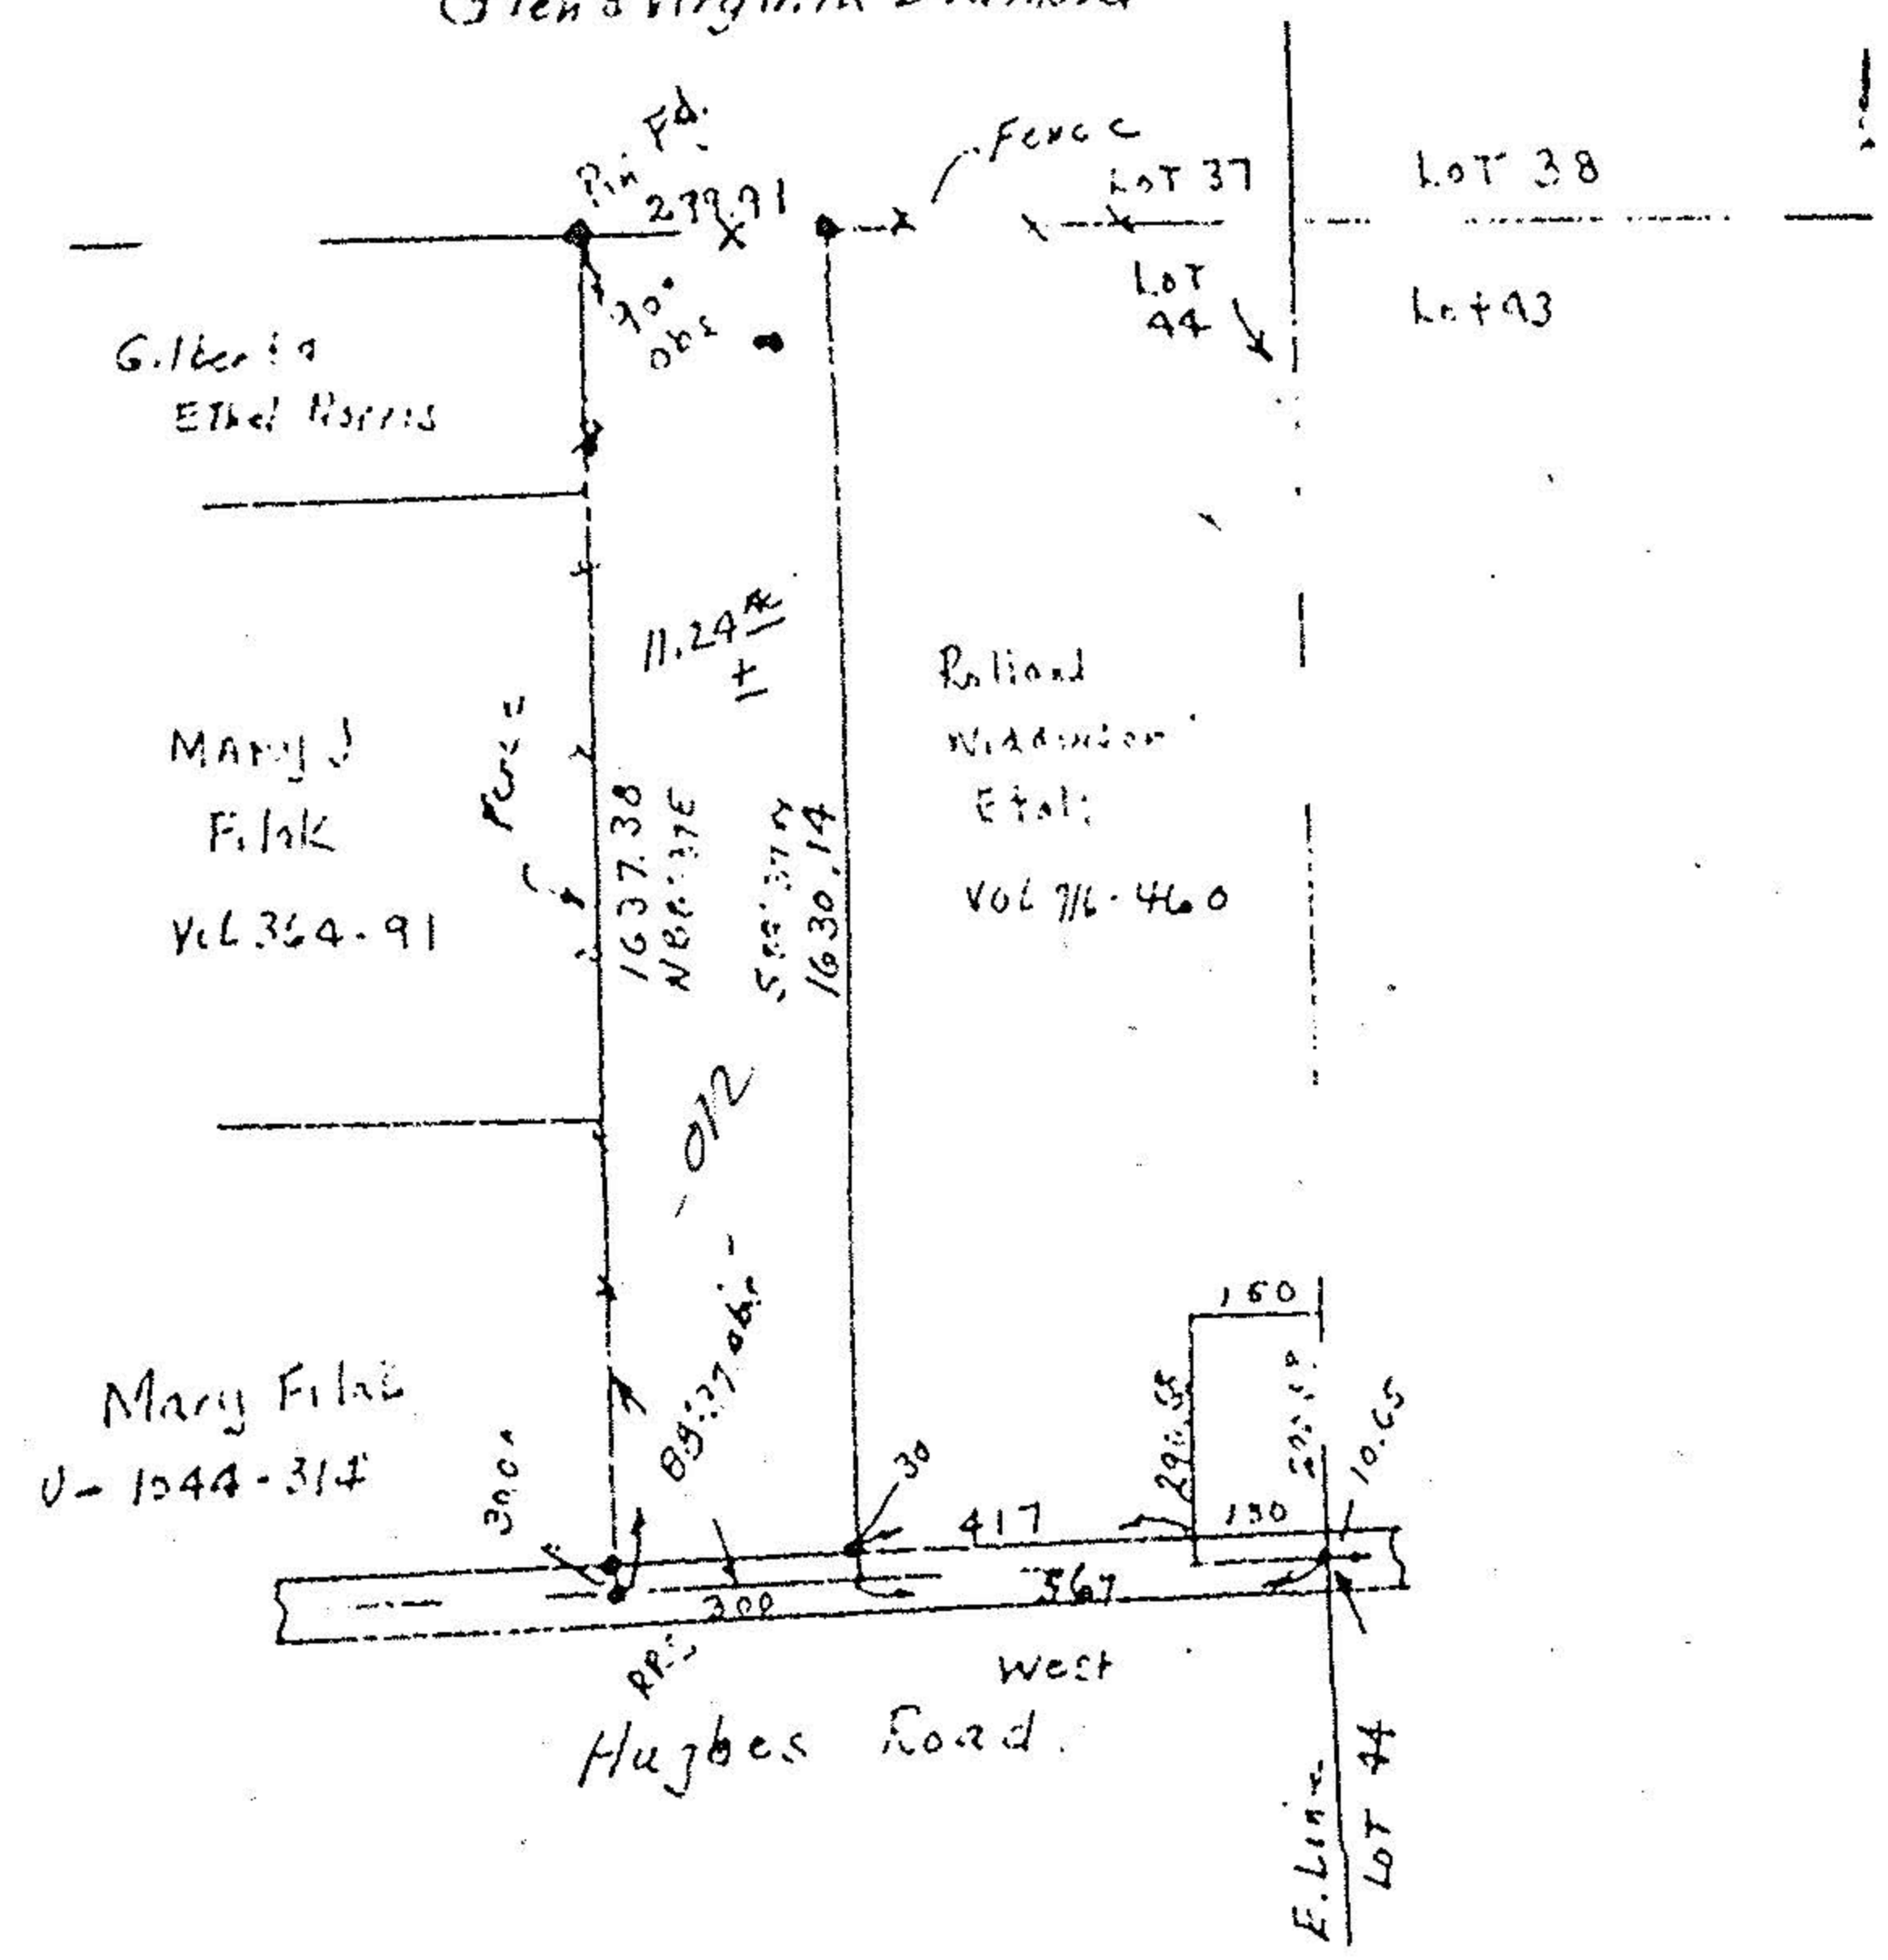

44 70
111
2960

14-C