

MAP OF SURVEY AND LOT SPLIT

PREPARED FOR


LEROY F. AND SHARON M. JORDAN

SITUATED IN THE TOWNSHIP OF PITTSFIELD, COUNTY OF LORAIN STATE OF OHIO AND BEING KNOWN AS PART OF ORIGINAL PITTSFIELD TOWNSHIP LOT 68 AND 73



100' 0' 100' 200'
SCALE: 1" = 100'

J.D.L. MULL FARMS
P.P.#14-00-068-000-002
VOL.1265 PG.529

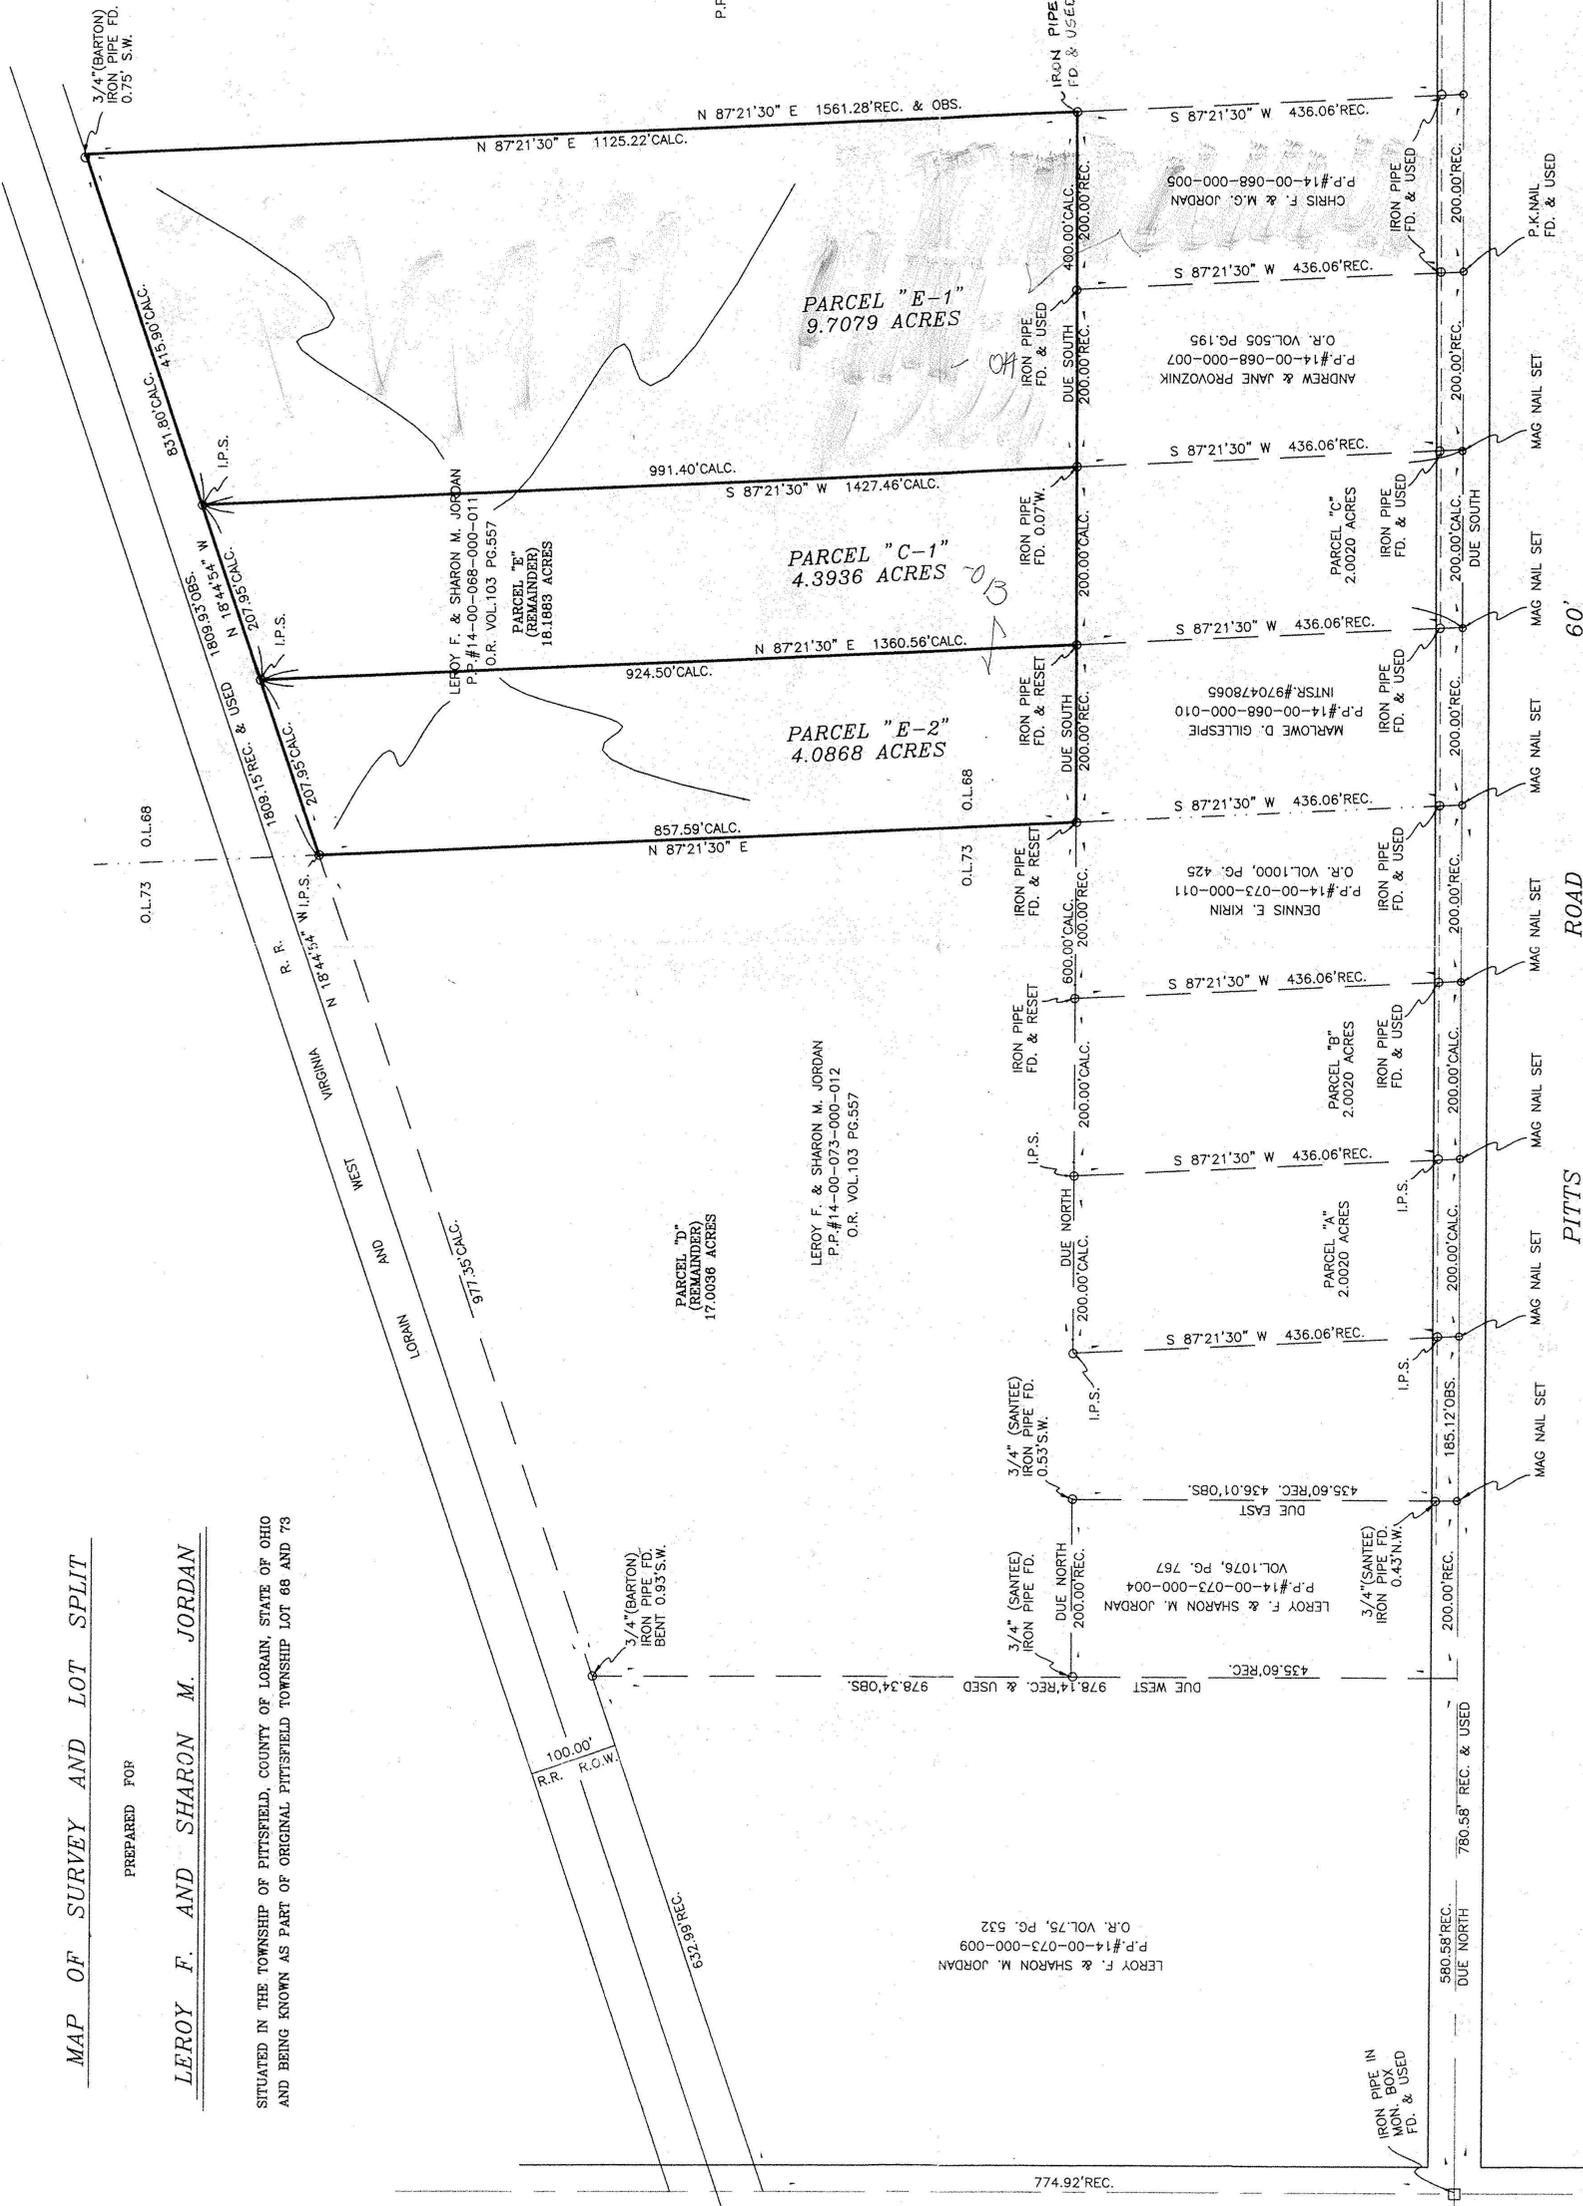

SURVEYOR'S STATEMENT

DISTANCES ARE EXPRESSED IN FEET AND DECIMAL PARTS THEREOF. BEARINGS ARE TO AN ASSUMED MERIDIAN AND ARE USED TO INDICATE ANGLES ONLY. PERMANENT MONUMENTS WERE FOUND OR SET AS INDICATED HEREON. — 0 — I.P.S. INDICATES A 5/8" IRON PIN WITH CAP SET. ALL OF WHICH I DECLARE TO BE CORRECT TO THE BEST OF MY ABILITIES AND BELIEFS.

THOMAS M. SNEZEK, R.L.S. #7051
DATE 11-2-01



REVISOR 11/1/00
REVISED 4/14/00
PROJECT NO. 0002
1/24/00

ROAD

PITTS

60'

NOTE:
ALL IRON PINS SET ALONG THE WEST SIDE OF PITTS ROAD WERE SET AT 25.00' FROM THE CENTERLINE OF SAID ROADWAY CONSISTENT WITH ALL EXISTING IRON PINS AND PIPES FOUND

CENTERLINE OF WAKEMAN LORAIN ROAD STATE RT. 303

APPROVED LORAIN CO. MAP DEPT
DATE 3-1-02
PAGE 14-B
BY JHATFIELD
#02-00997

No 00997