


14-A

#19204

14-00-052-000 -
- 007

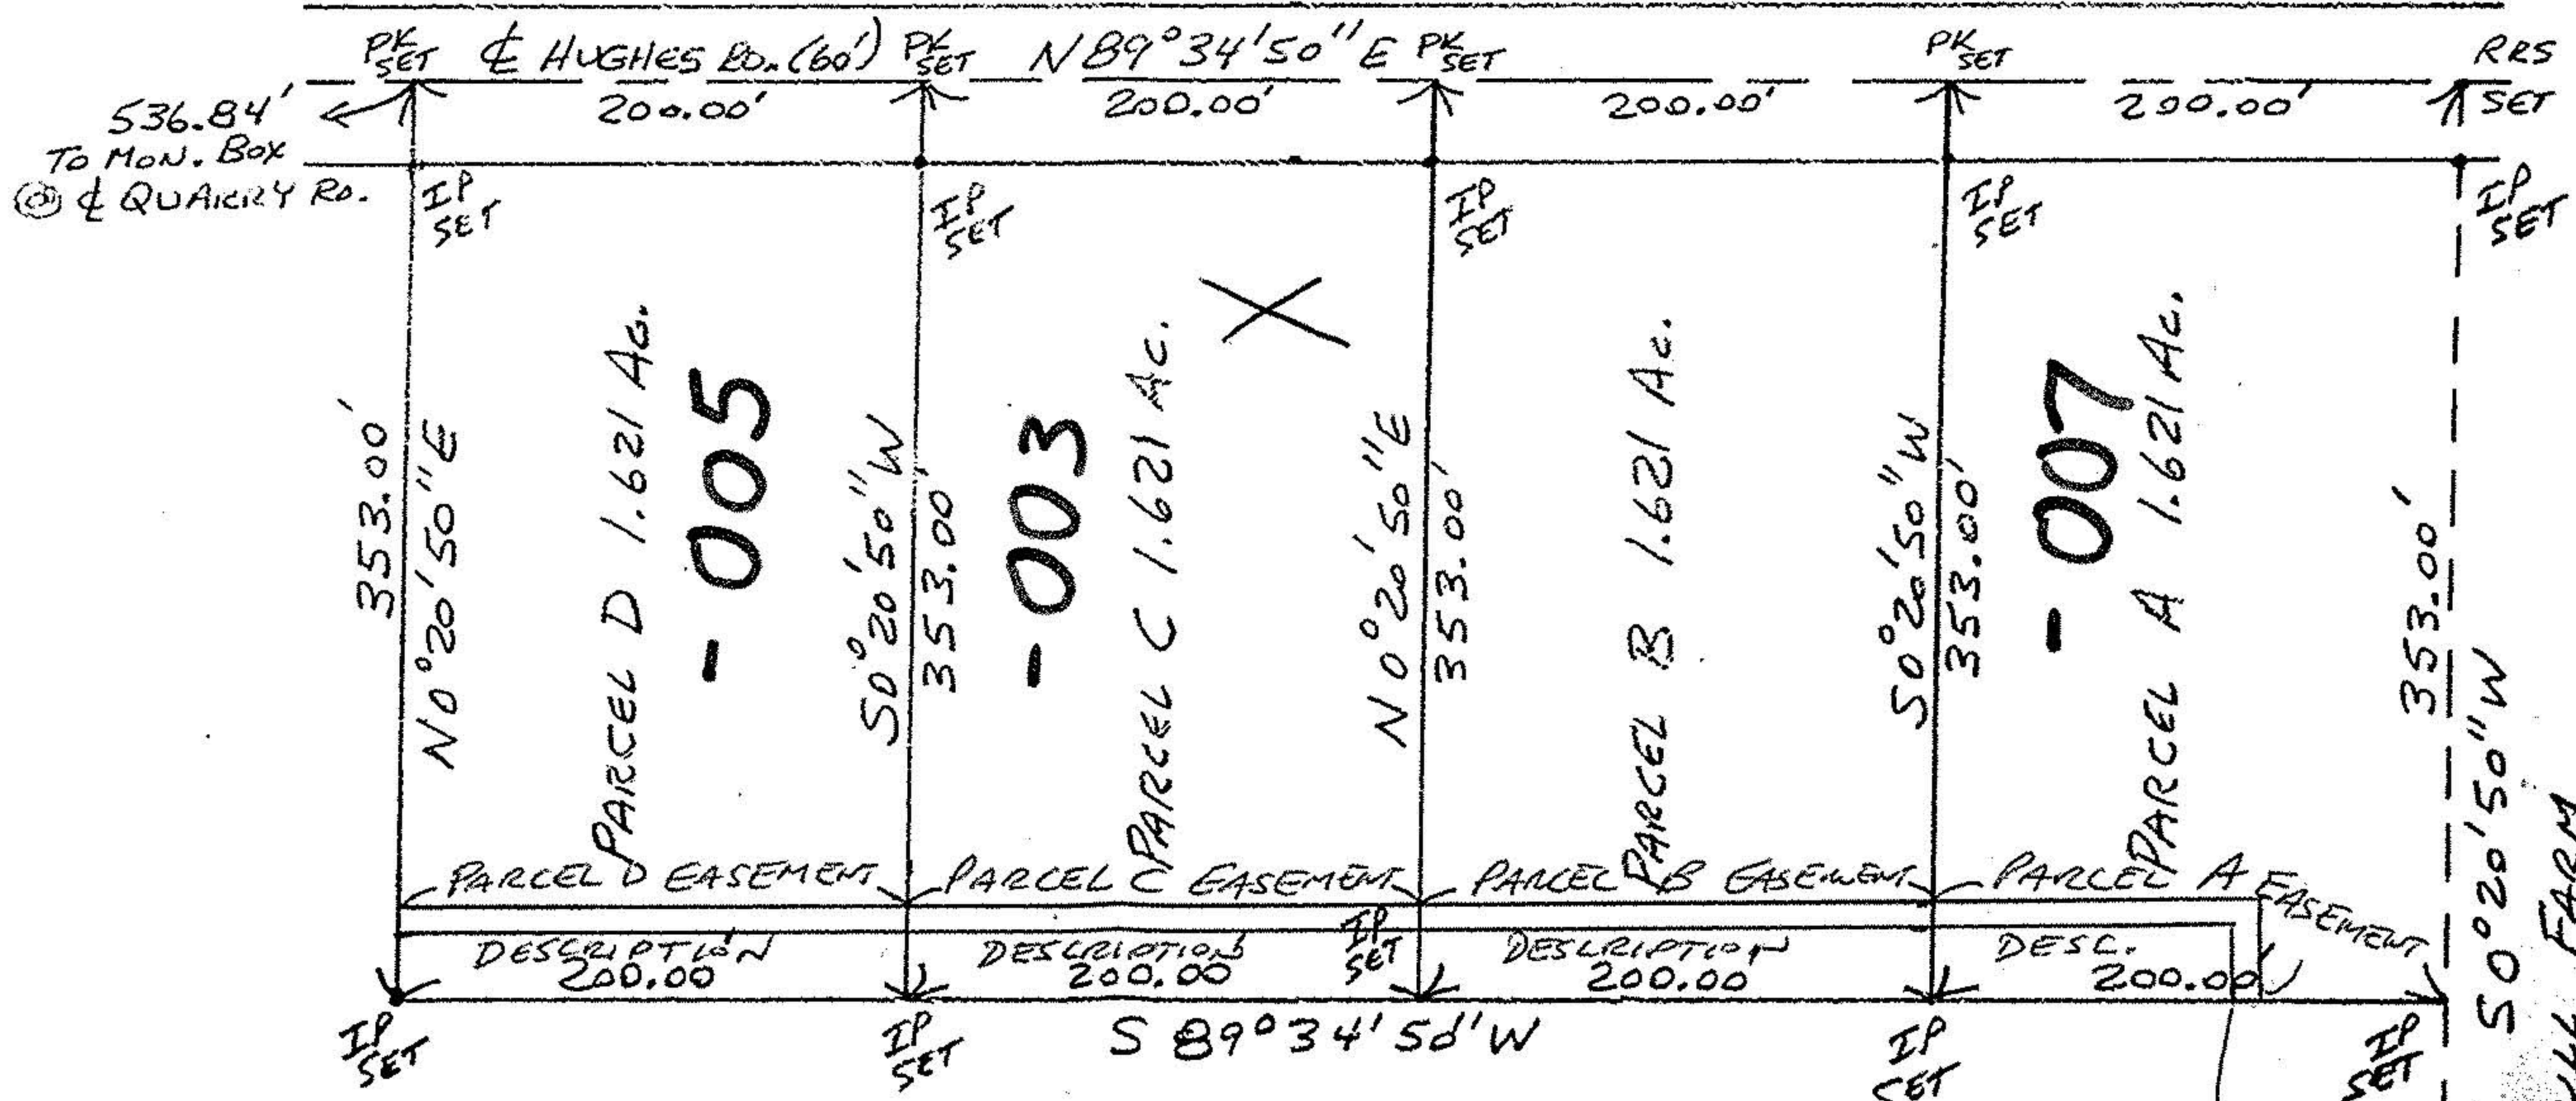


BRILL FARMS, INC.
DEED Vol. 1137, P. 820
52.50 Ac. ORIG.
46.016 Ac. REM.

#19204

APPROVED
LORAIN CO.
MAP DEPT.

MAP OF SURVEY FOR BOB BRILL
D.L. 52- PITTSFIELD TWP. - LORAIN Co.
SEPT. 1990 14-A SCALE 1" = 100'
JOHN R. HAMILTON - REG. SURV. #6861

VOID AFTER #19204

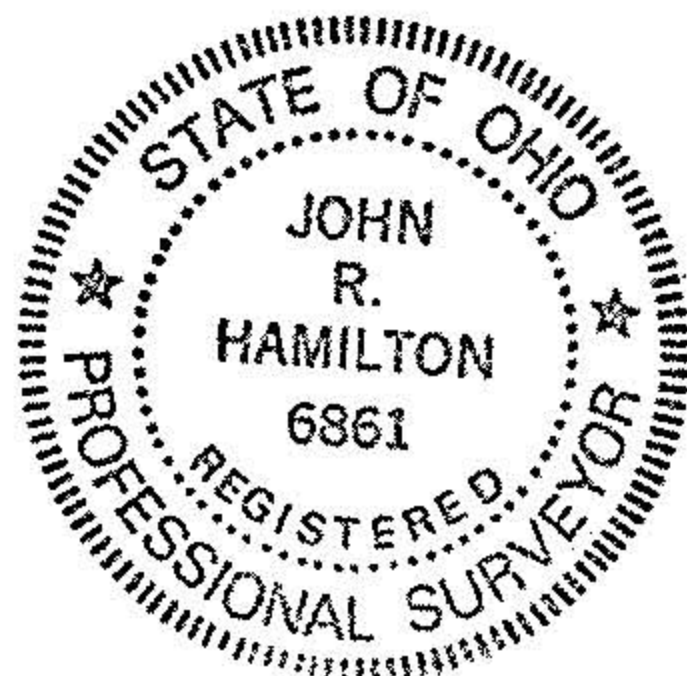

NORTH
SCALE 1" = 100'

JDL MULL FARM
DEED Vol. 1379, P. 748