


#19204

-005

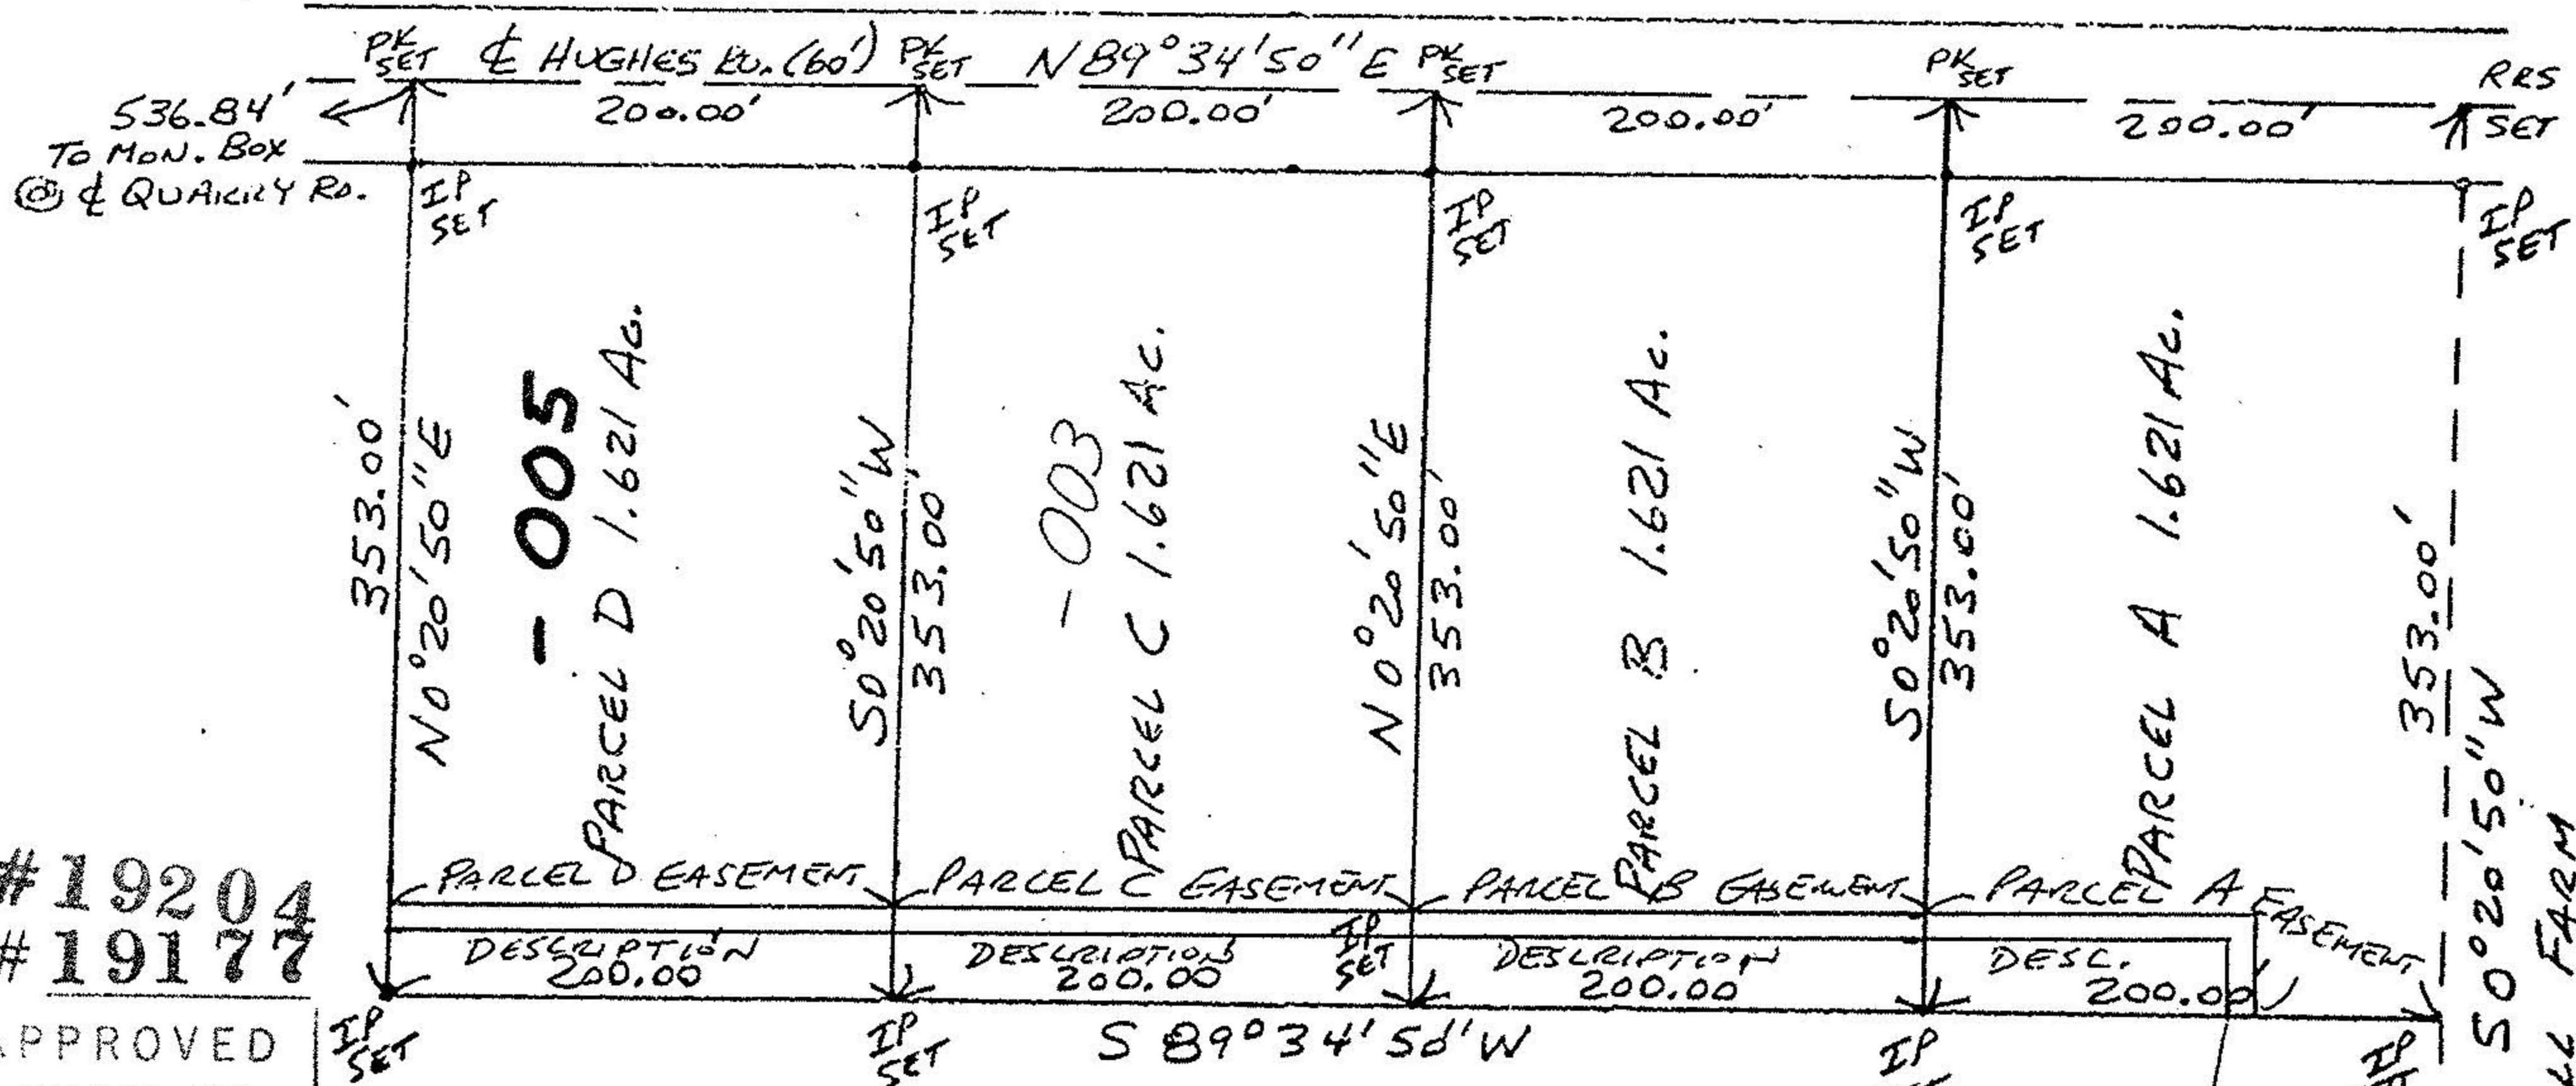

#19204  
#19177

APPROVED  
 LORAIN CO.  
 MAP DEPT.

DATE	10-19-90
PAGE	14-A
BY	CAROLYN FRANCIS
VOID AFTER #	19177

BRILL FARMS, INC.  
 DEED VOL. 1137, P. 820  
 52.50 AC. ORIG.  
 46.016 AC. REM.



MAP OF SURVEY FOR BOB BRILL  
 D.L. 52 - PITTSFIELD TWP. - LORAIN Co  
 SEPT. 1990 SCALE 1" = 100'  
 JOHN R. HAMILTON - REG. SURV. #6861

NORTH  
SCALE 1" = 100'

OUTLET  
 TITLE  
 DESCRIPTION

J.D.L. MULL FARM  
 DEED VOL. 1379, P. 740