
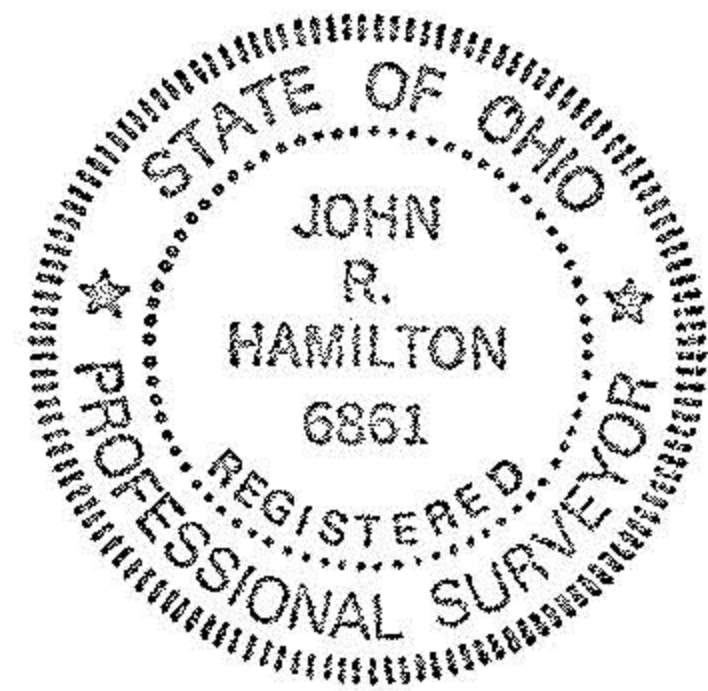


MAP OF SURVEY FOR GORDY HALES
 D.L. 52 - PITTSFIELD TWP. - LORAIN CO.
 APRIL 1991 SCALE 1" = 100'
 JOHN R. HAMILTON - REG. SURV. #6861

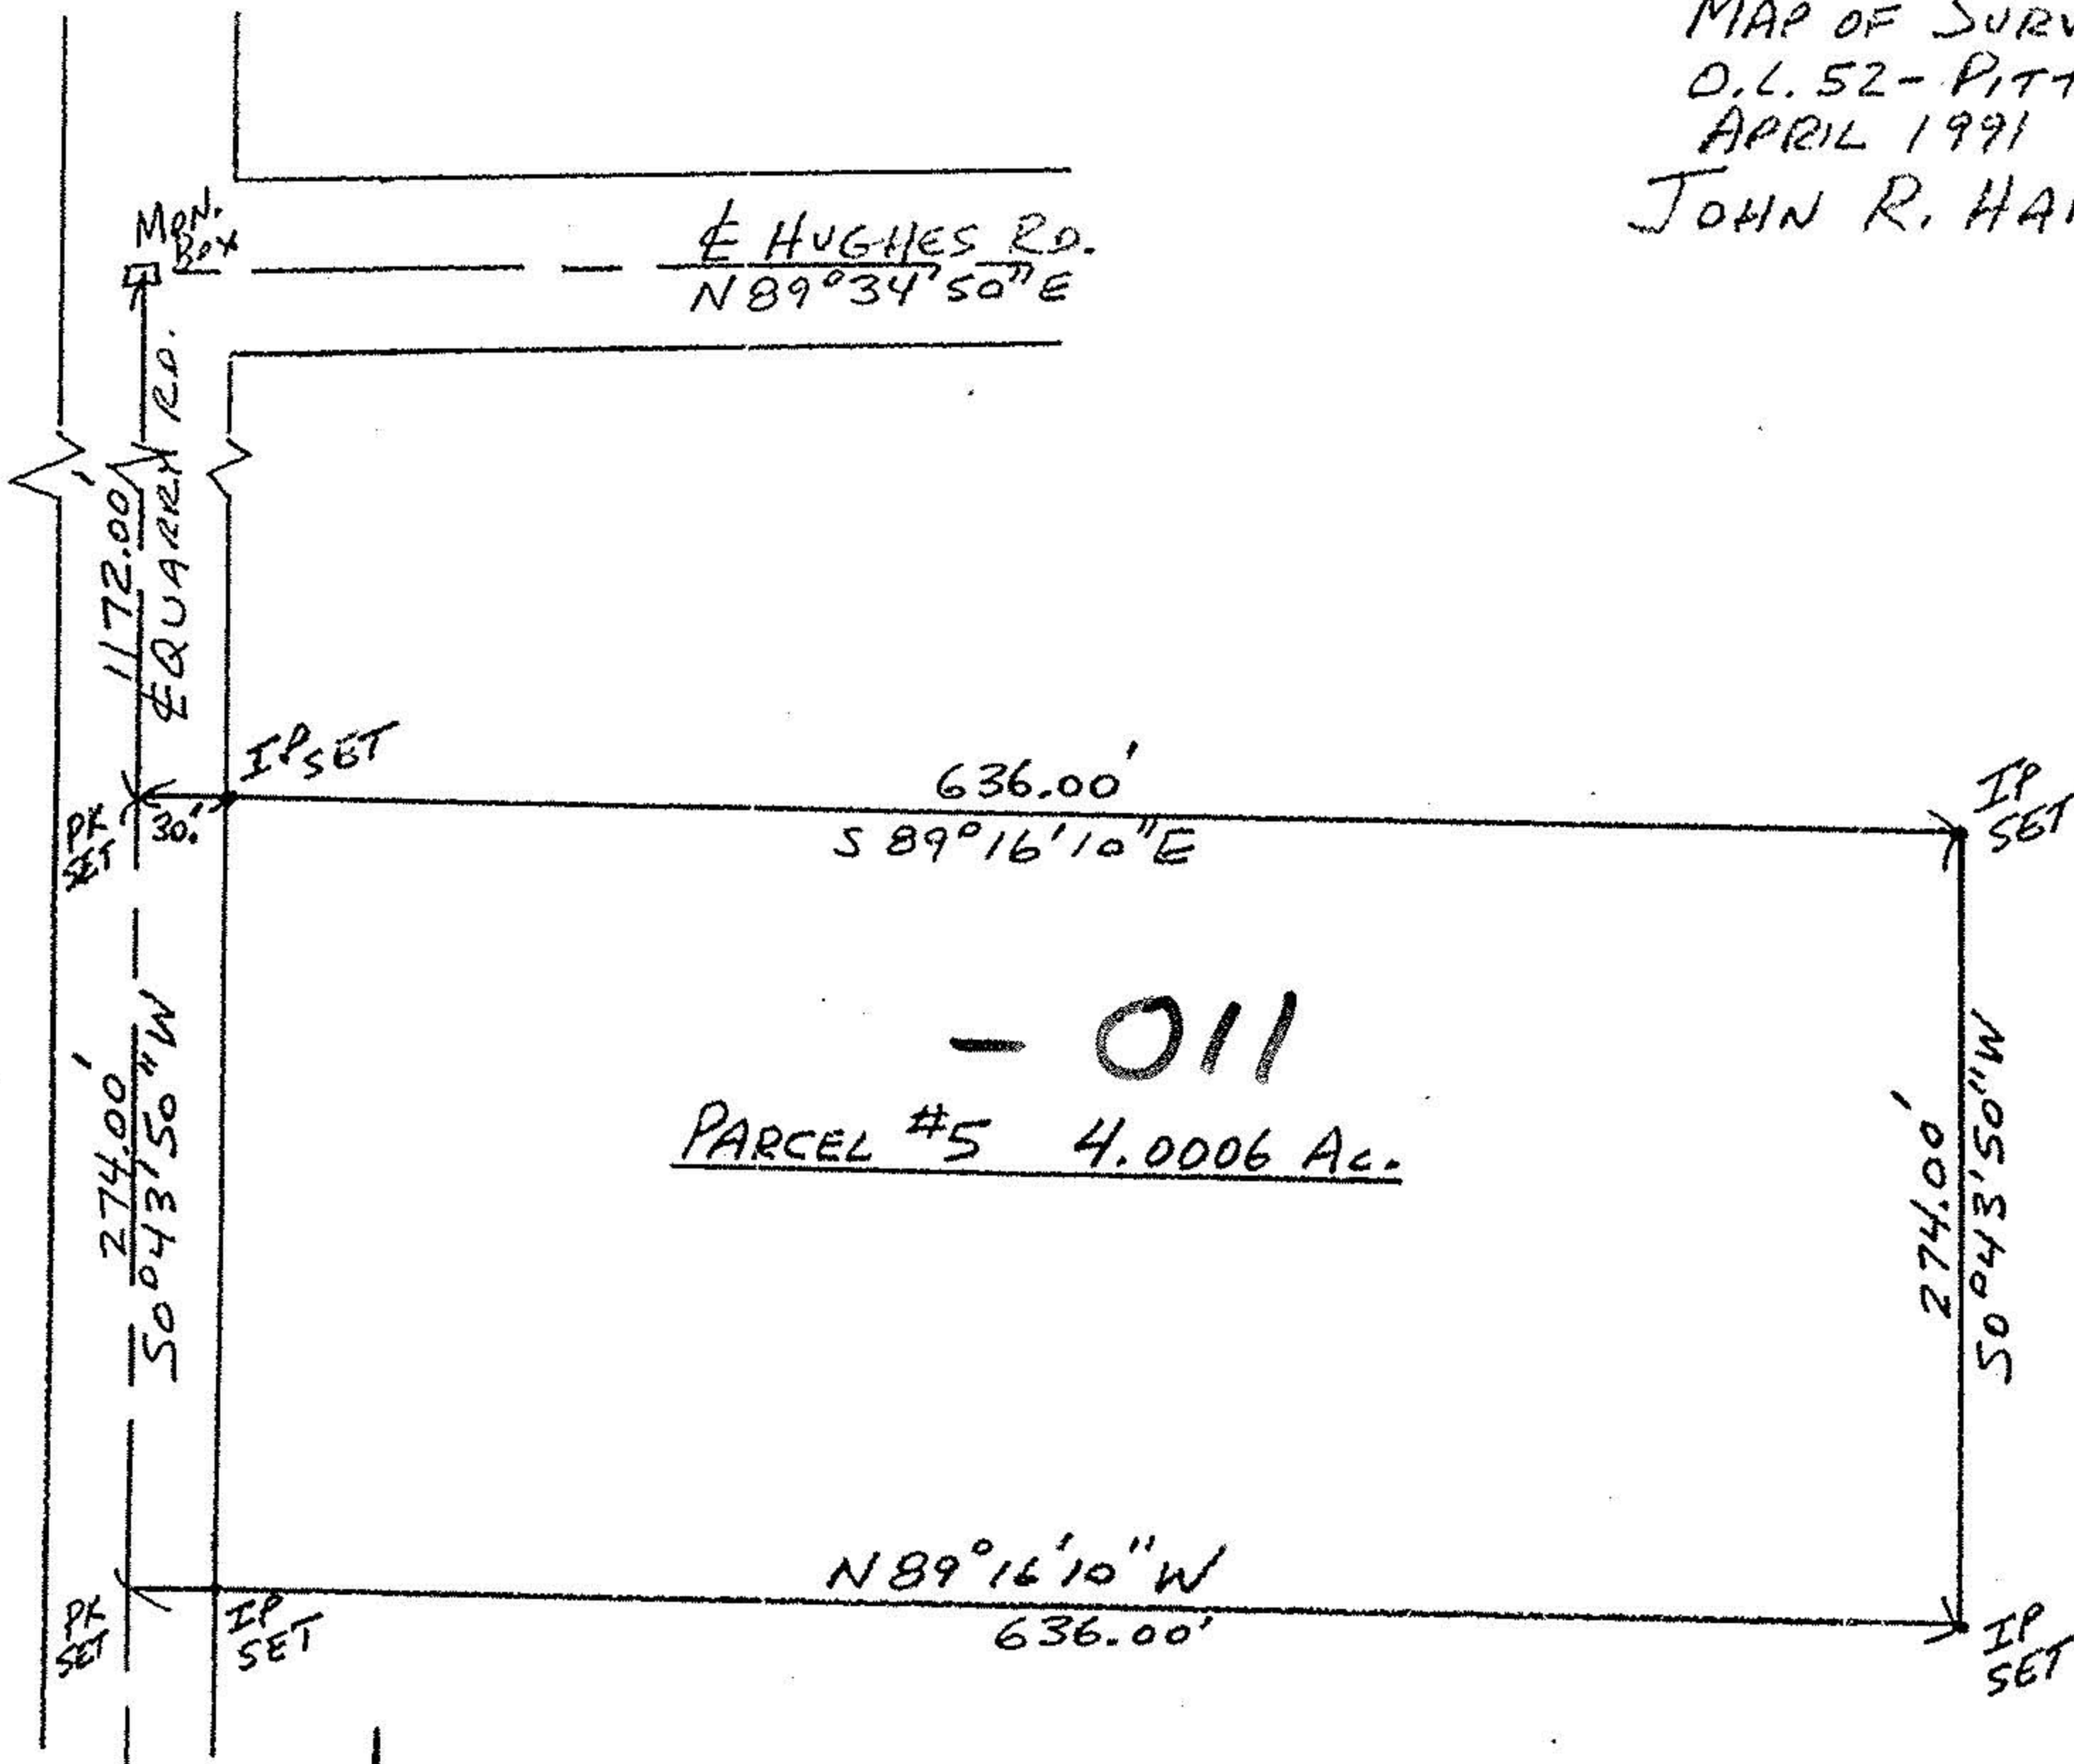

- 011
 PARCEL #5 4.0006 Ac.

ROBERT BRILL
 D.R. Vol. 377 P. 526
 46.02 Ac. ORIG.
 42.02 Ac. REM.

NORTH
 SCALE 1" = 100'

# 19346	APPROVED
	LORAIN CO.
	MAP DEPT.
	DATE 4-29-91
	PAGE 14-A
	CAROLYN BY FRANCIS
	VOID DATE # 19346