


14-A  
 19849  
 020  
 019  
 015  
 013  
 011

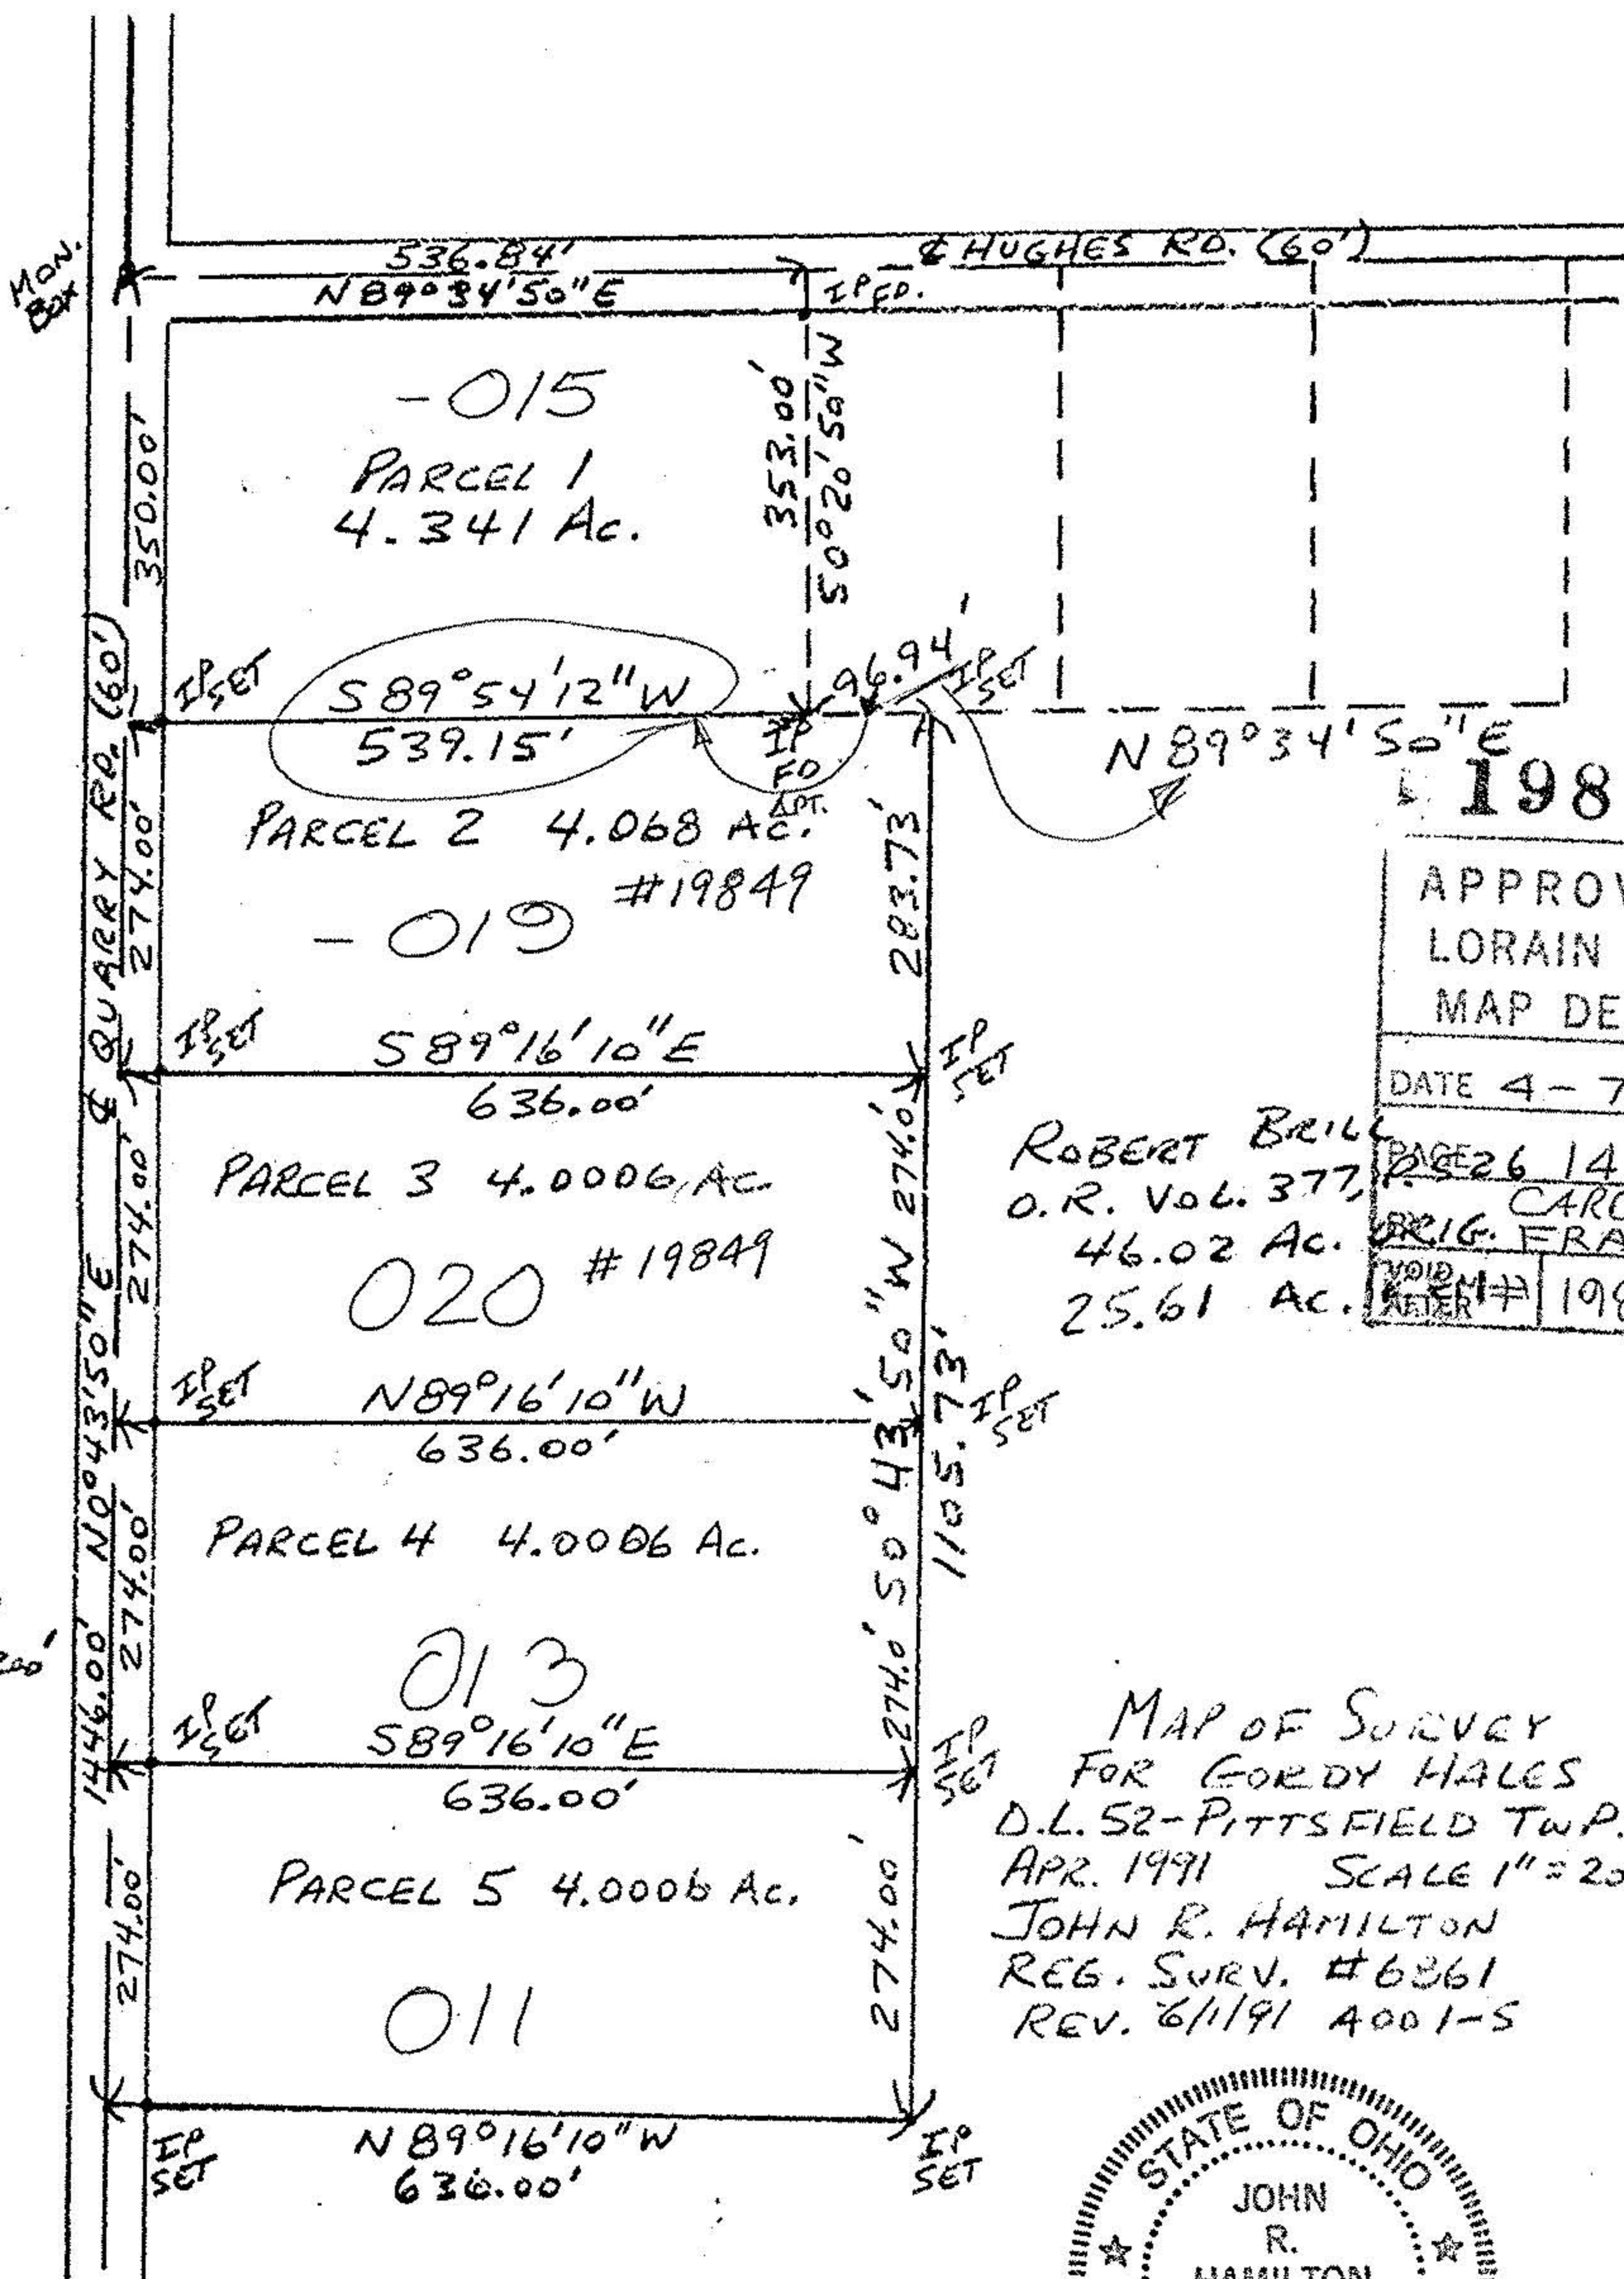

NORTH  
 SCALE 1" = 200'

**19849**

APPROVED  
 LORAIN CO.  
 MAP DEPT.

DATE 4-7-92

PAGE 26 14-A  
 CAROLYN  
 BRIG. FRANCIS

VOID AFTER # 19849

ROBERT BRILL  
 O.R. VOL. 377,  
 46.02 AC.  
 25.61 AC.

MAP OF SURVEY  
 FOR GORDY HALES  
 D.L. 52-PITTSFIELD TWP.  
 APR. 1991 SCALE 1" = 200'  
 JOHN R. HAMILTON  
 REG. SURV. #6861  
 REV. 6/1/91 A001-S

