
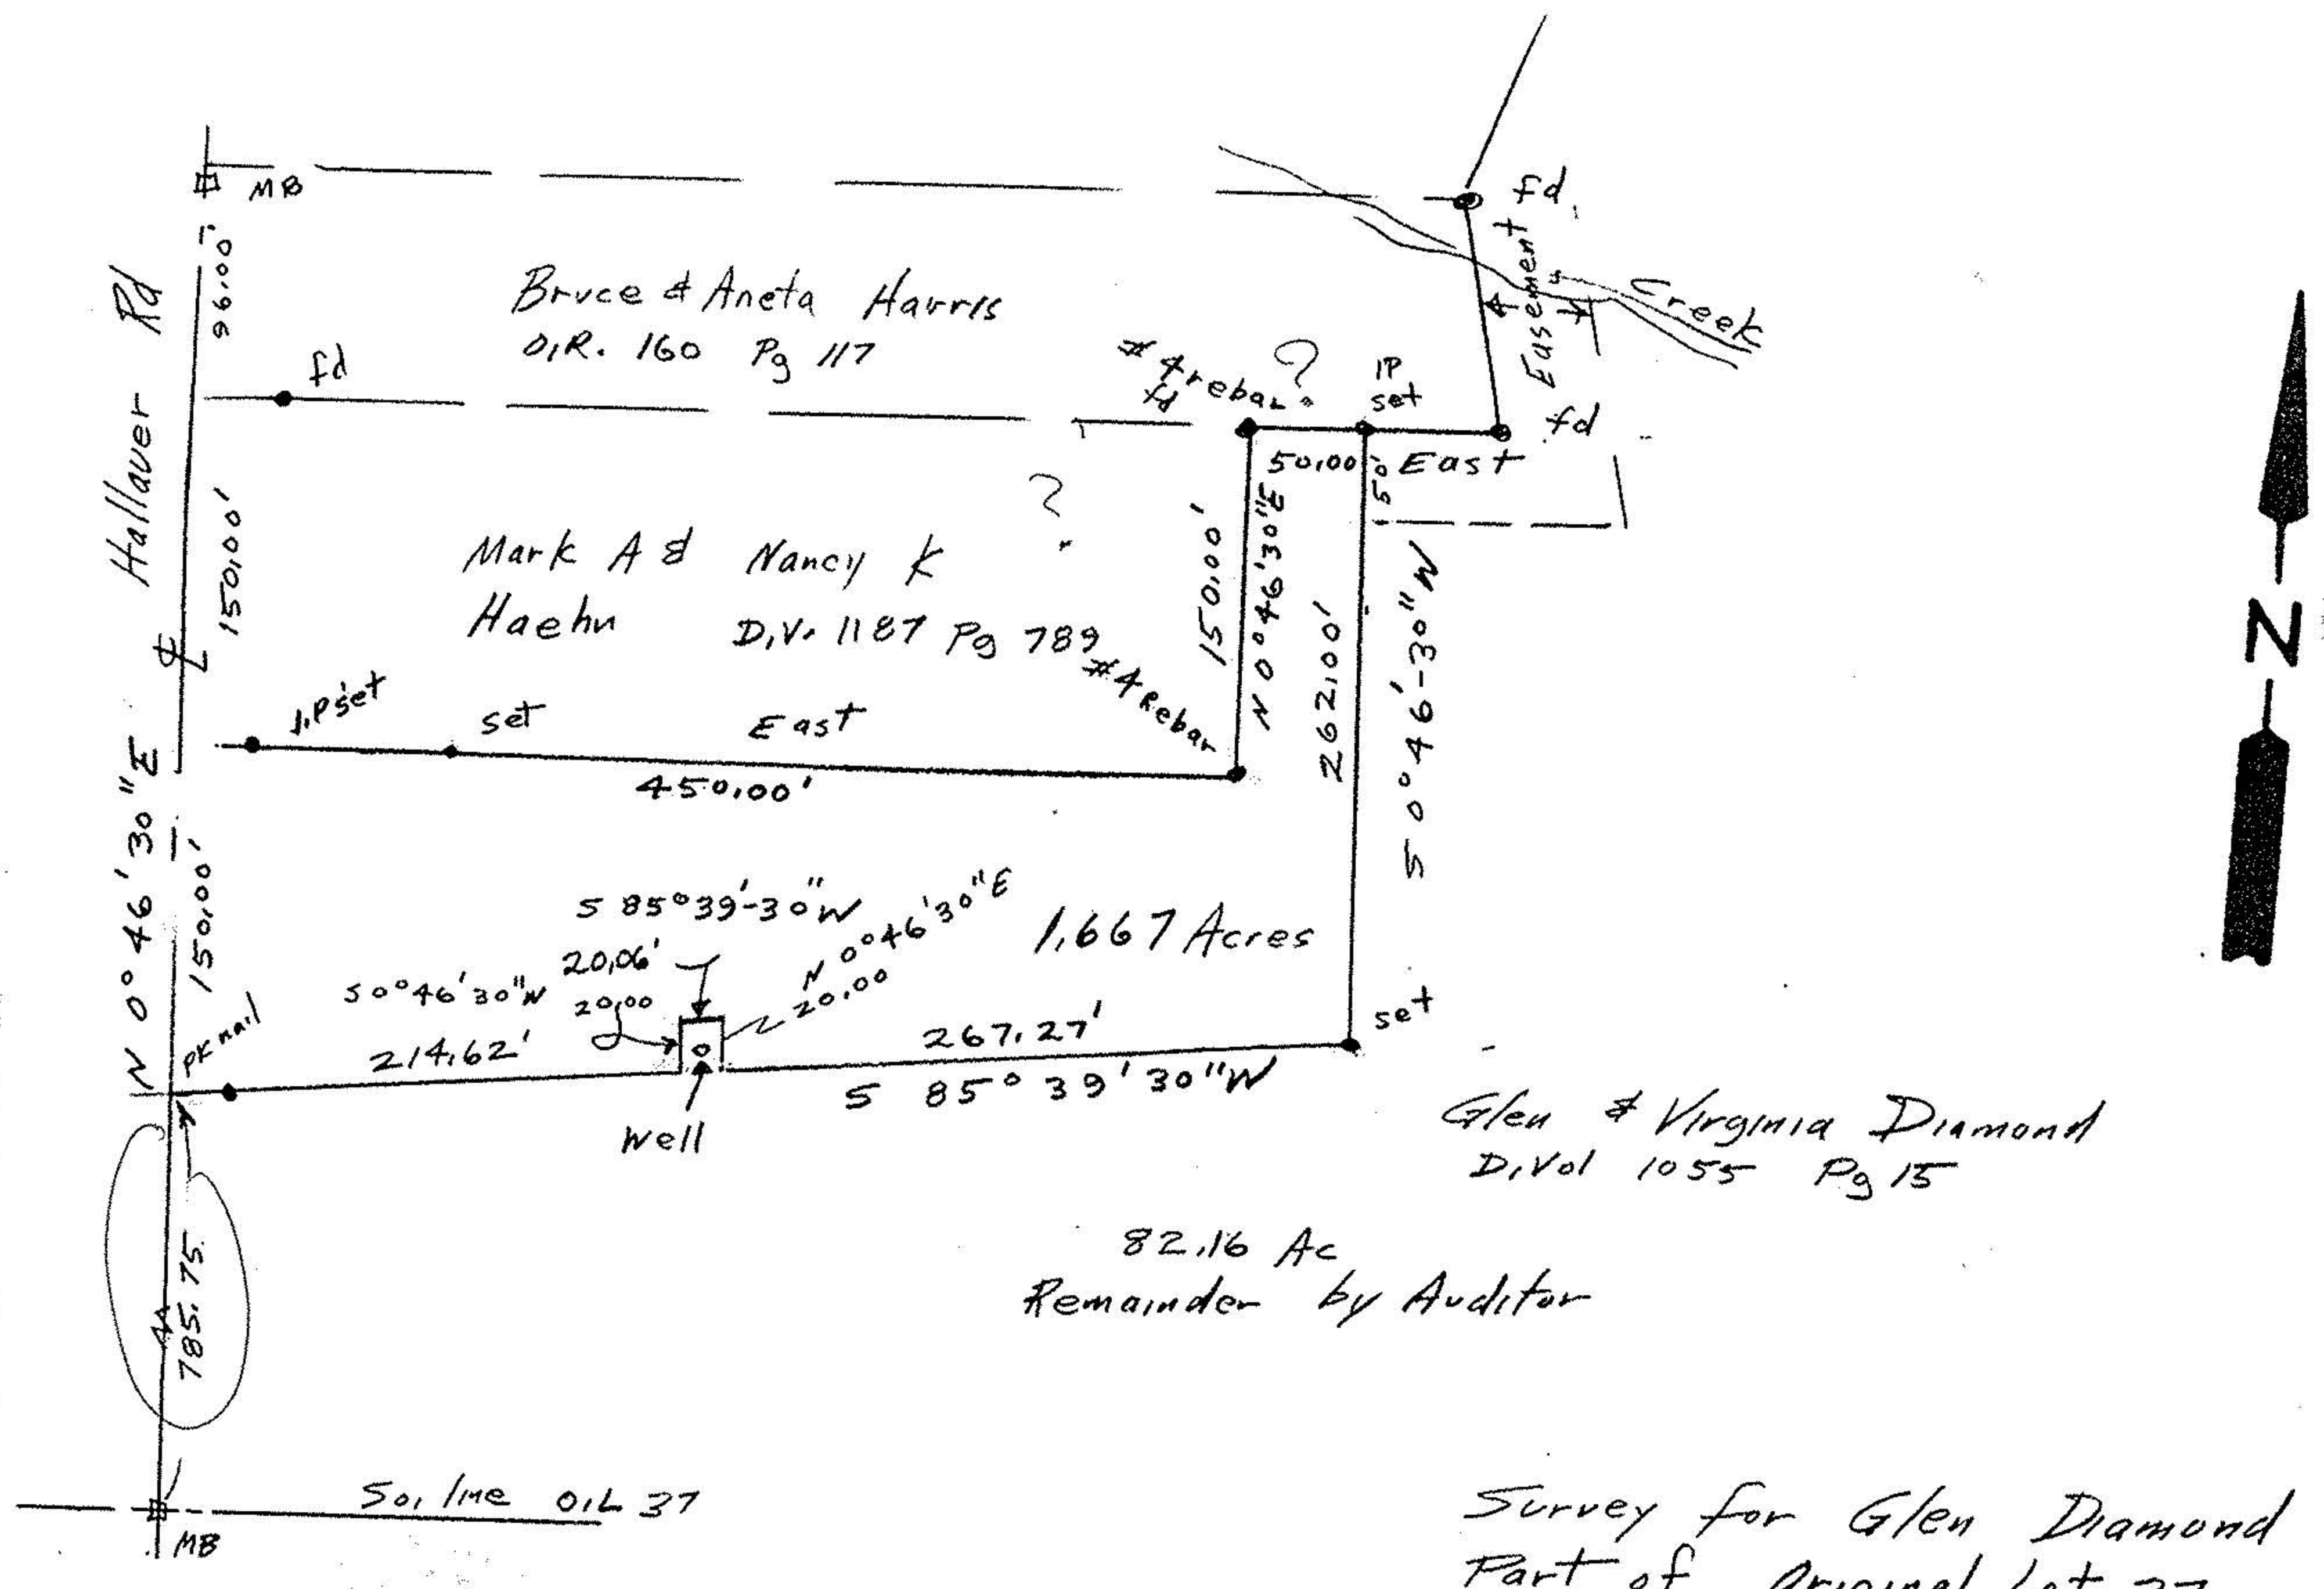


John Pozzwal  
Reg Surveyor  
5292

Survey for Glen Diamond  
Part of Original Lot 37  
Pittsfield Township  
Lorain County Ohio  
Scale 1"=100' Mar 21, 1990

#18949  
APPROVED  
LORAIN CO.  
MAP DEPT.  
DATE 5-14-90  
PAGE 14C  
BY CAROLYN  
FRANCIS  
VOID AFTER # 18949

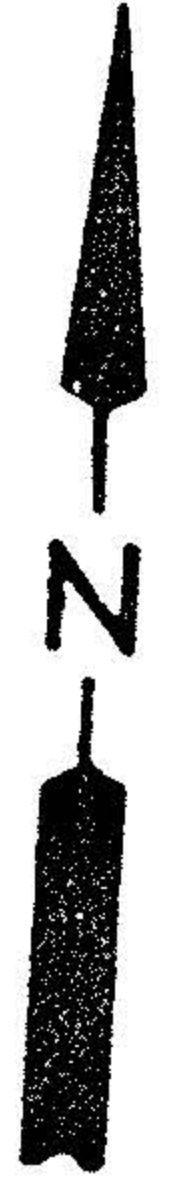

John Pozzwal  
Reg Surveyor  
5292

Survey for Glen Diamond  
Part of Original Lot 37  
Pittsfield Township  
Lorain County Ohio  
Scale 1"=100' Mar 21, 1990

