
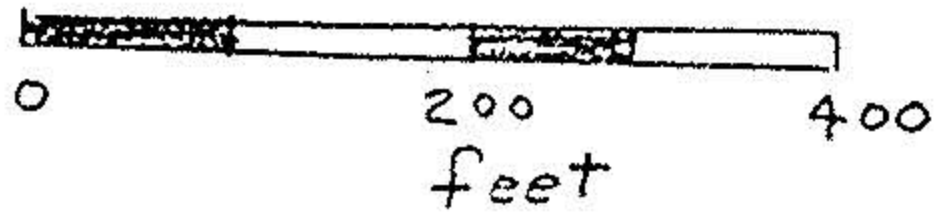


17-08-029-000-

#19013

17-D 17-08-029-000

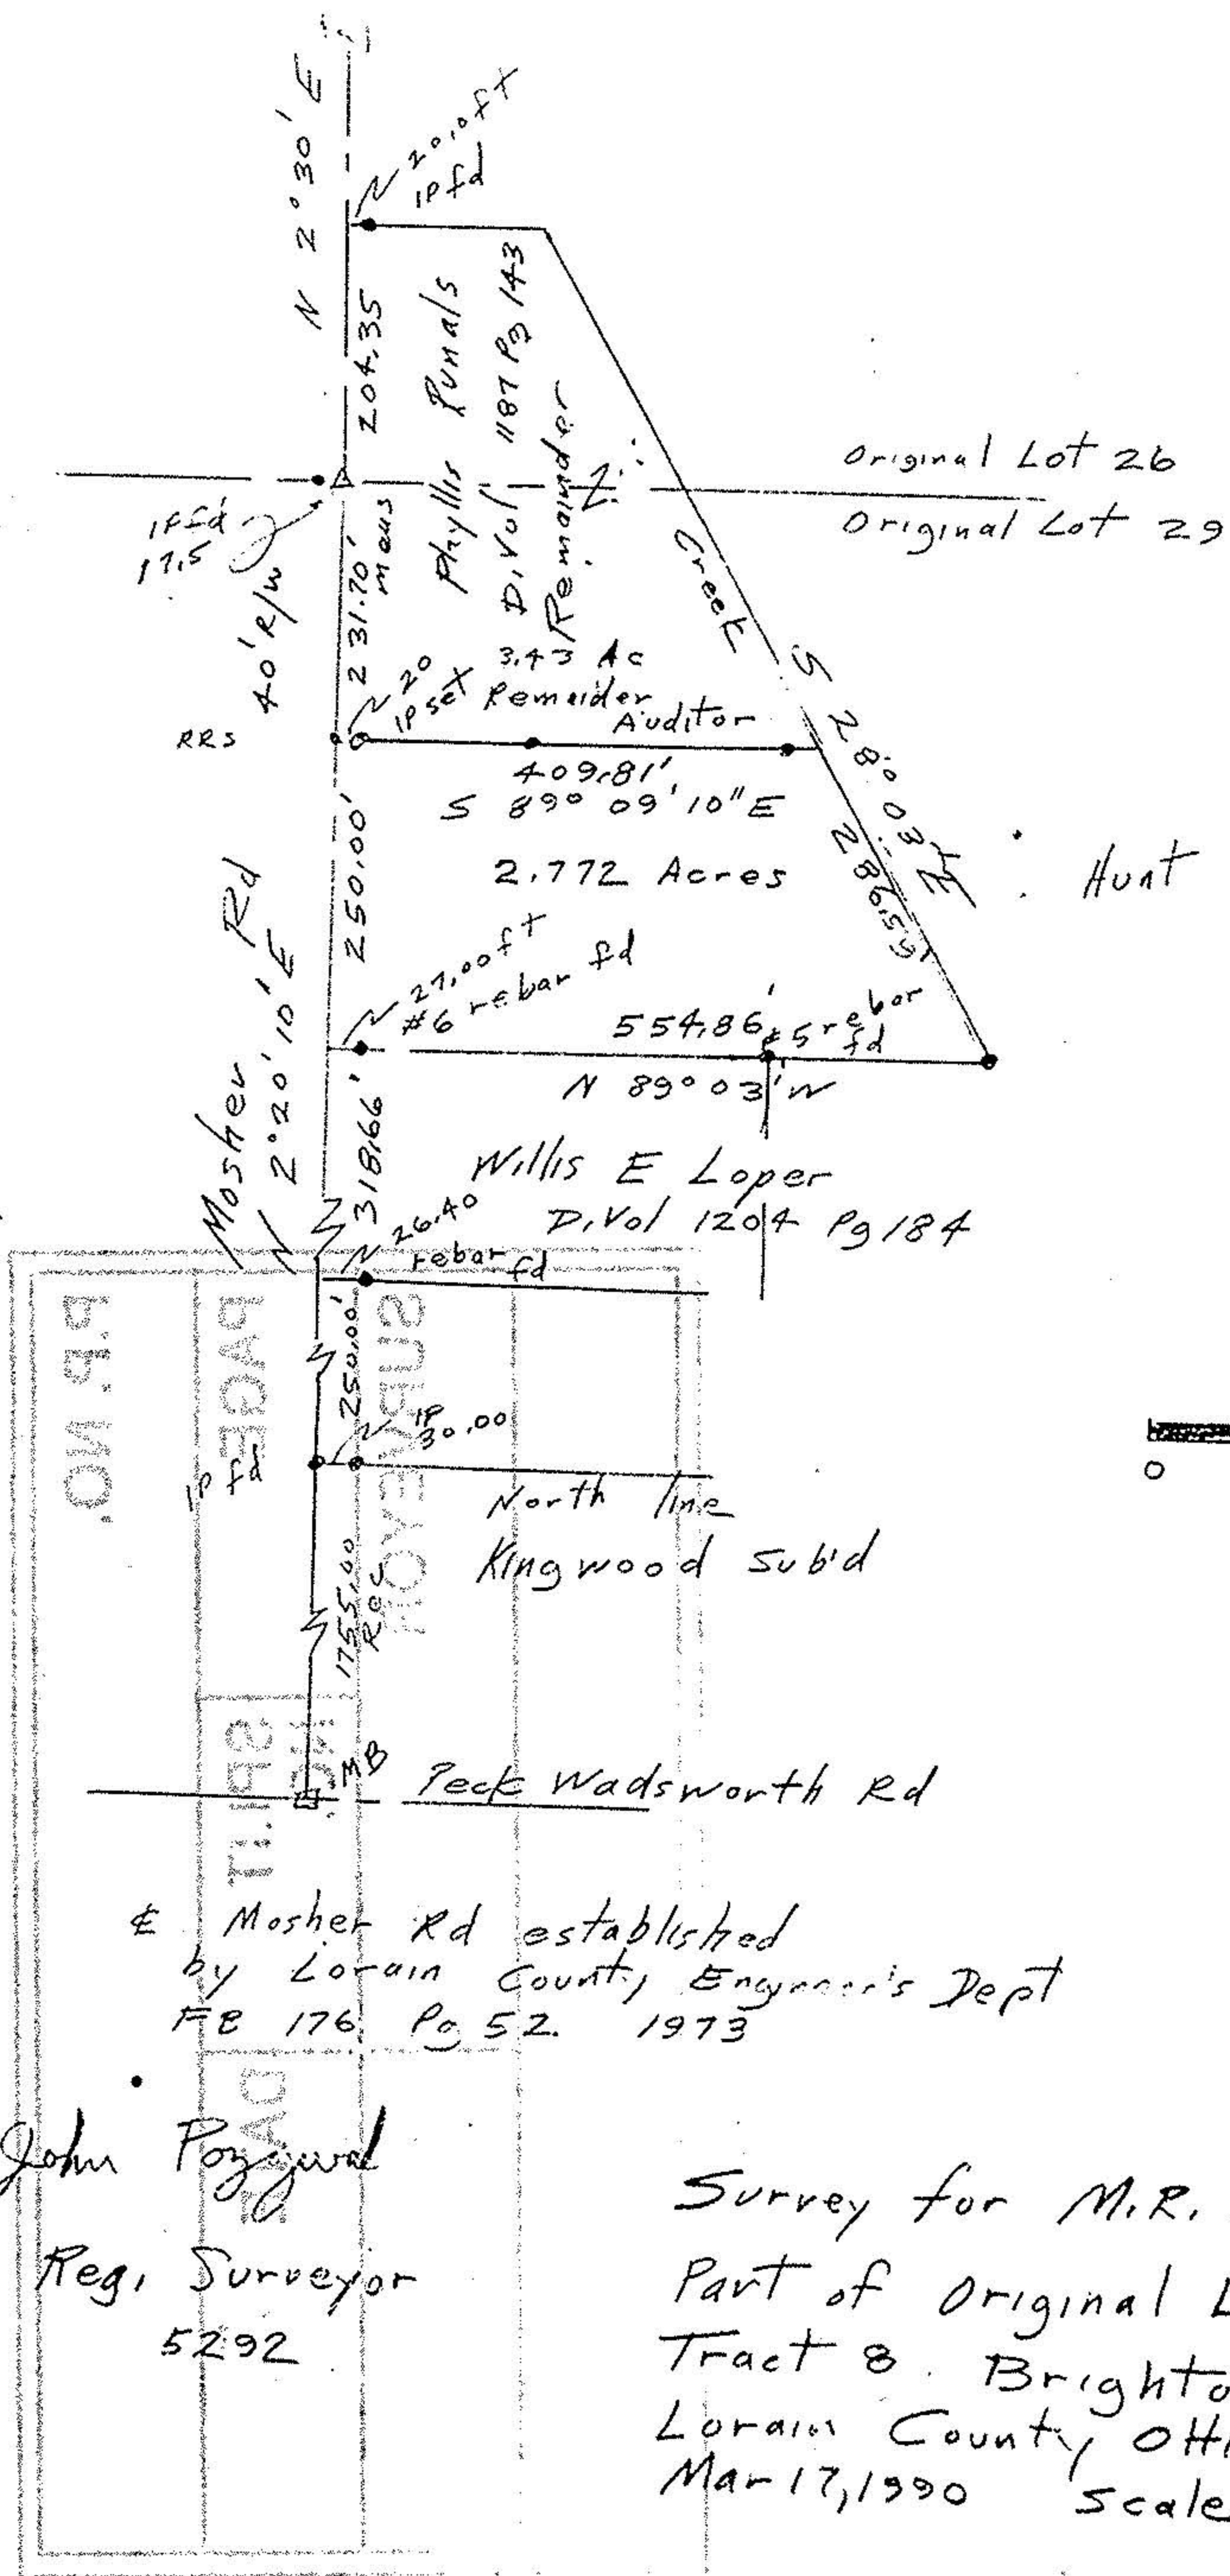

#19013

APPROVED  
LORAIN CO.  
MAP DEPT.

DATE 6-28-90

PAGE 17-08-029

CAROLYN  
BY FRANCIS

VOL # 19013  
AFTER

⊕ Moshier Rd established  
by Lorain County Engineer's Dept  
FB 176 Pg 52. 1973

John Pozzawal  
Reg. Surveyor  
5292

Survey for M.R. David  
Part of Original Lot 29  
Tract 8 Brighton Township  
Lorain County, Ohio  
Mar 17, 1990 Scale 1"=200'