

RETRACEMENT SURVEY


PREPARED FOR
DANIEL W. AND JUDY A. BUTLER
 SITUATED IN THE TOWNSHIP OF BRIGHTON, COUNTY OF LORAIN,
 STATE OF OHIO, AND BEING KNOWN AS PART OF ORIGINAL
 BRIGHTON TOWNSHIP LOT NO. 28, TRACT #

SURVEYOR'S STATEMENT

DISTANCES ARE EXPRESSED IN FEET AND DECIMAL PARTS
 THEREOF. BEARINGS ARE TO AN ASSUMED MERIDIAN AND
 ARE USED TO INDICATE ANGLES ONLY. PERMANENT
 MONUMENTS WERE FOUND OR SET AS INDICATED HEREON.
 ALL OF WHICH I DECLARE TO BE CORRECT TO THE BEST OF
 MY ABILITIES AND BELIEF.

Thomas M. Snezek
 THOMAS M. SNEZEK, P.S. NO. 7051
 DATE: 4-8-16

FILE: 9604

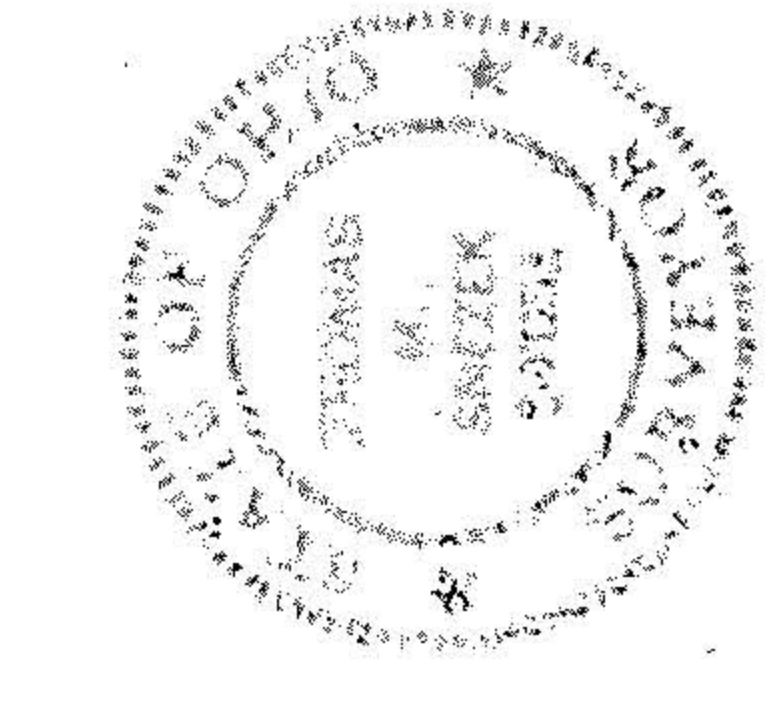

ROAD QUARRY

ROAD WADSWORTH

ROAD VALLEY DE

ROAD MADSWORTH RD. 60'