


THORNWOOD DRIVE 60'

MEADOW LANE 60'
500.74'

275.74'

10
11
12

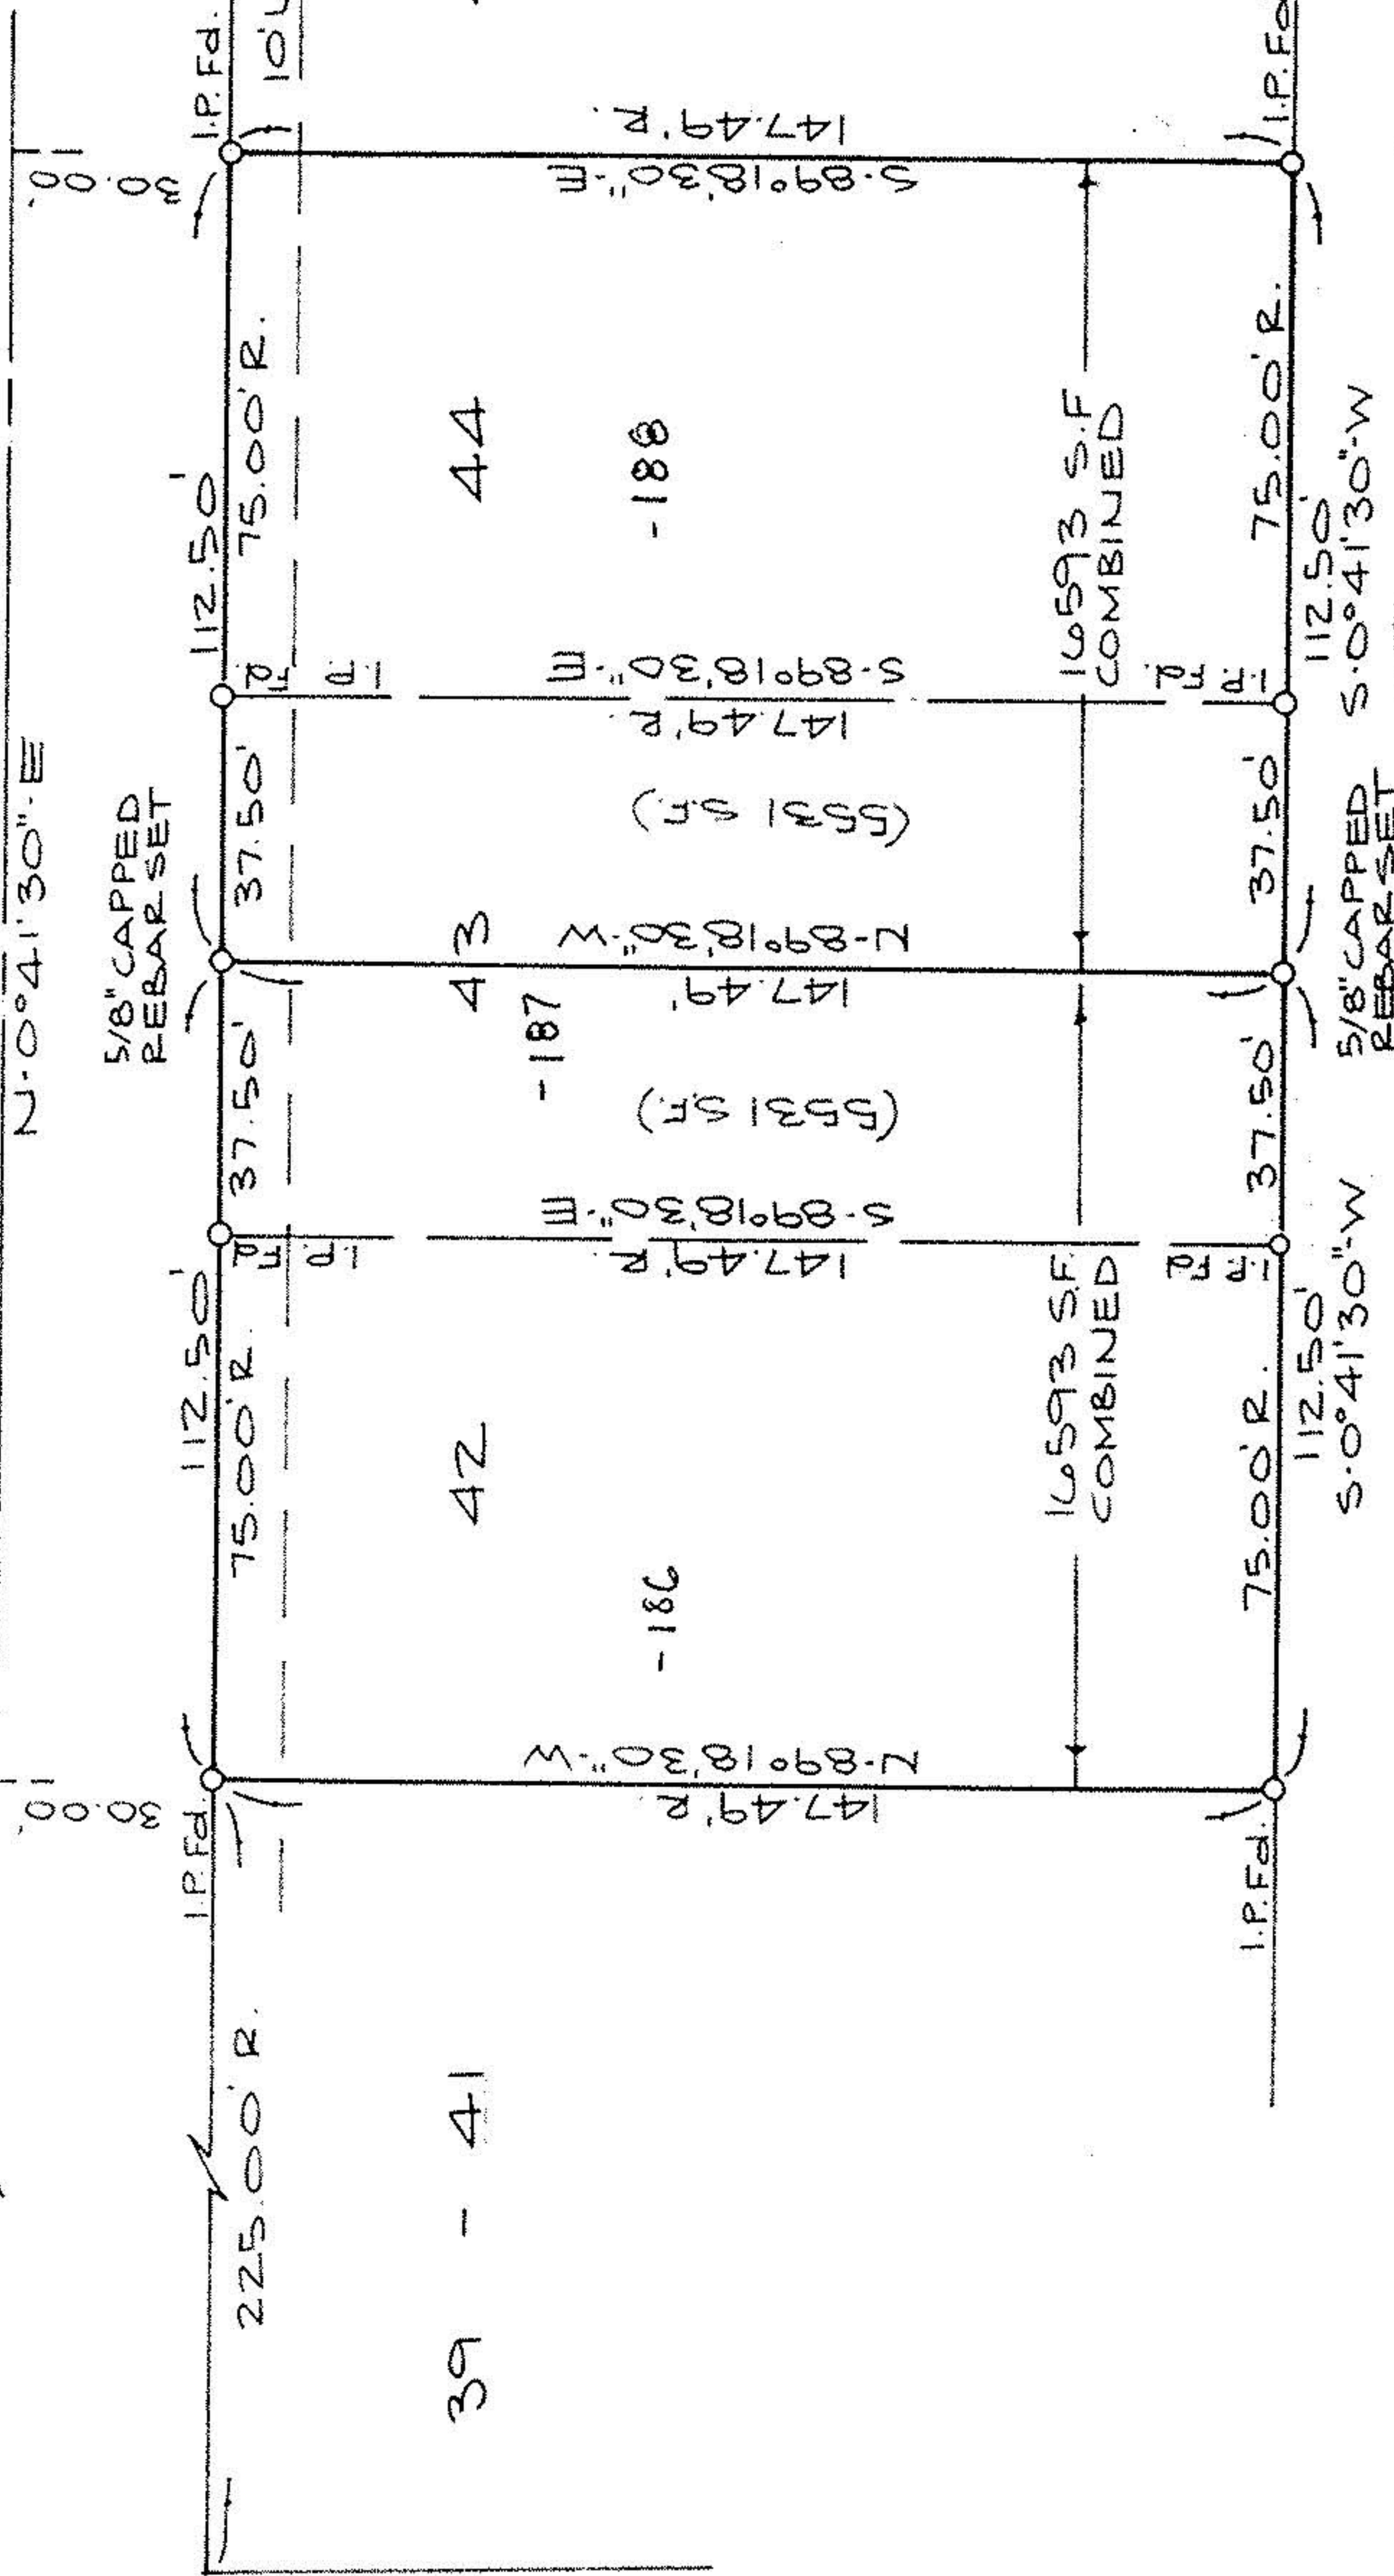

NORTH




PRINTED

APR 23 1996

KS ASSOCIATES, INC.

SURVEY MAP

SUBLOT No. 43 IN
THE MEADOWS SUBD. No. 3
P.V. 56 P. 66
VILLAGE OF WELLINGTON
COUNTY OF LORAIN STATE OF OHIO

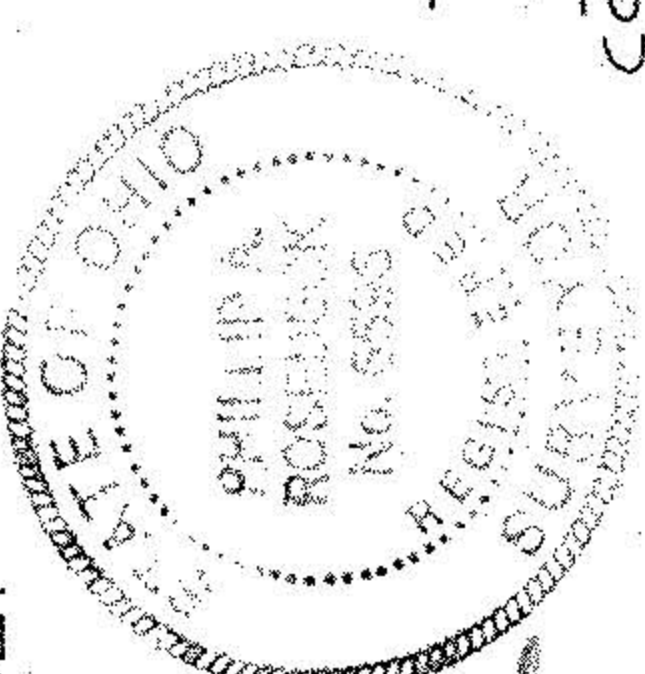

Phillip A. Rosebeck

PHIL A. ROSEBECK
REG. SURVEYOR No. 6696

PREPARED BY:
KS ASSOCIATES INC.
ENGINEER SURVEYORS
4-23-96

94571-543