


THORNWOOD DRIVE 60'

MEADOW LANE 60'  
500.74'

275.74'

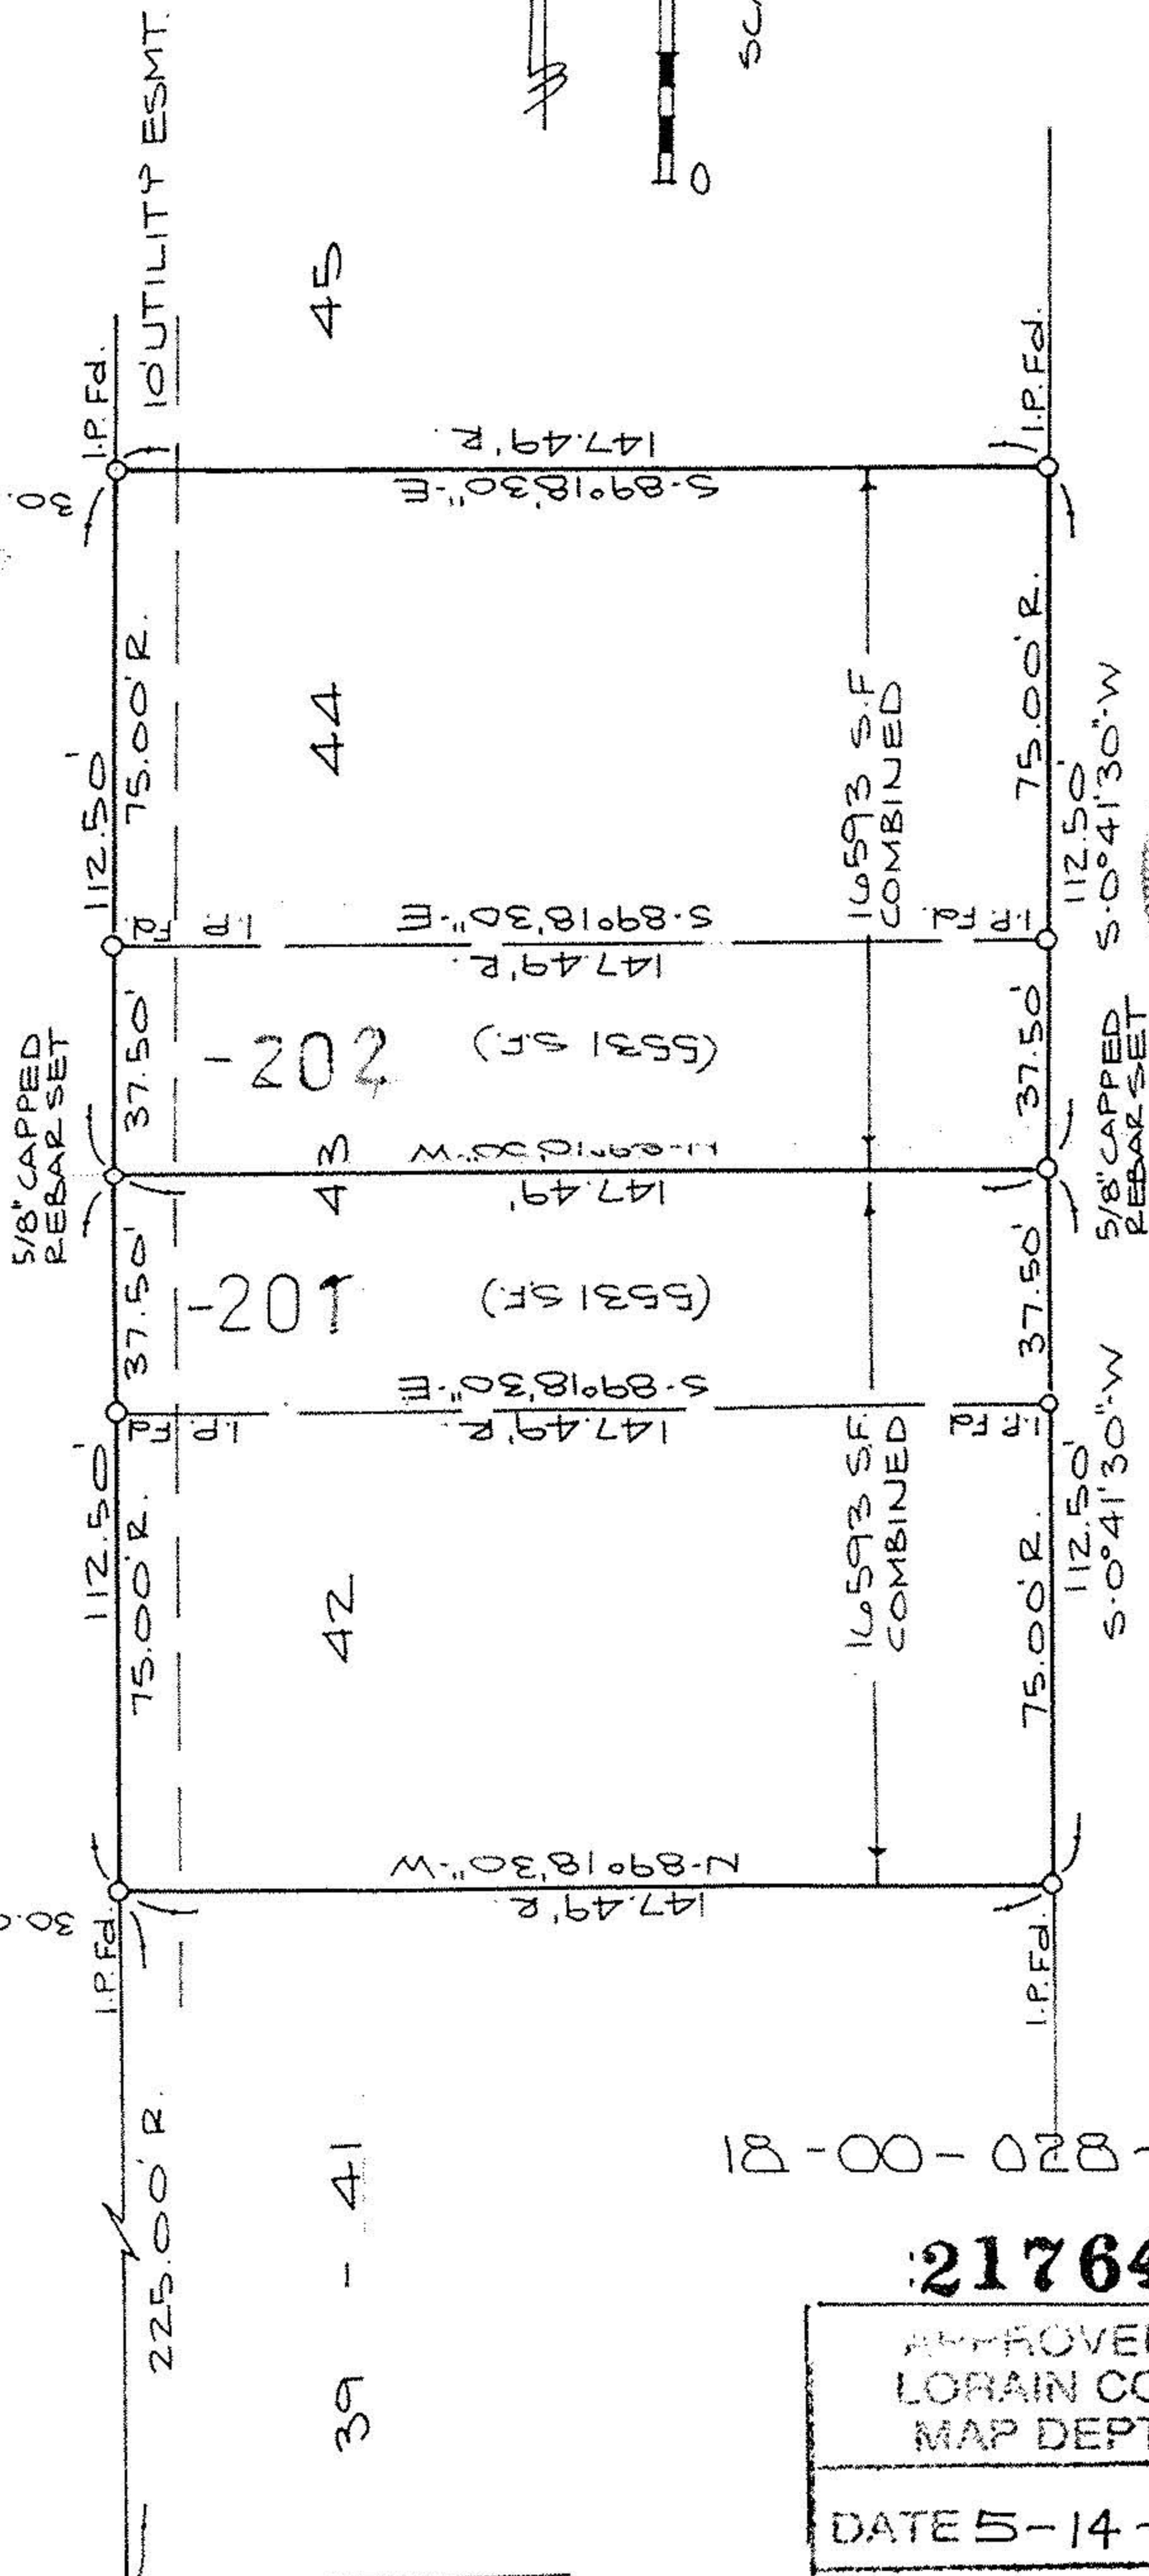

NORTH

SCALE: 1" = 40'

PRINTED

APR 26 1996

SURVEY MAP

SUBLOT NO. 43 IN


THE MEADOWS SUBD. No. 3

P.V. 56 P. 66

VILLAGE OF WELLINGTON

COUNTY OF LORAIN STATE OF OHIO

94-571-543

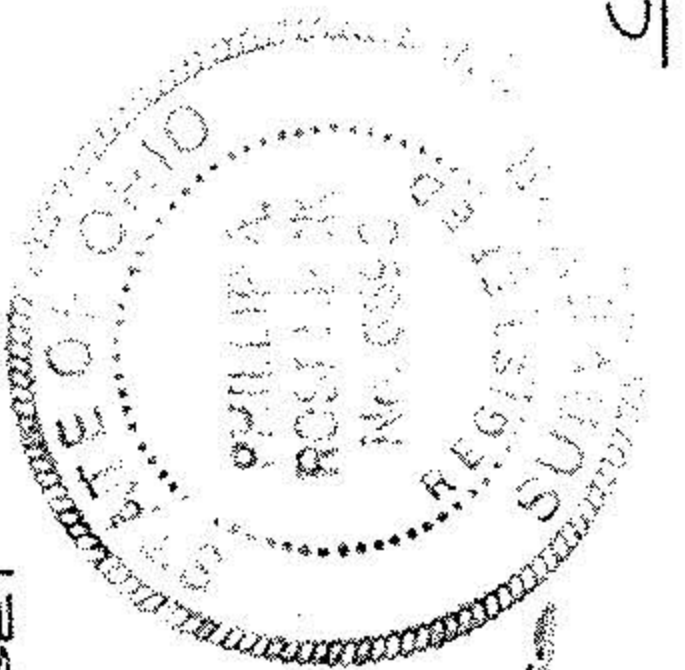

*Phillip A. Rosebeck*  
PHILIP A. ROSEBECK  
REG. SURVEYOR No. 6696

PREPARED BY:

KS ASSOCIATES INC.

ENGINEER SURVEYORS

4-23-96

21764

APPROVED  
LORAIN CO.  
MAP DEPT

DATE 5-14-96

PAGE 18-00-028-B

BY CAROLYN  
FRANCIS

# 21764

18-00-028-101

39 - 41

42

43

44

45

5/8" CAPPED  
REBAR SET

5/8" CAPPED  
REBAR SET

16,593 S.F.  
COMBINED

16,593 S.F.  
COMBINED

102

202

S-89°18'30" E  
147.49' R

S-89°18'30" E  
147.49' R

S-89°18'30" E  
147.49' R

N-89°18'30" W  
147.49' R

N-89°18'30" W  
147.49' R

S-89°18'30" E  
147.49' R

S-89°18'30" E  
147.49' R

S-89°18'30" E  
147.49' R

I.P. Pd.

I.P. Pd.

