

PLAT OF SURVEY

PROJECT # 7504B
DATE APRIL 1975

STATE OF OHIO
COUNTY OF ~~MEDINA~~ LORAIN

TOWNSHIP VILLAGE, ~~CH~~ WELLINGTON LOT 28 TRACT
SUBDIVISION WADSWORTH
PROPERTY OWNER
JOSEPH A. & SHARON L. FARAGO
A. B. & BLANCHE JONES

18-00-028-D
108

#14879

APPROVED LORAIN CO. MAP DEPT.
DATE 11-5-82
PAGE 18-00-028-D
BY C. FRANKIS
VOID AFTER

ELM STREET

FARAGO L
I.P. F.D. & USED


A. B. & B. JONES
0.8839 AC.

TOTAL 3 1/4 AC.

JOSEPH A. & SHARON
FARAGO
0.2885 AC.

UNION STREET

● IRON PIN F.D.
○ IRON PIN SET
SCALE: 1" = 60'

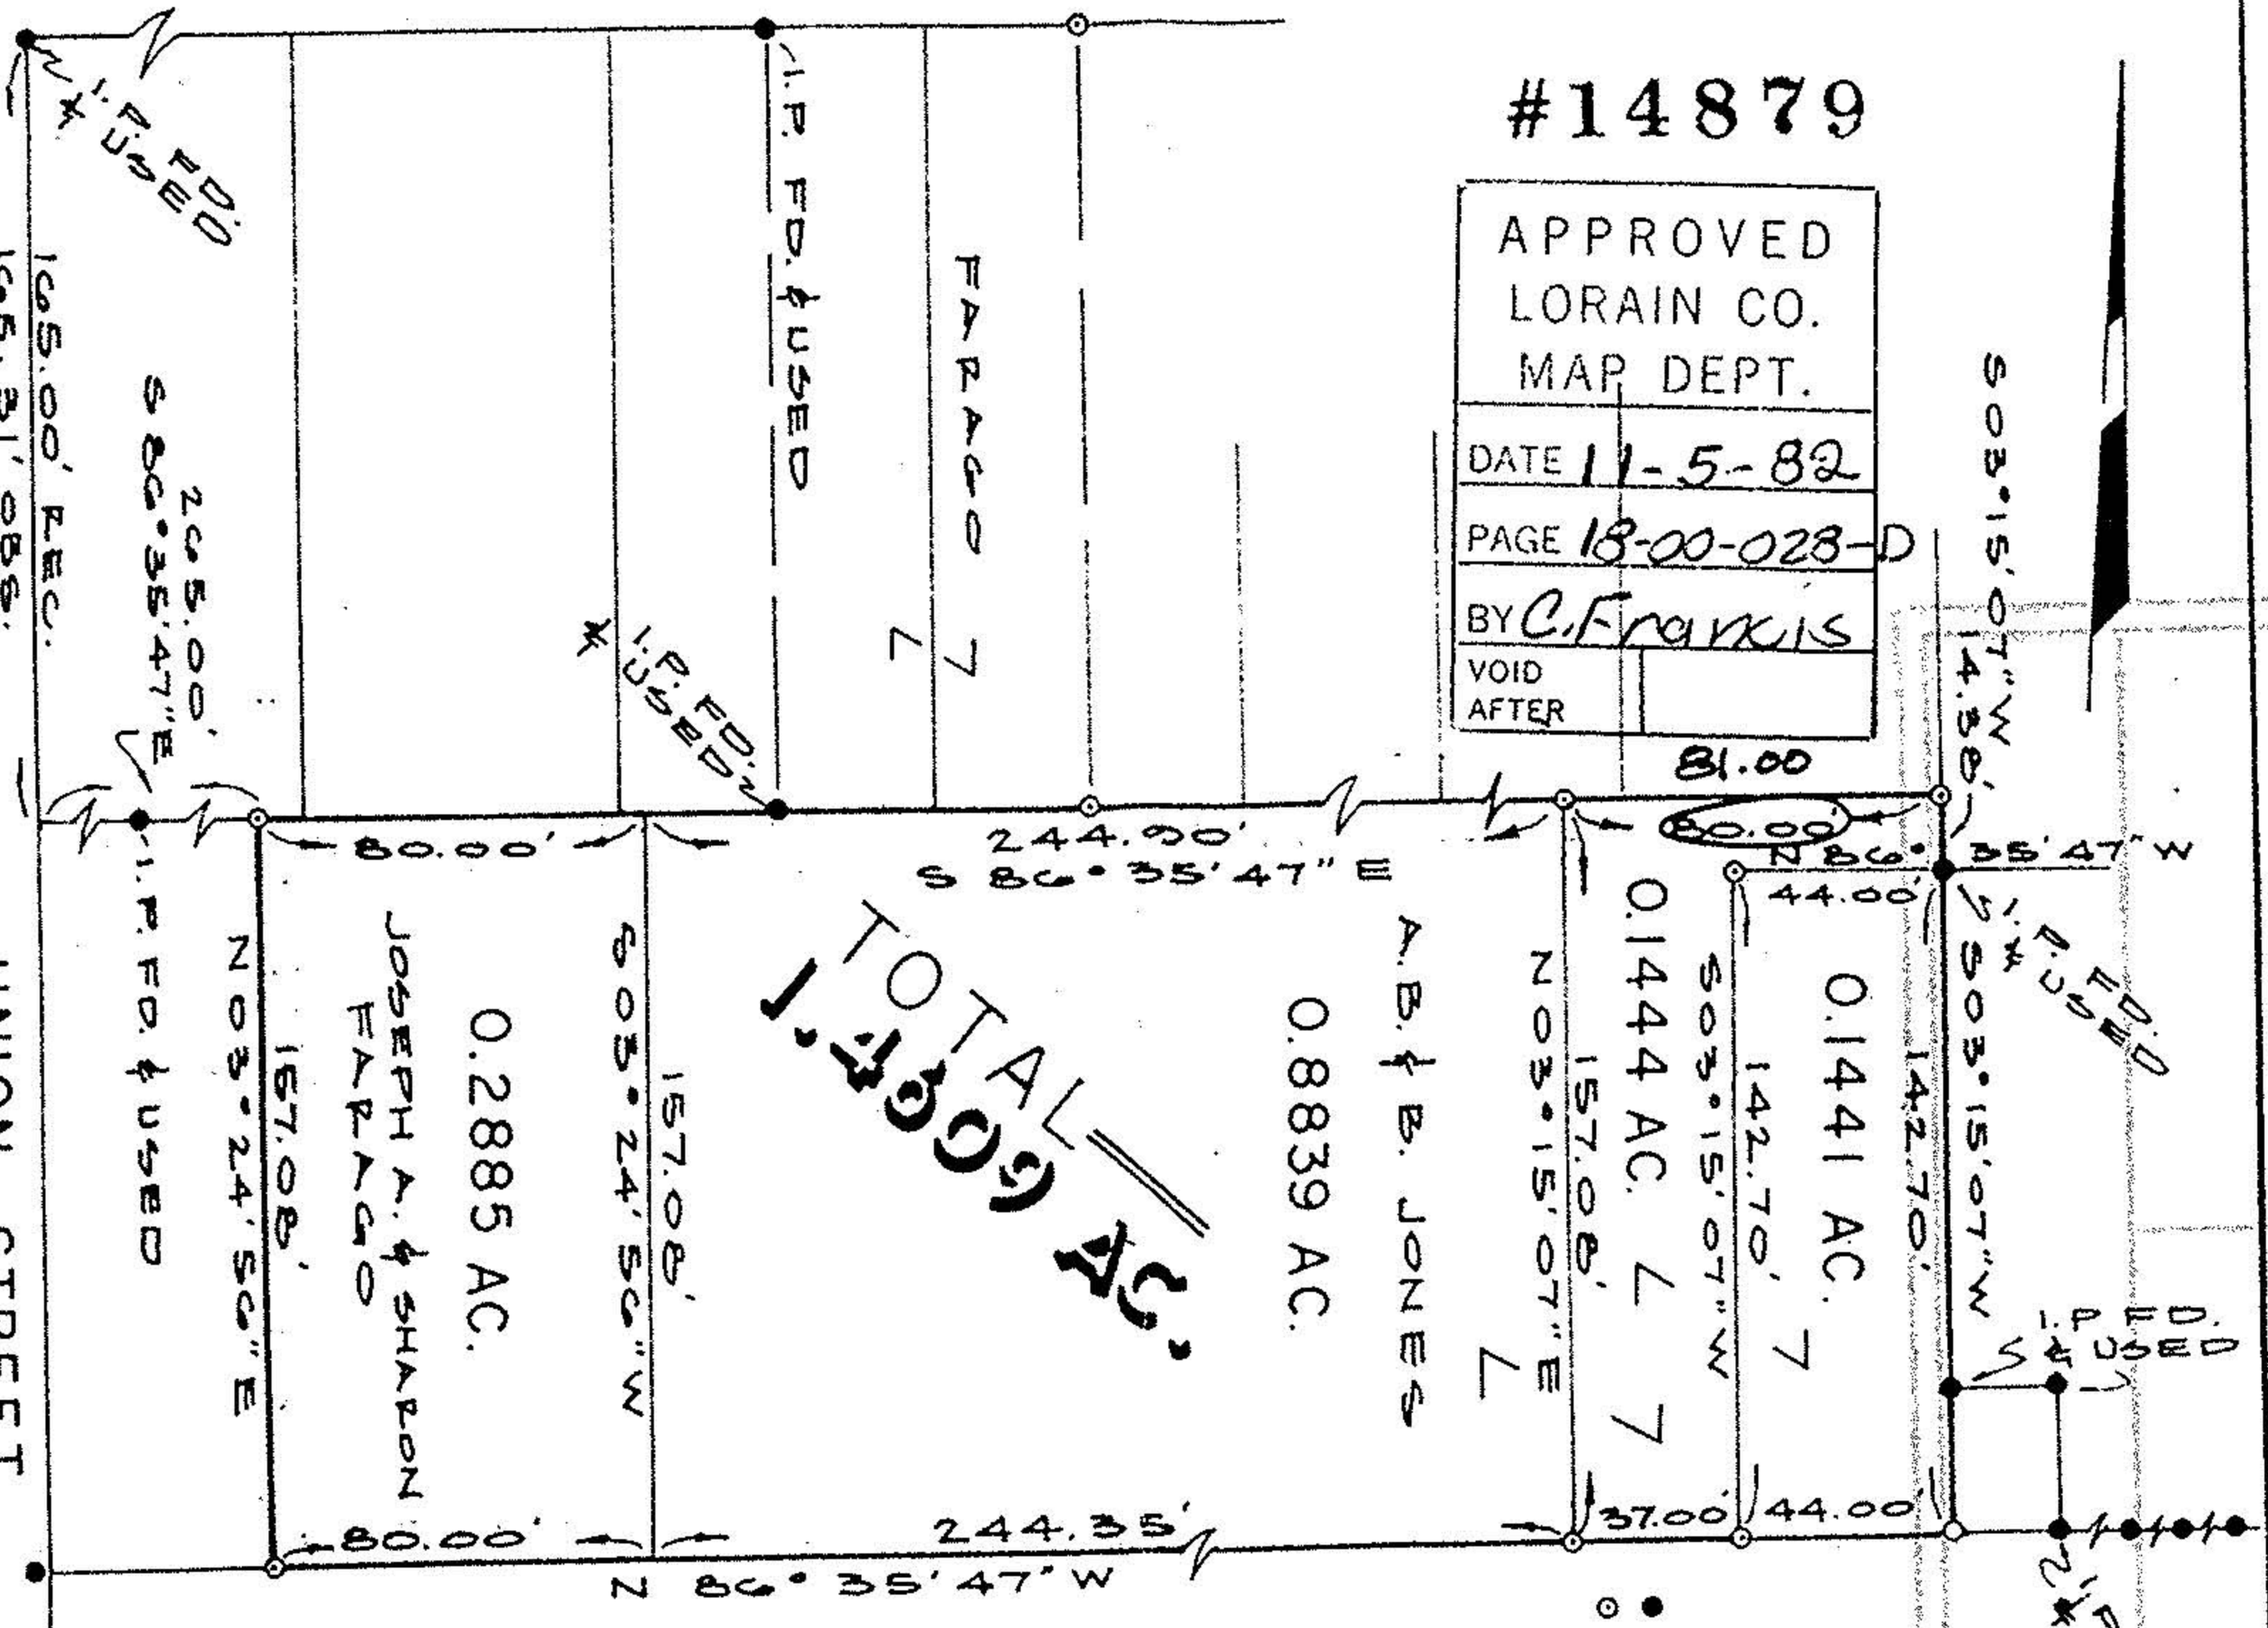

ENGINEERS SURVEYORS
SANTE ASSOCIATES

