


Map of Part of O.L. 31 Wellington Twp. Lorain Co. Ohio  
 Scale 1" 100' April 14, 1978  
 By Arnold F. Koepp Reg. Surveyor No. 4306  
 Map revised June 14, 1988

18-00-031-000-004  
 -04

18091

18-B

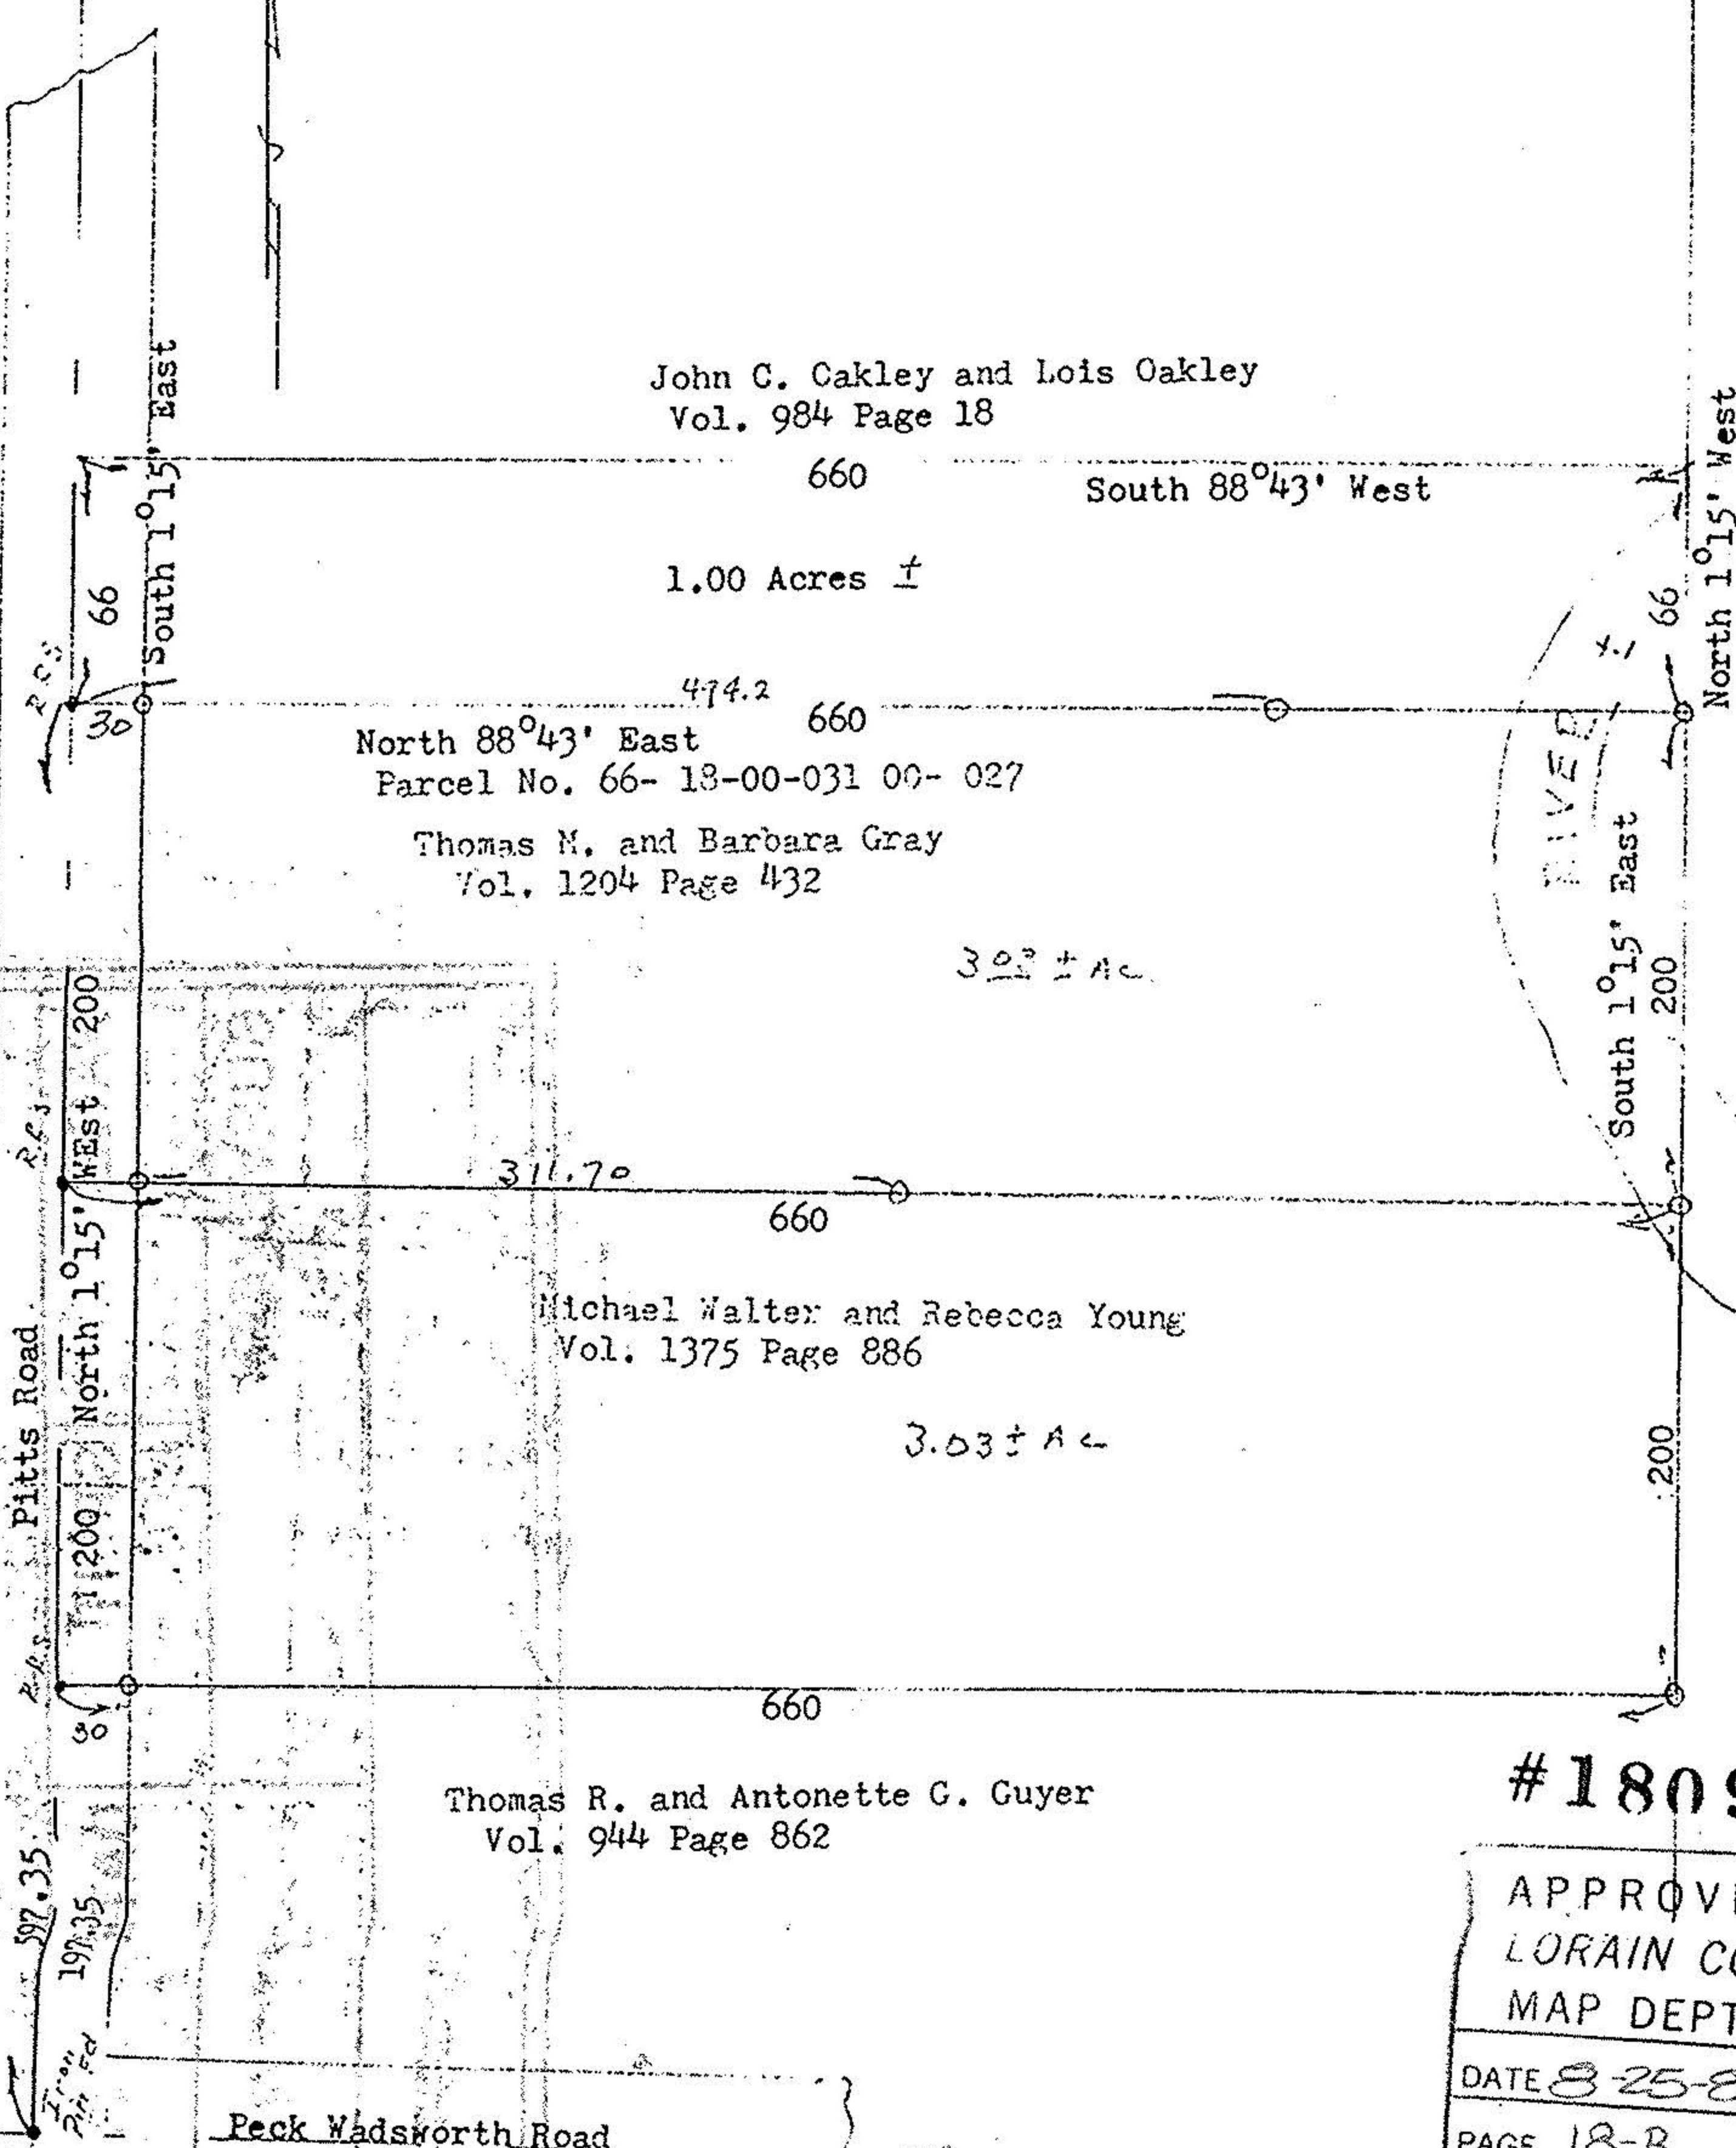

John C. Oakley and Lois Oakley  
 Vol. 984 Page 18

Thomas M. and Barbara Gray  
 Vol. 1204 Page 432

Michael Walter and Rebecca Young  
 Vol. 1375 Page 886

Thomas R. and Antonette G. Guyer  
 Vol. 944 Page 862

Vivian Ward  
 Vol. 839 Page 388

#18091

APPROVED LORAIN CO. MAP DEPT.	
DATE	8-25-88
PAGE	18-B
BY	C. Francis
VOID AFTER #	18091