


# 17802

18-00-037-000

WILLIAM B. BARTON  
Reg. Land Surveyor No. 4438  
188 PARKWOOD AVENUE  
AVON LAKE, OHIO 44012  
TELEPHONE (216) 933-6662

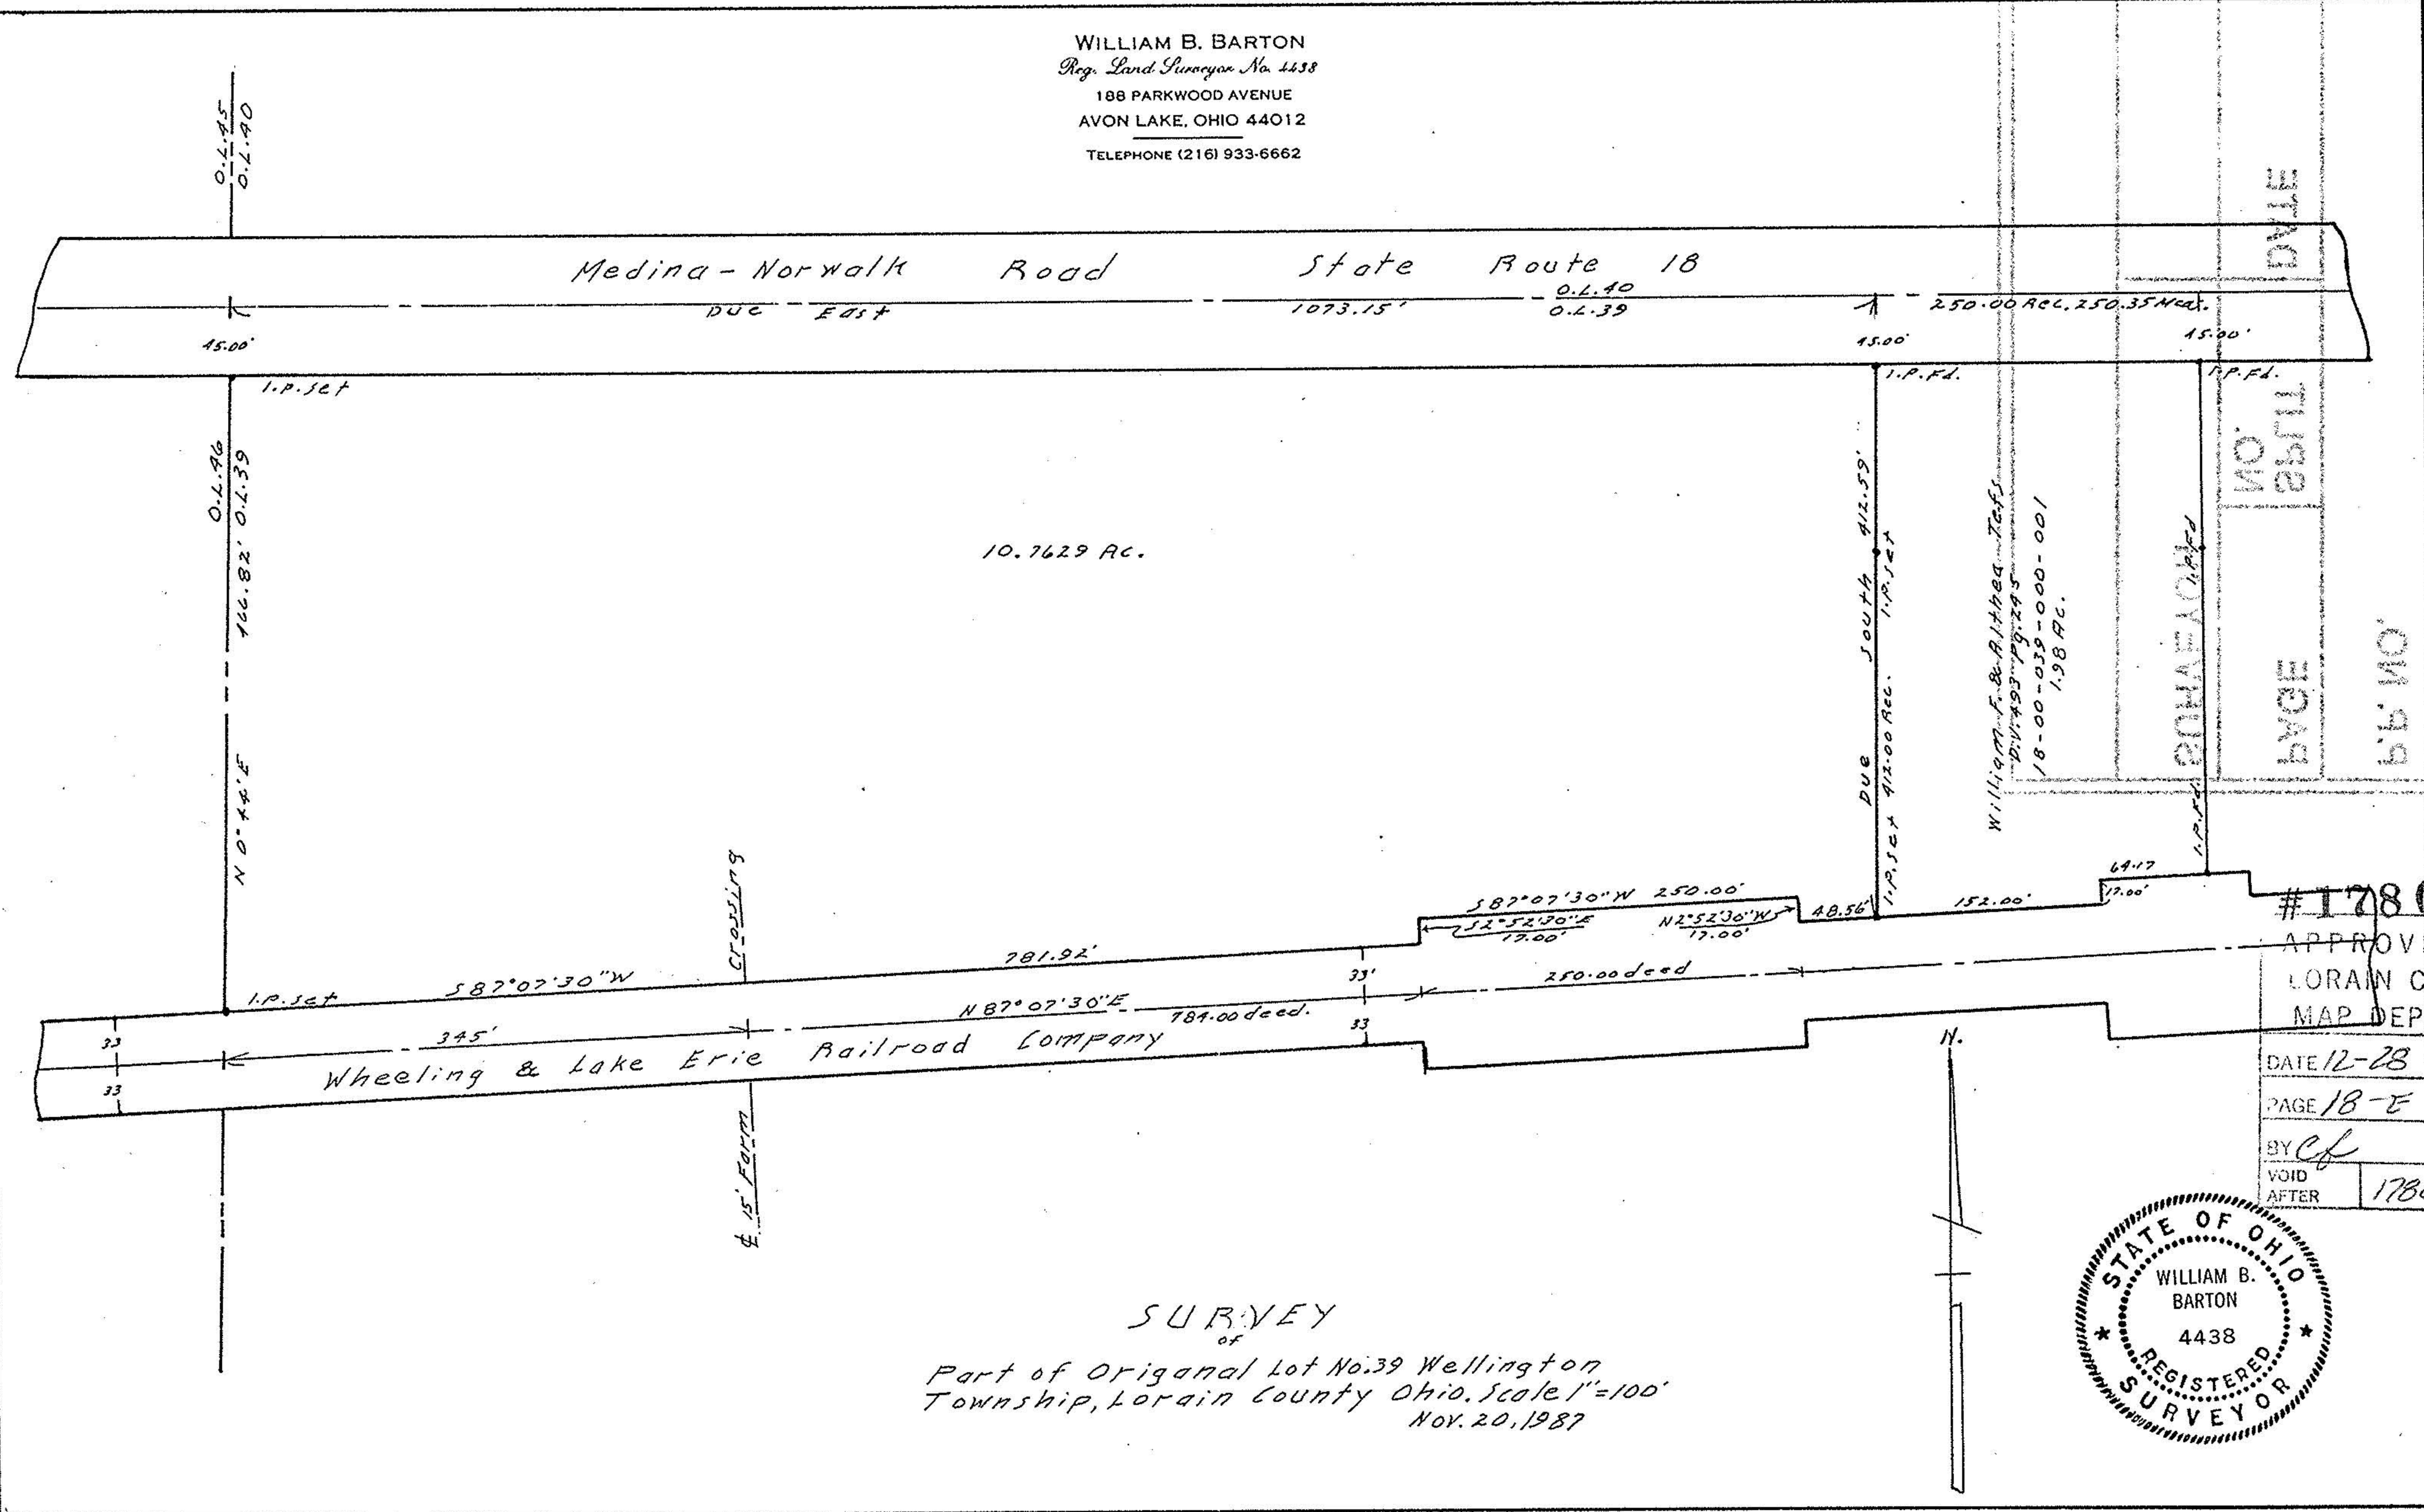

#17802  
APPROVED  
LORAIN CO.  
MAP DEPT.  
DATE 12-28 87  
PAGE 18-E  
BY *cf*  
VOID  
AFTER 17802




SURVEY  
of  
Part of Original Lot No. 39 Wellington  
Township, Lorain County Ohio. Scale 1"=100'  
Nov. 20, 1987

18-E

SELLERS A/R #17802

18-00-037-000

SEE 18-A KEEPING THIS

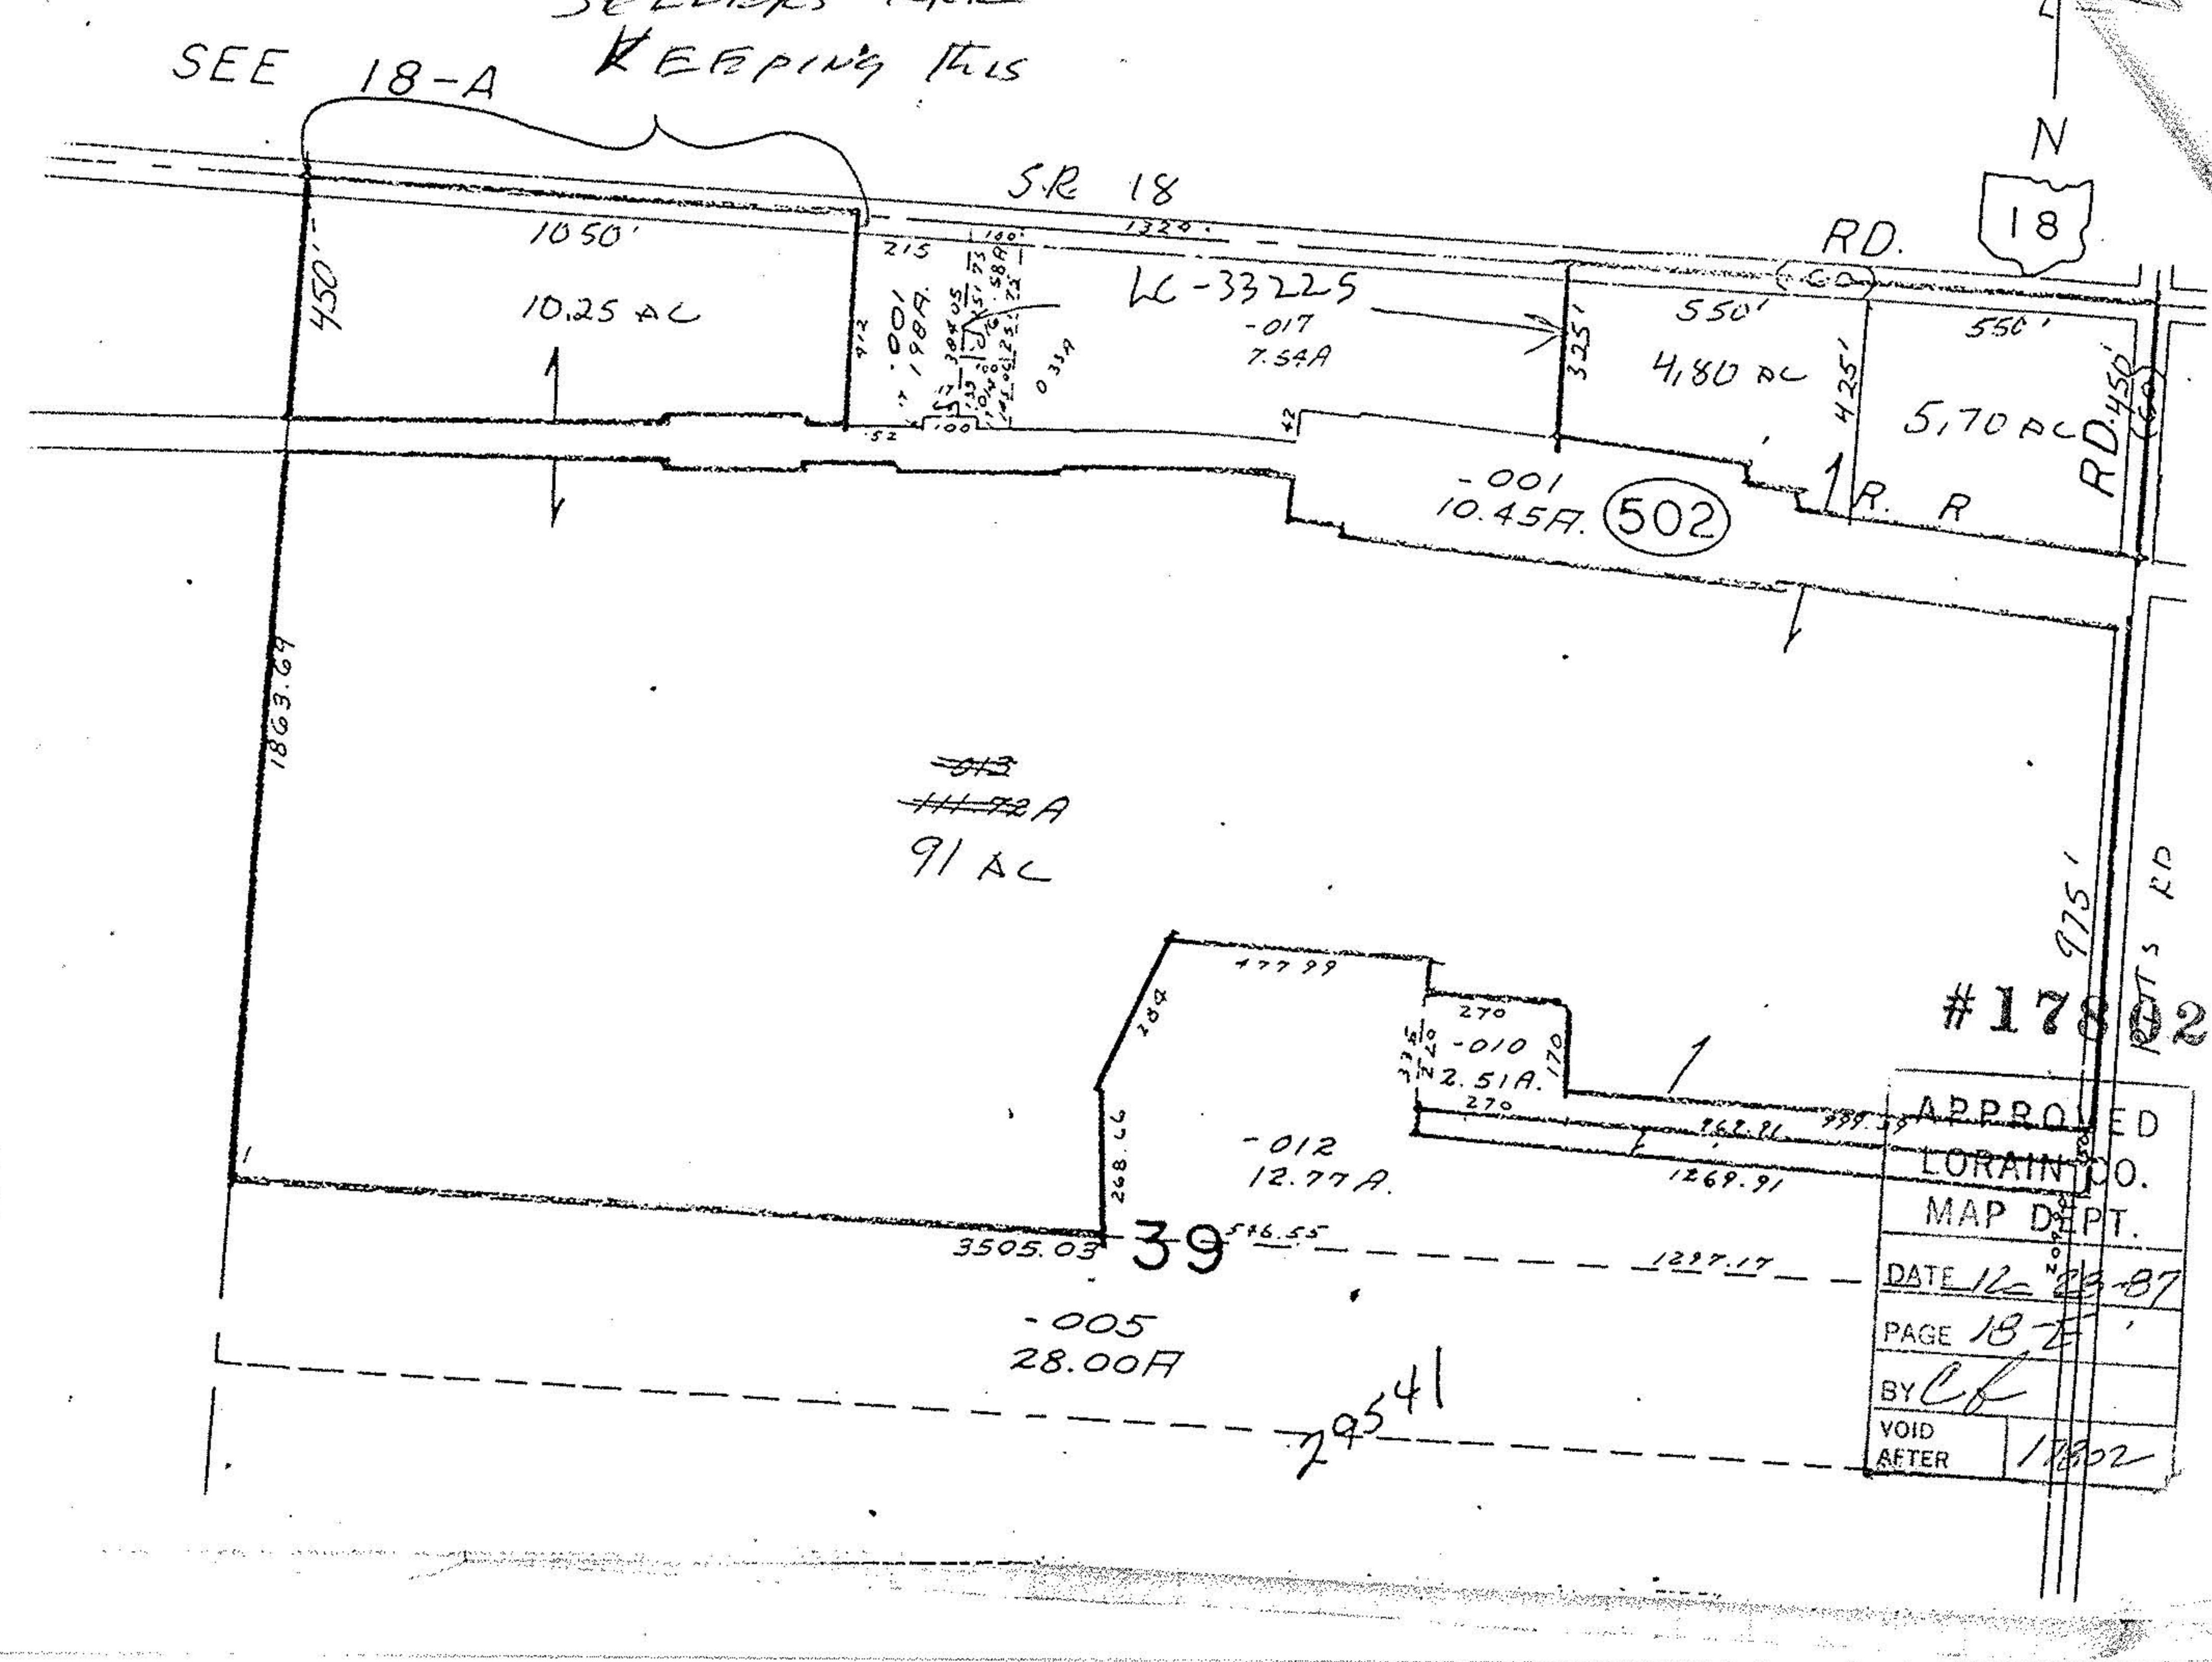

#17802  
APPROVED  
LORAIN CO.  
MAP DEPT.  
DATE 12-23-87  
PAGE 18-E  
BY *cf*  
VOID  
AFTER 17802