


18-A

18-00-044-A, Q

# 10598

18-00-044-000

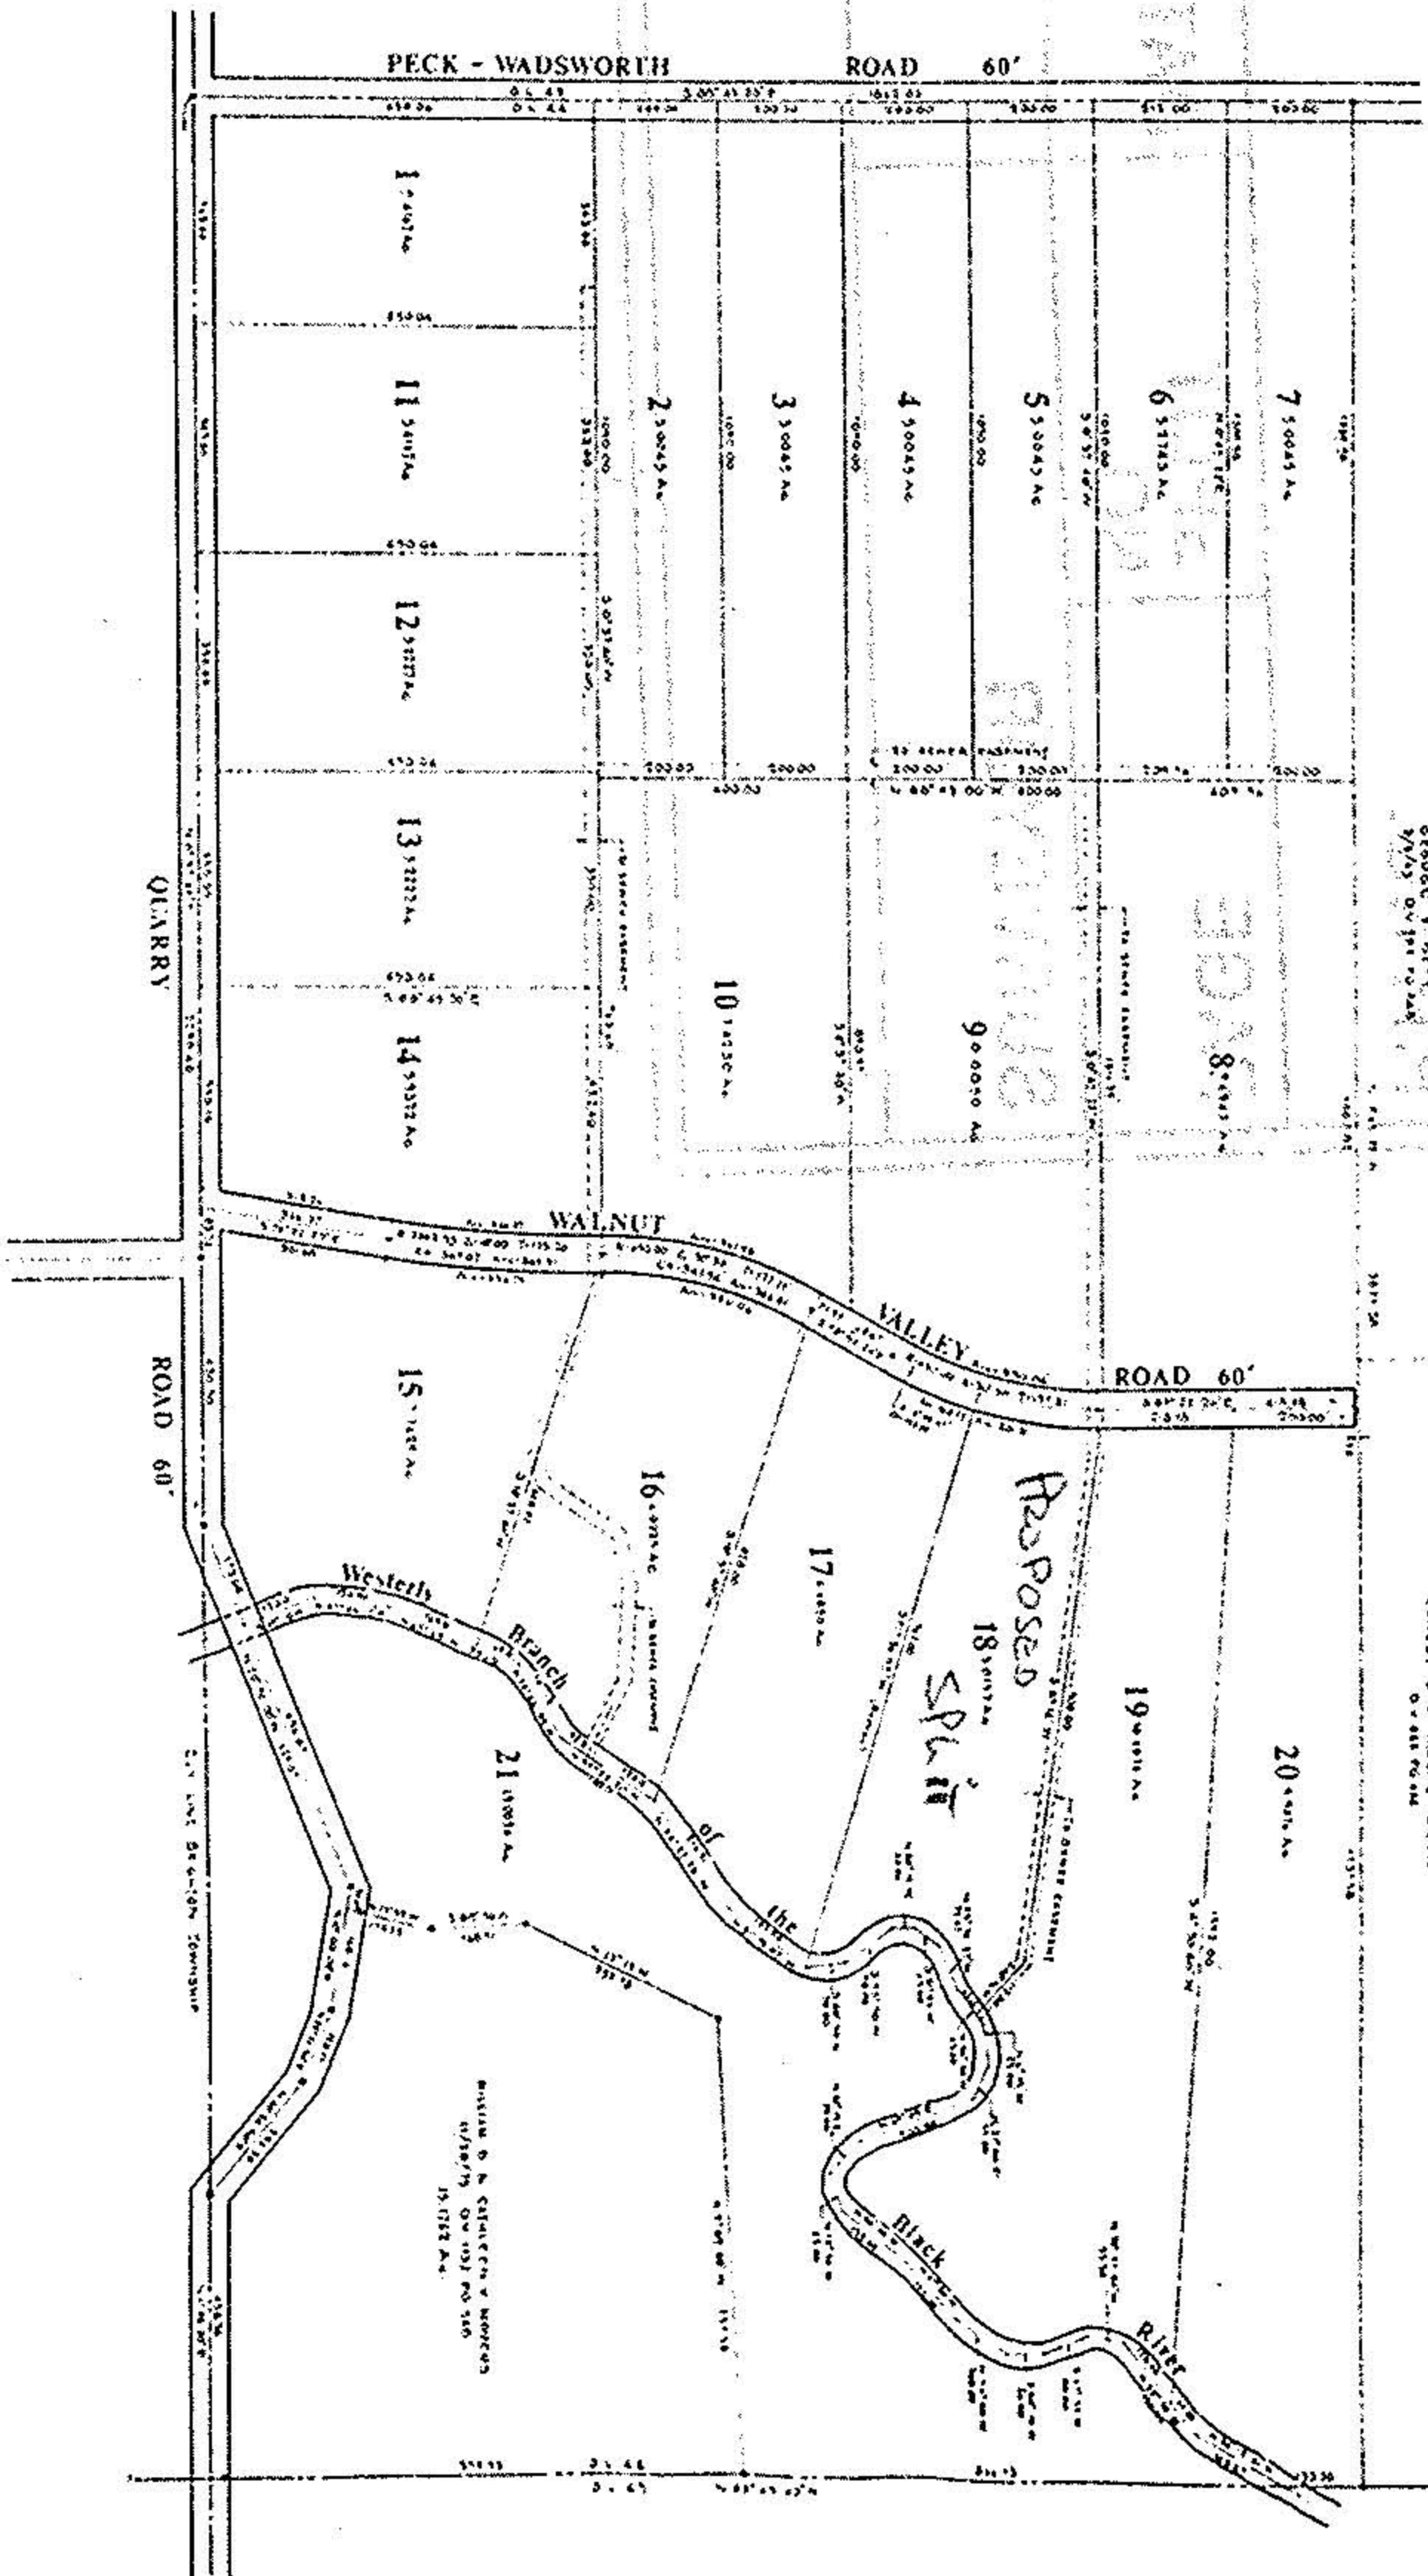

JUN 10 1977

RIVER RANCH ACRES

O.L. 44 WELLINGTON TWP.  
LORAIN COUNTY OHIO  
SCALE 1"=150' OCTOBER, 1976



Laundon, Simon, Cahl & Associates  
Engineers  
Surveyors