


Deeds are inspected & correct

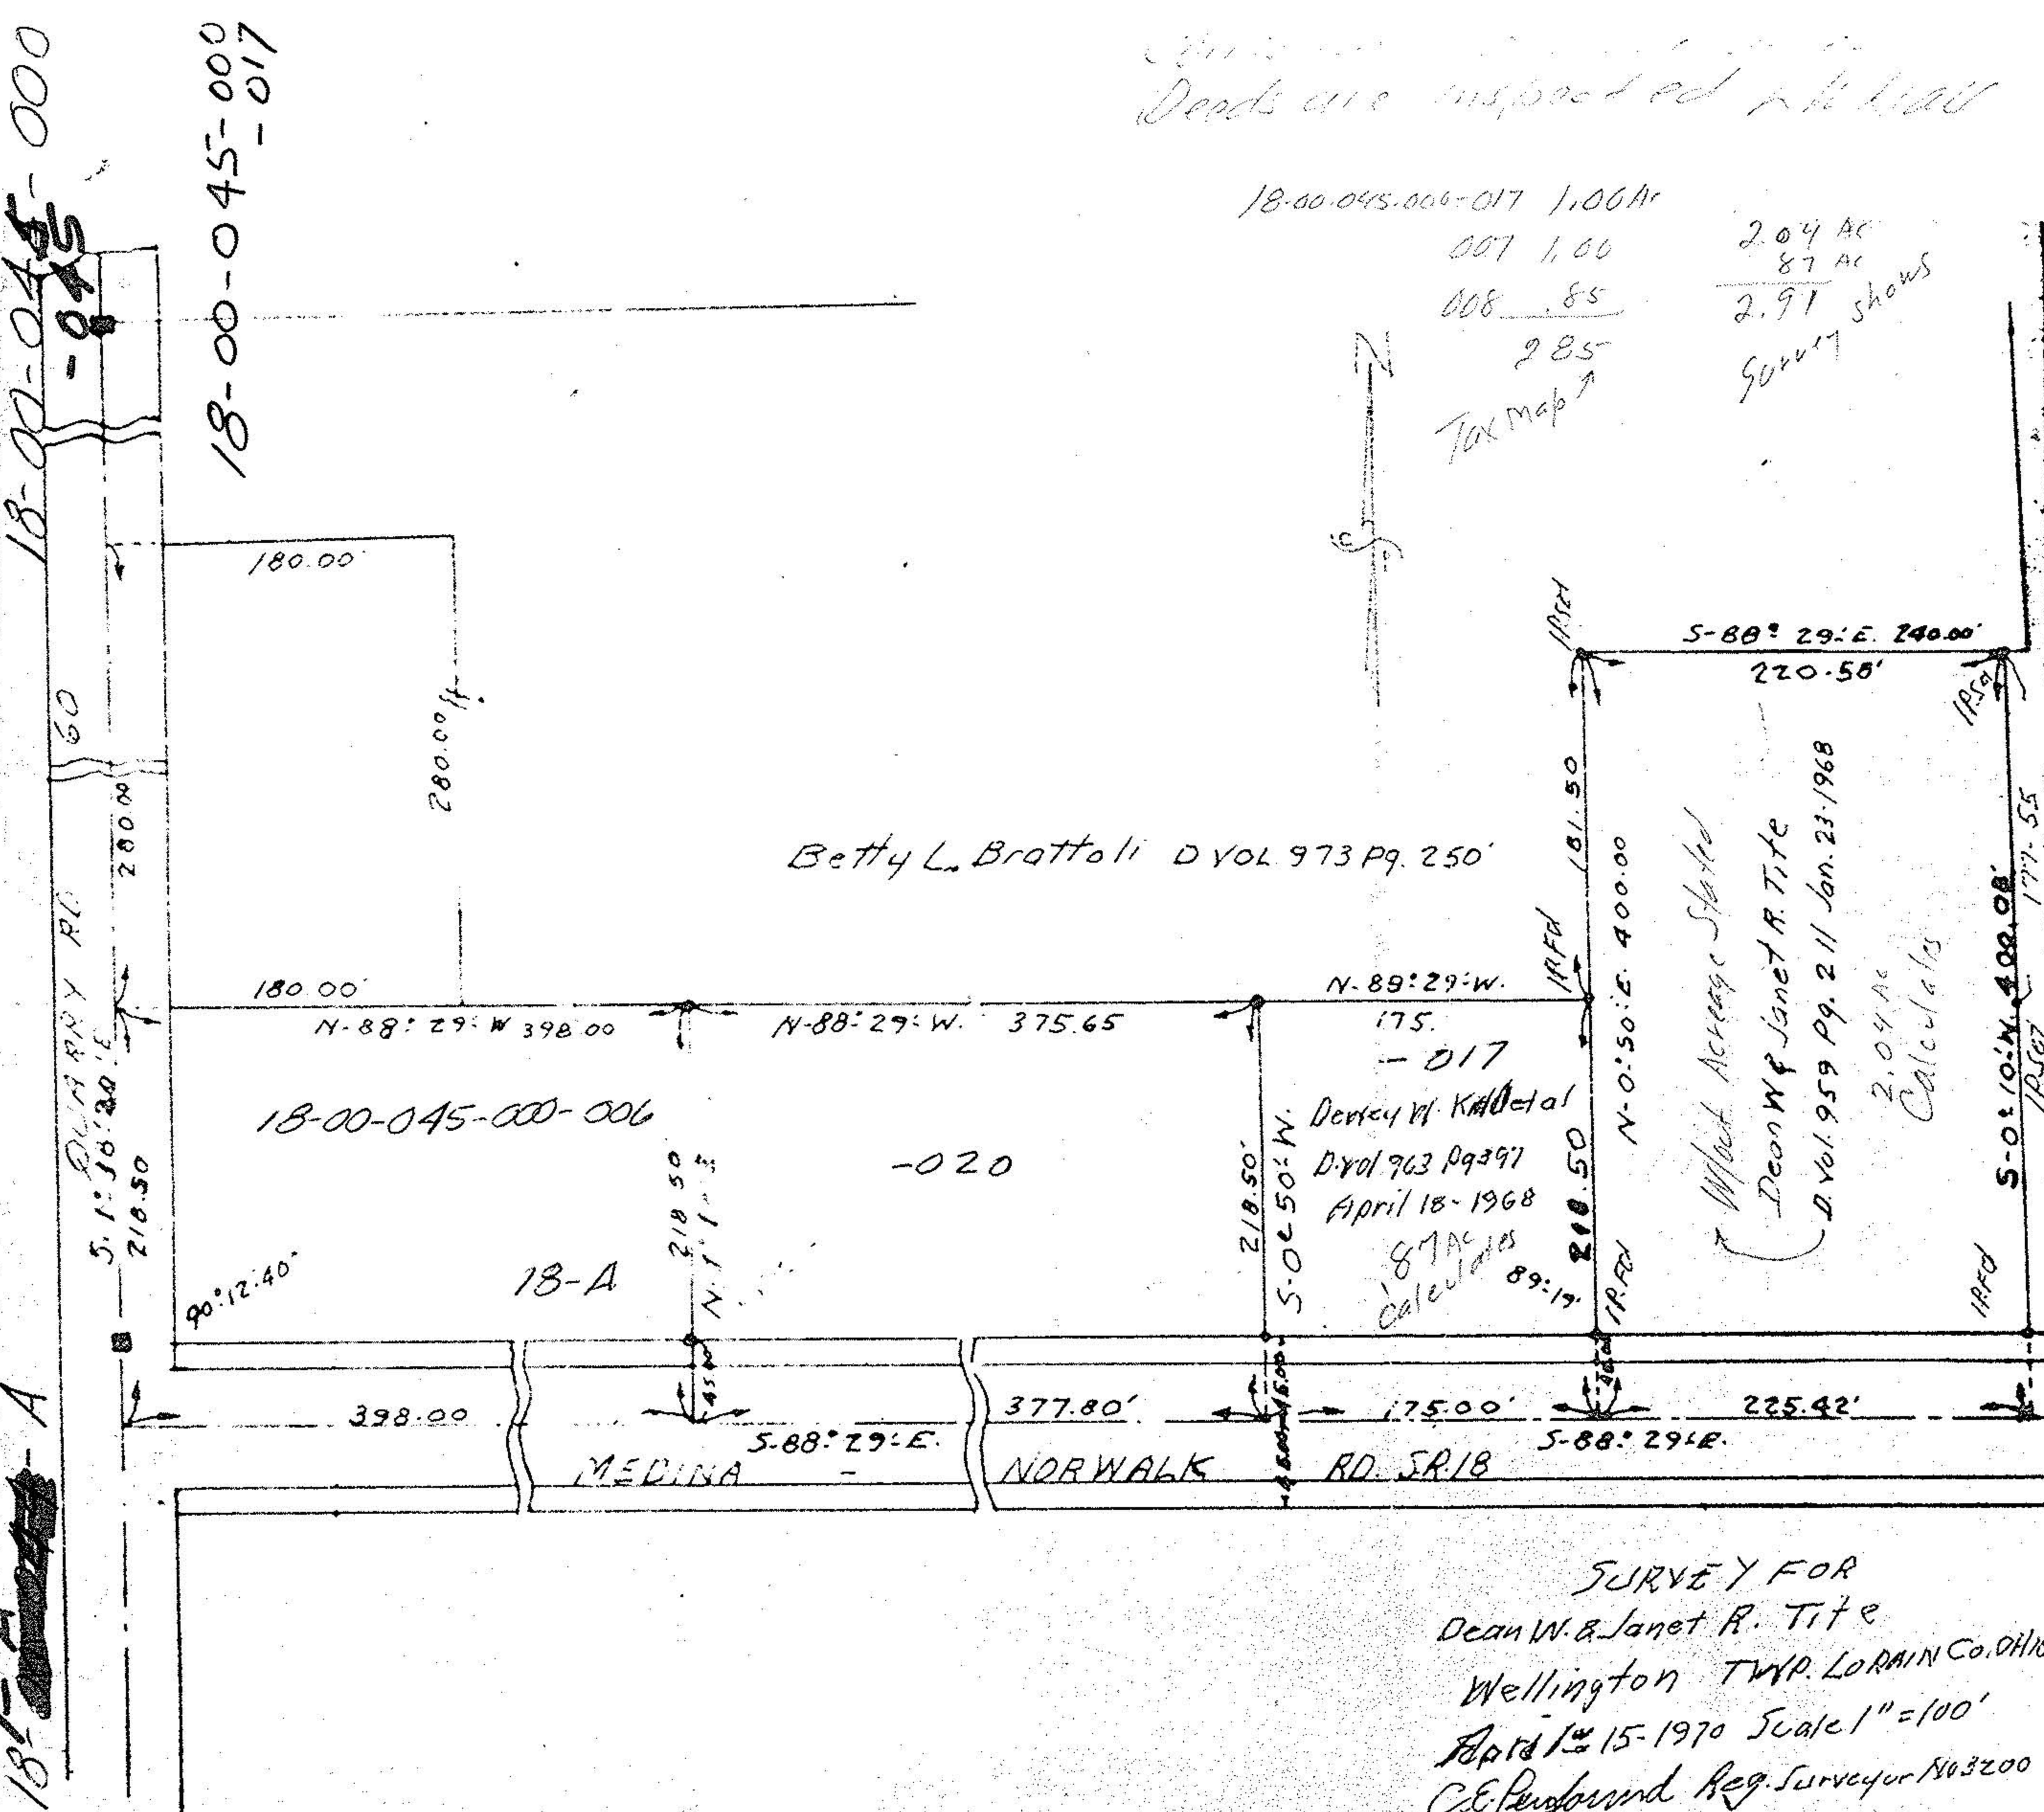

18-00-045-000-017 1.06 AC
 007 1.00
 008 .85
 2.85
 Tax Map ↑

2.04 AC
 87 AC
 2.91 shows
 Survey

Betty L. Brattoli D VOL 973 Pg. 250

18-00-045-000-006

-020

175.
 -017
 Deon W. Kattel
 D. Vol 963 Pg 397
 April 18-1968
 87 AC
 Calculated
 89:19

W/lot Acreage Stated
 Deon W & Janet R. Tite
 D. Vol. 959 Pg. 211 Jan. 23-1968
 2.04 AC
 Calculated

SURVEY FOR
 Deon W. & Janet R. Tite
 Wellington TWP. LORAIN CO. OHIO
 April 15-1970 Scale 1"=100'
 C.E. Penfound Reg. Surveyor No. 3200