

MEDINA NORWALK ROAD 90' SR 18

1 P.M.C.P.  
N & USED

S 89° 36' 55" E 1108.95' CALC.

1078.95' CALC.

1 P.M.C.P.  
N & USED

DUE NORTH 623.63' CALC.

580.74' CALC.

60'

ROAD

QUARRY

DUE NORTH 802.58' CALC.

R = 2611.42  
A = 354.94'  
C = 354.67'  
C.B. = N 88° 46' 14" W

PARCEL "A"  
(NEW PCL)  
15.701 ACRES

SUGASKY  
P. 424

S 87° 35' 14" W 755.00' CALC.

N 87° 35' 14" E 751.93' CALC.

R = 2617.42  
A = 358.00  
C = 357.73  
C.B. = S 88° 50' 01" E

HARRY  
P. 812


PARCEL "B"  
(REMAINDER PCL.)  
20.685 ACRES

= (D) 13

N 89° 19' 00" W 1109.00' REC.

2351.50' OBS.

HARRY SUGASKI P.P. #18-00-046-000-007 V. 812 P 424  
S. LINE OF O.L. 46

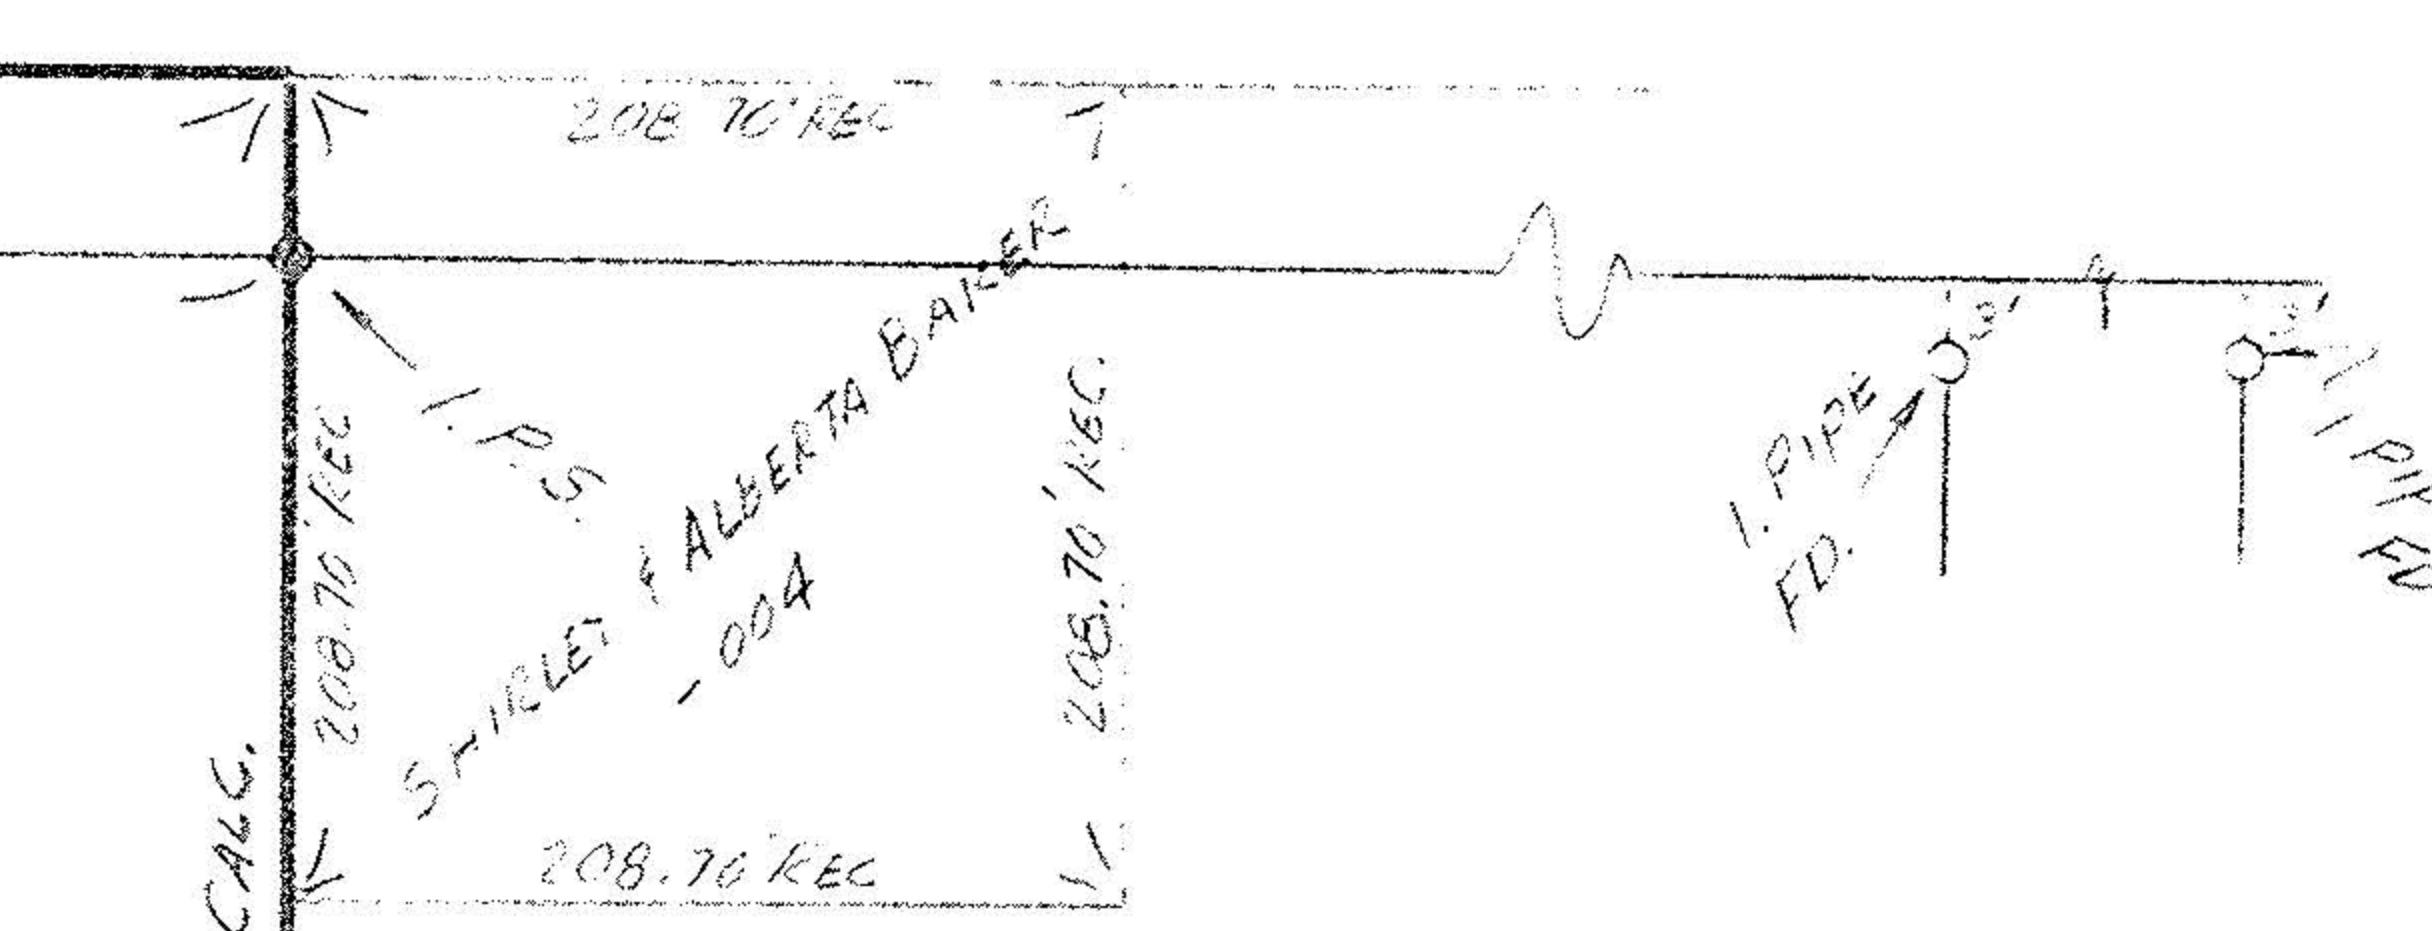

SCALE: 1"=100'

MAP OF SURVEY AND LOT SPLIT

SITUATED IN THE TOWNSHIP OF WELLINGTON, COUNTY OF LORAIN, STATE OF OHIO, AND KNOWN AS BEING PART OF ORIGINAL WELLINGTON TOWNSHIP LOT NO. 46

PREPARED FOR

CALVIN G WOODS

SURVEYOR'S STATEMENT

DISTANCES ARE EXPRESSED IN FEET AND DECIMAL PARTS THEREOF. BEARINGS ARE TO AN ASSUMED MERIDIAN AND ARE USED TO INDICATE ANGLES ONLY. PERMANENT MONUMENTS WERE FOUND OR SET AS INDICATED HEREON. ALL OF WHICH I DECLARE TO BE CORRECT TO THE BEST OF MY ABILITY A BELIEF.

THOMAS M. SNEZEK  
P.S. #18-00-046-000-003  
# 1057 P. 382

Thomas M. Snezek  
THOMAS M. SNEZEK, P.S. #1057

4-3-95  
DATE

18-00-046-000-

21317

APPROVED LORAIN CO. MAP DEPT
DATE 5-4-95
PAGE 18-E
BY CAROLYN FRANCIS
# 21317