



± Jones Rd by Lorain County Engineers  
 FB 239 Pg 120

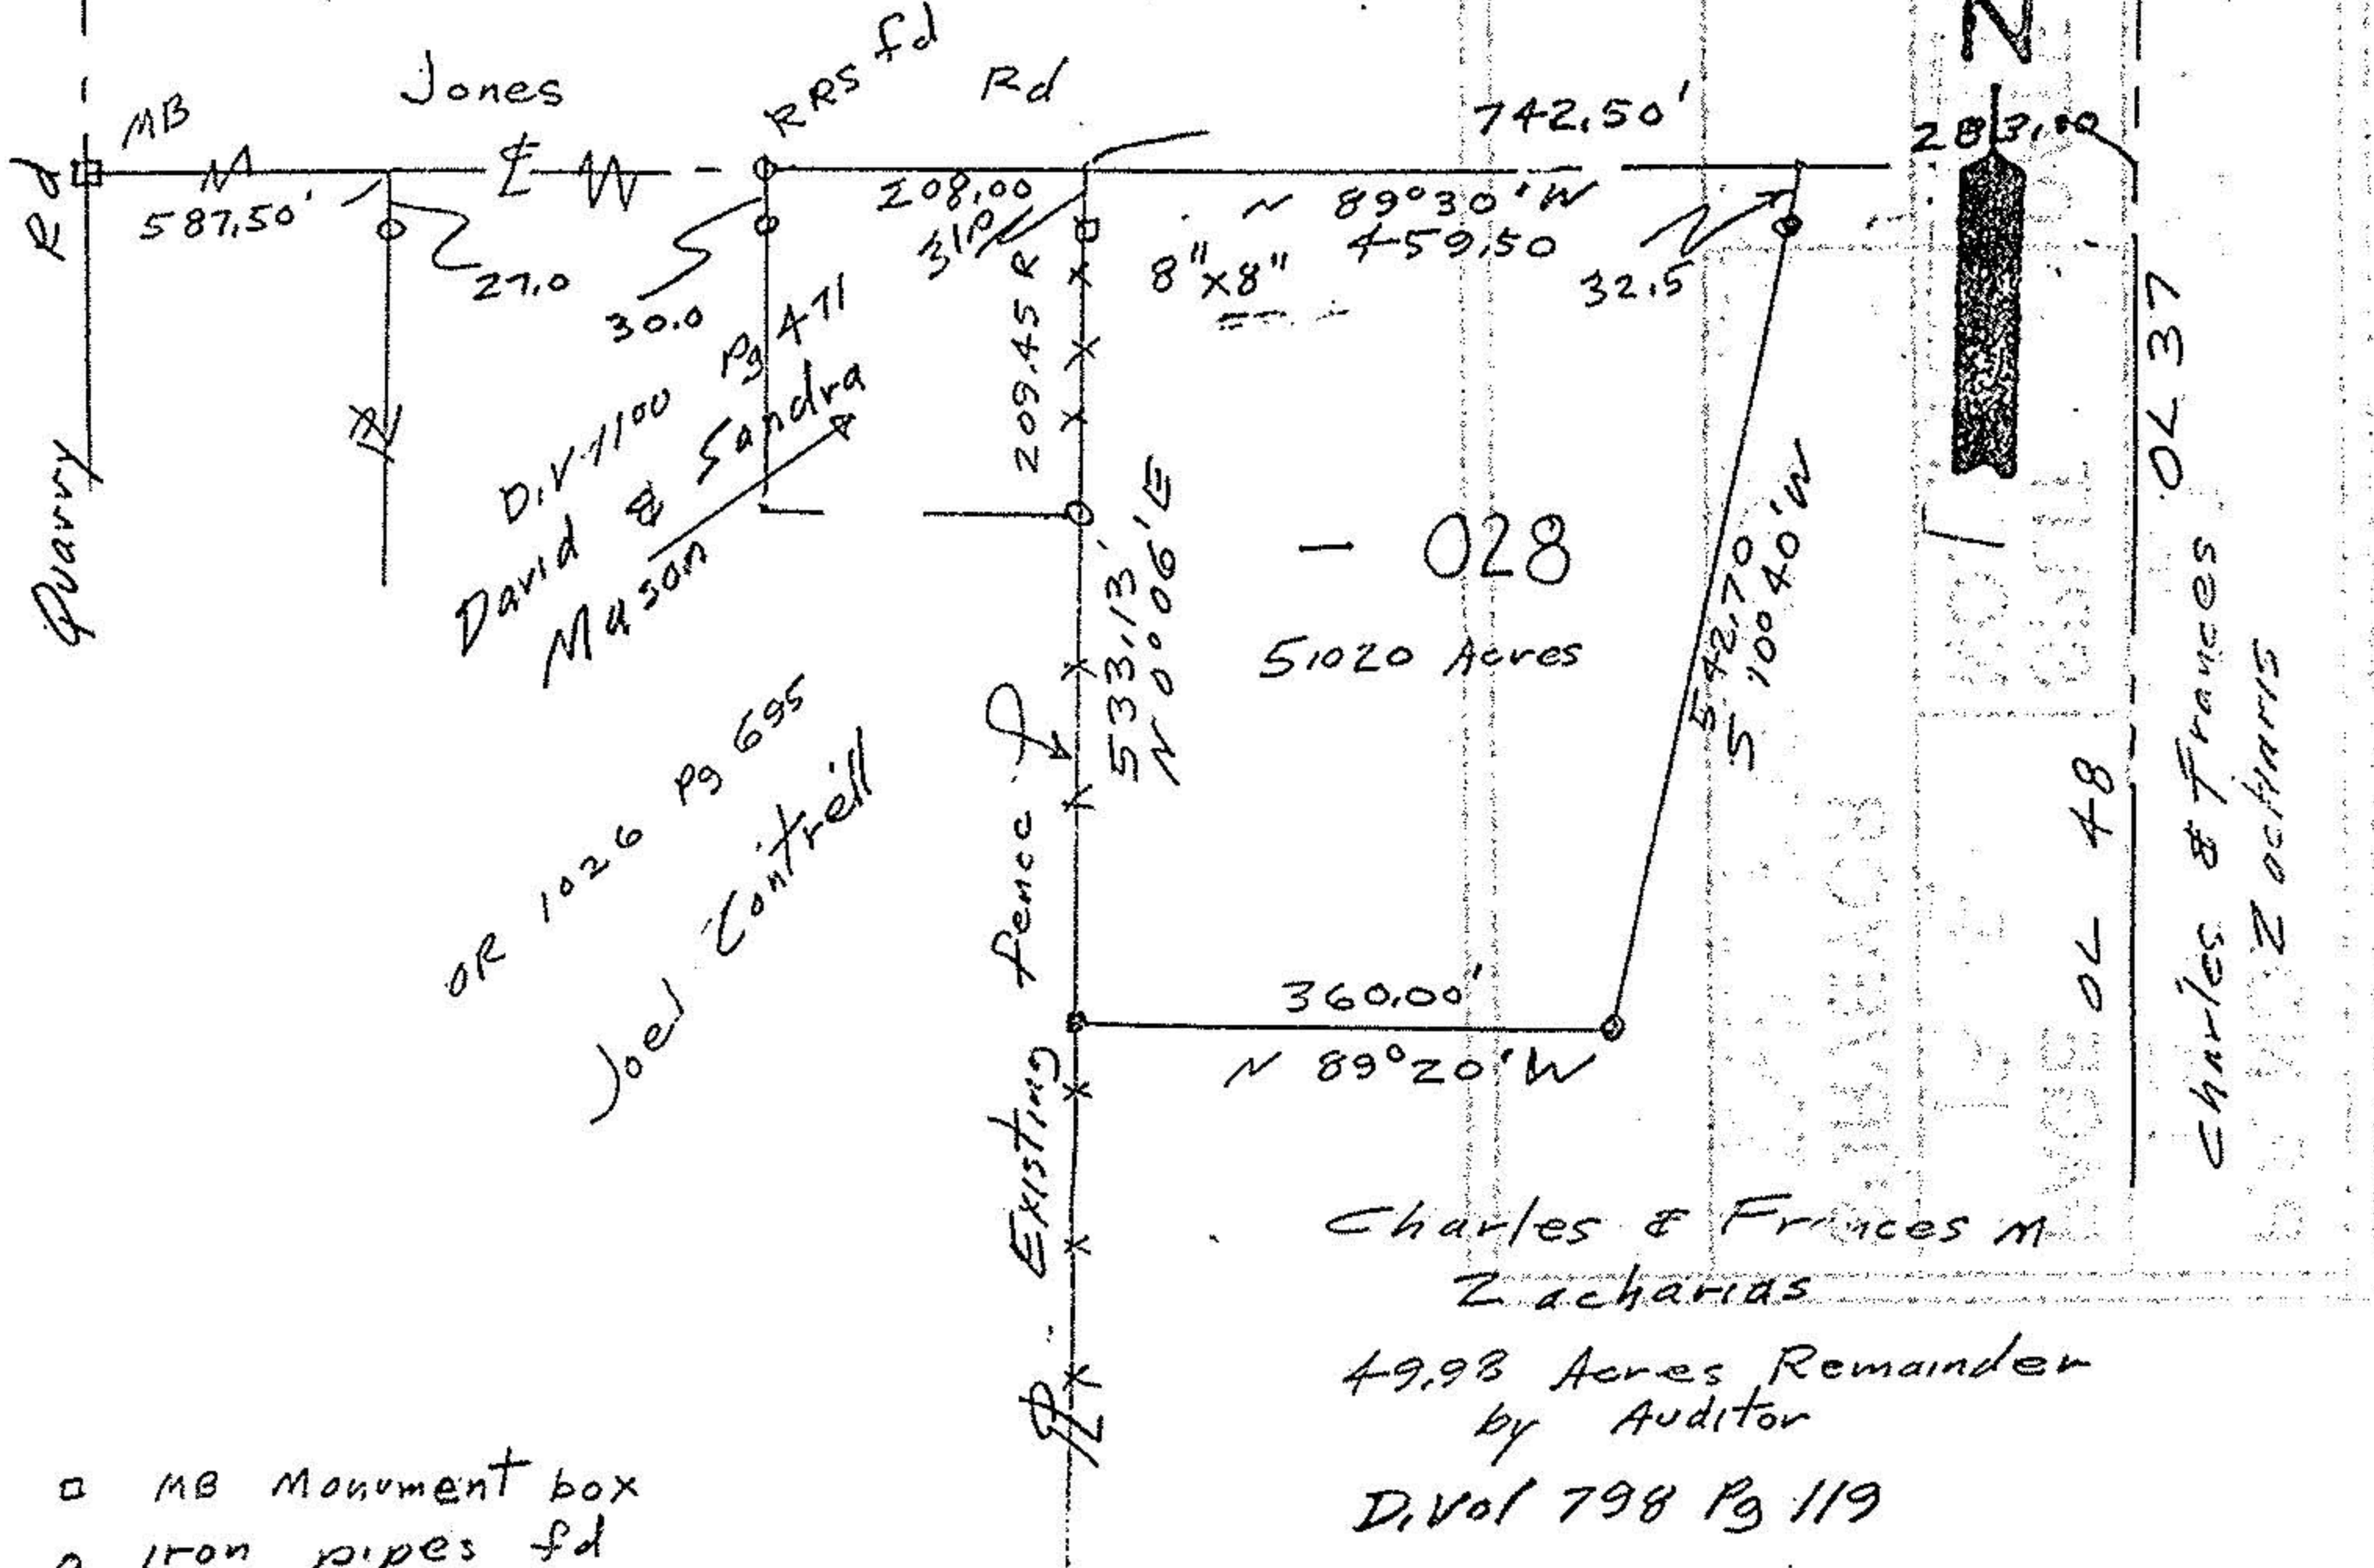

- MB Monument box
- iron pipes fd
- iron pins set w/PVC pipe
- 8" x 8" fence post

John Poznywak  
 Reg Surveyor  
 5292

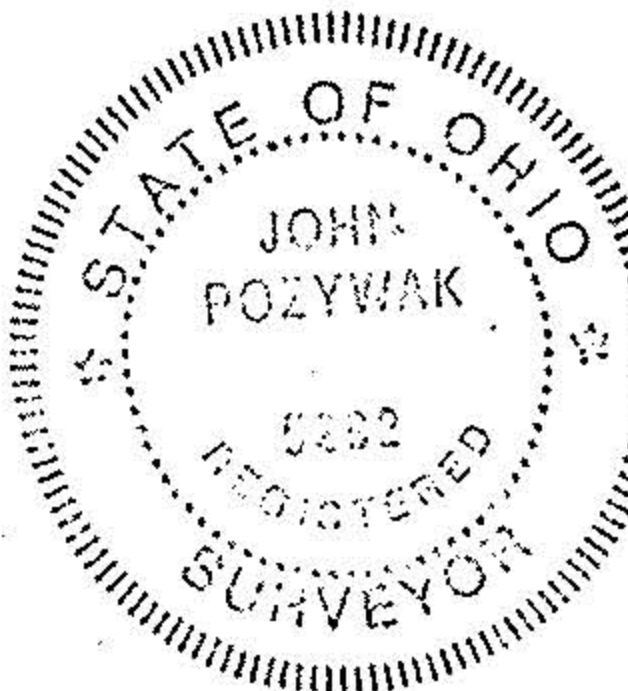

21711	
APPROVED LORAIN CO. MAP DEPT	
DATE 3-22-96	
PAGE 18-E	
BY	CAROLYN FRANCES
#21711	

Survey of a parcel split

Original Lot 48  
 Wellington Township  
 Lorain County, Ohio  
 scale 1" = 200' Feb 20, 1996

