


19-03-013-013-000-01

~~#19010-A~~

19-03-013

SR 301

SEE 19107-A

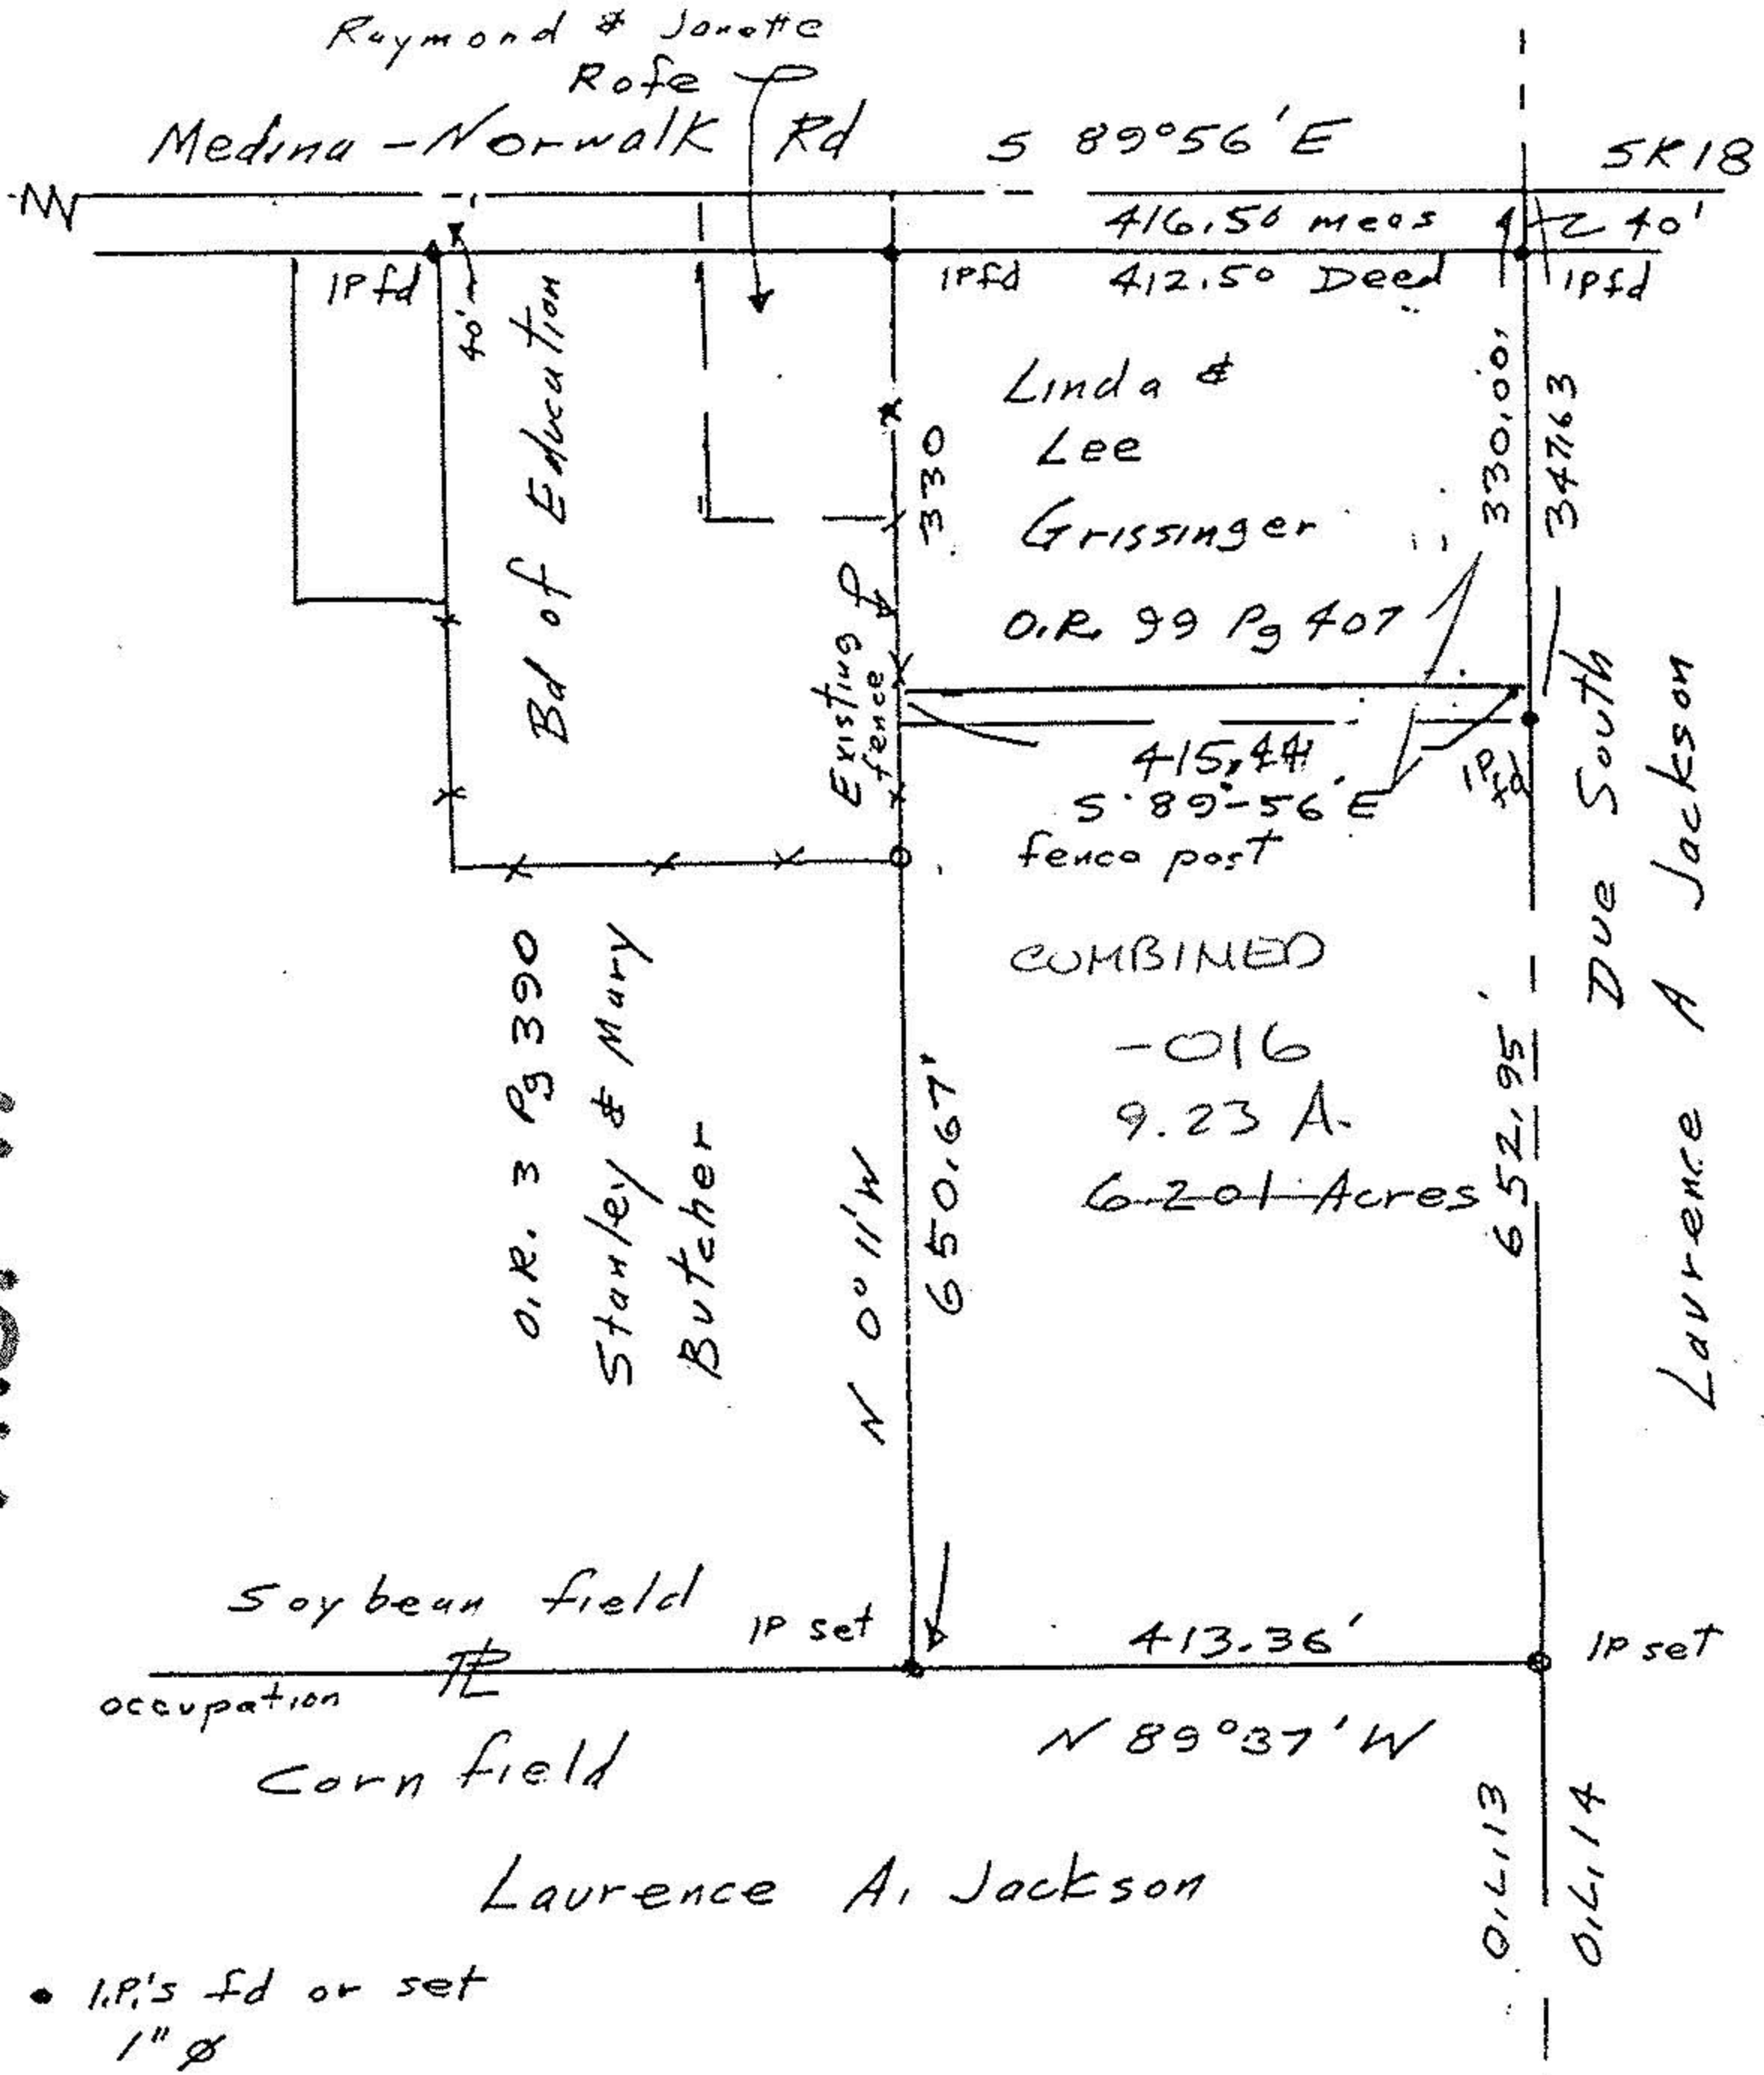

• 1.P.'s fd or set
1" ø

John Poyurovsk
Reg Surveyor
5292

19107-A
~~#19010-A~~

8/29/90
19-03-013

T. McMan
COMBINATION

Survey for
Linda Grissinger
Part of Original Lot 13
Section 3 Penfield Twp
Lorain County Ohio
Scale 1"=200 Oct 19, 1989