


19-03-013-000  
SR 301 - 01

#19010

19-03-013

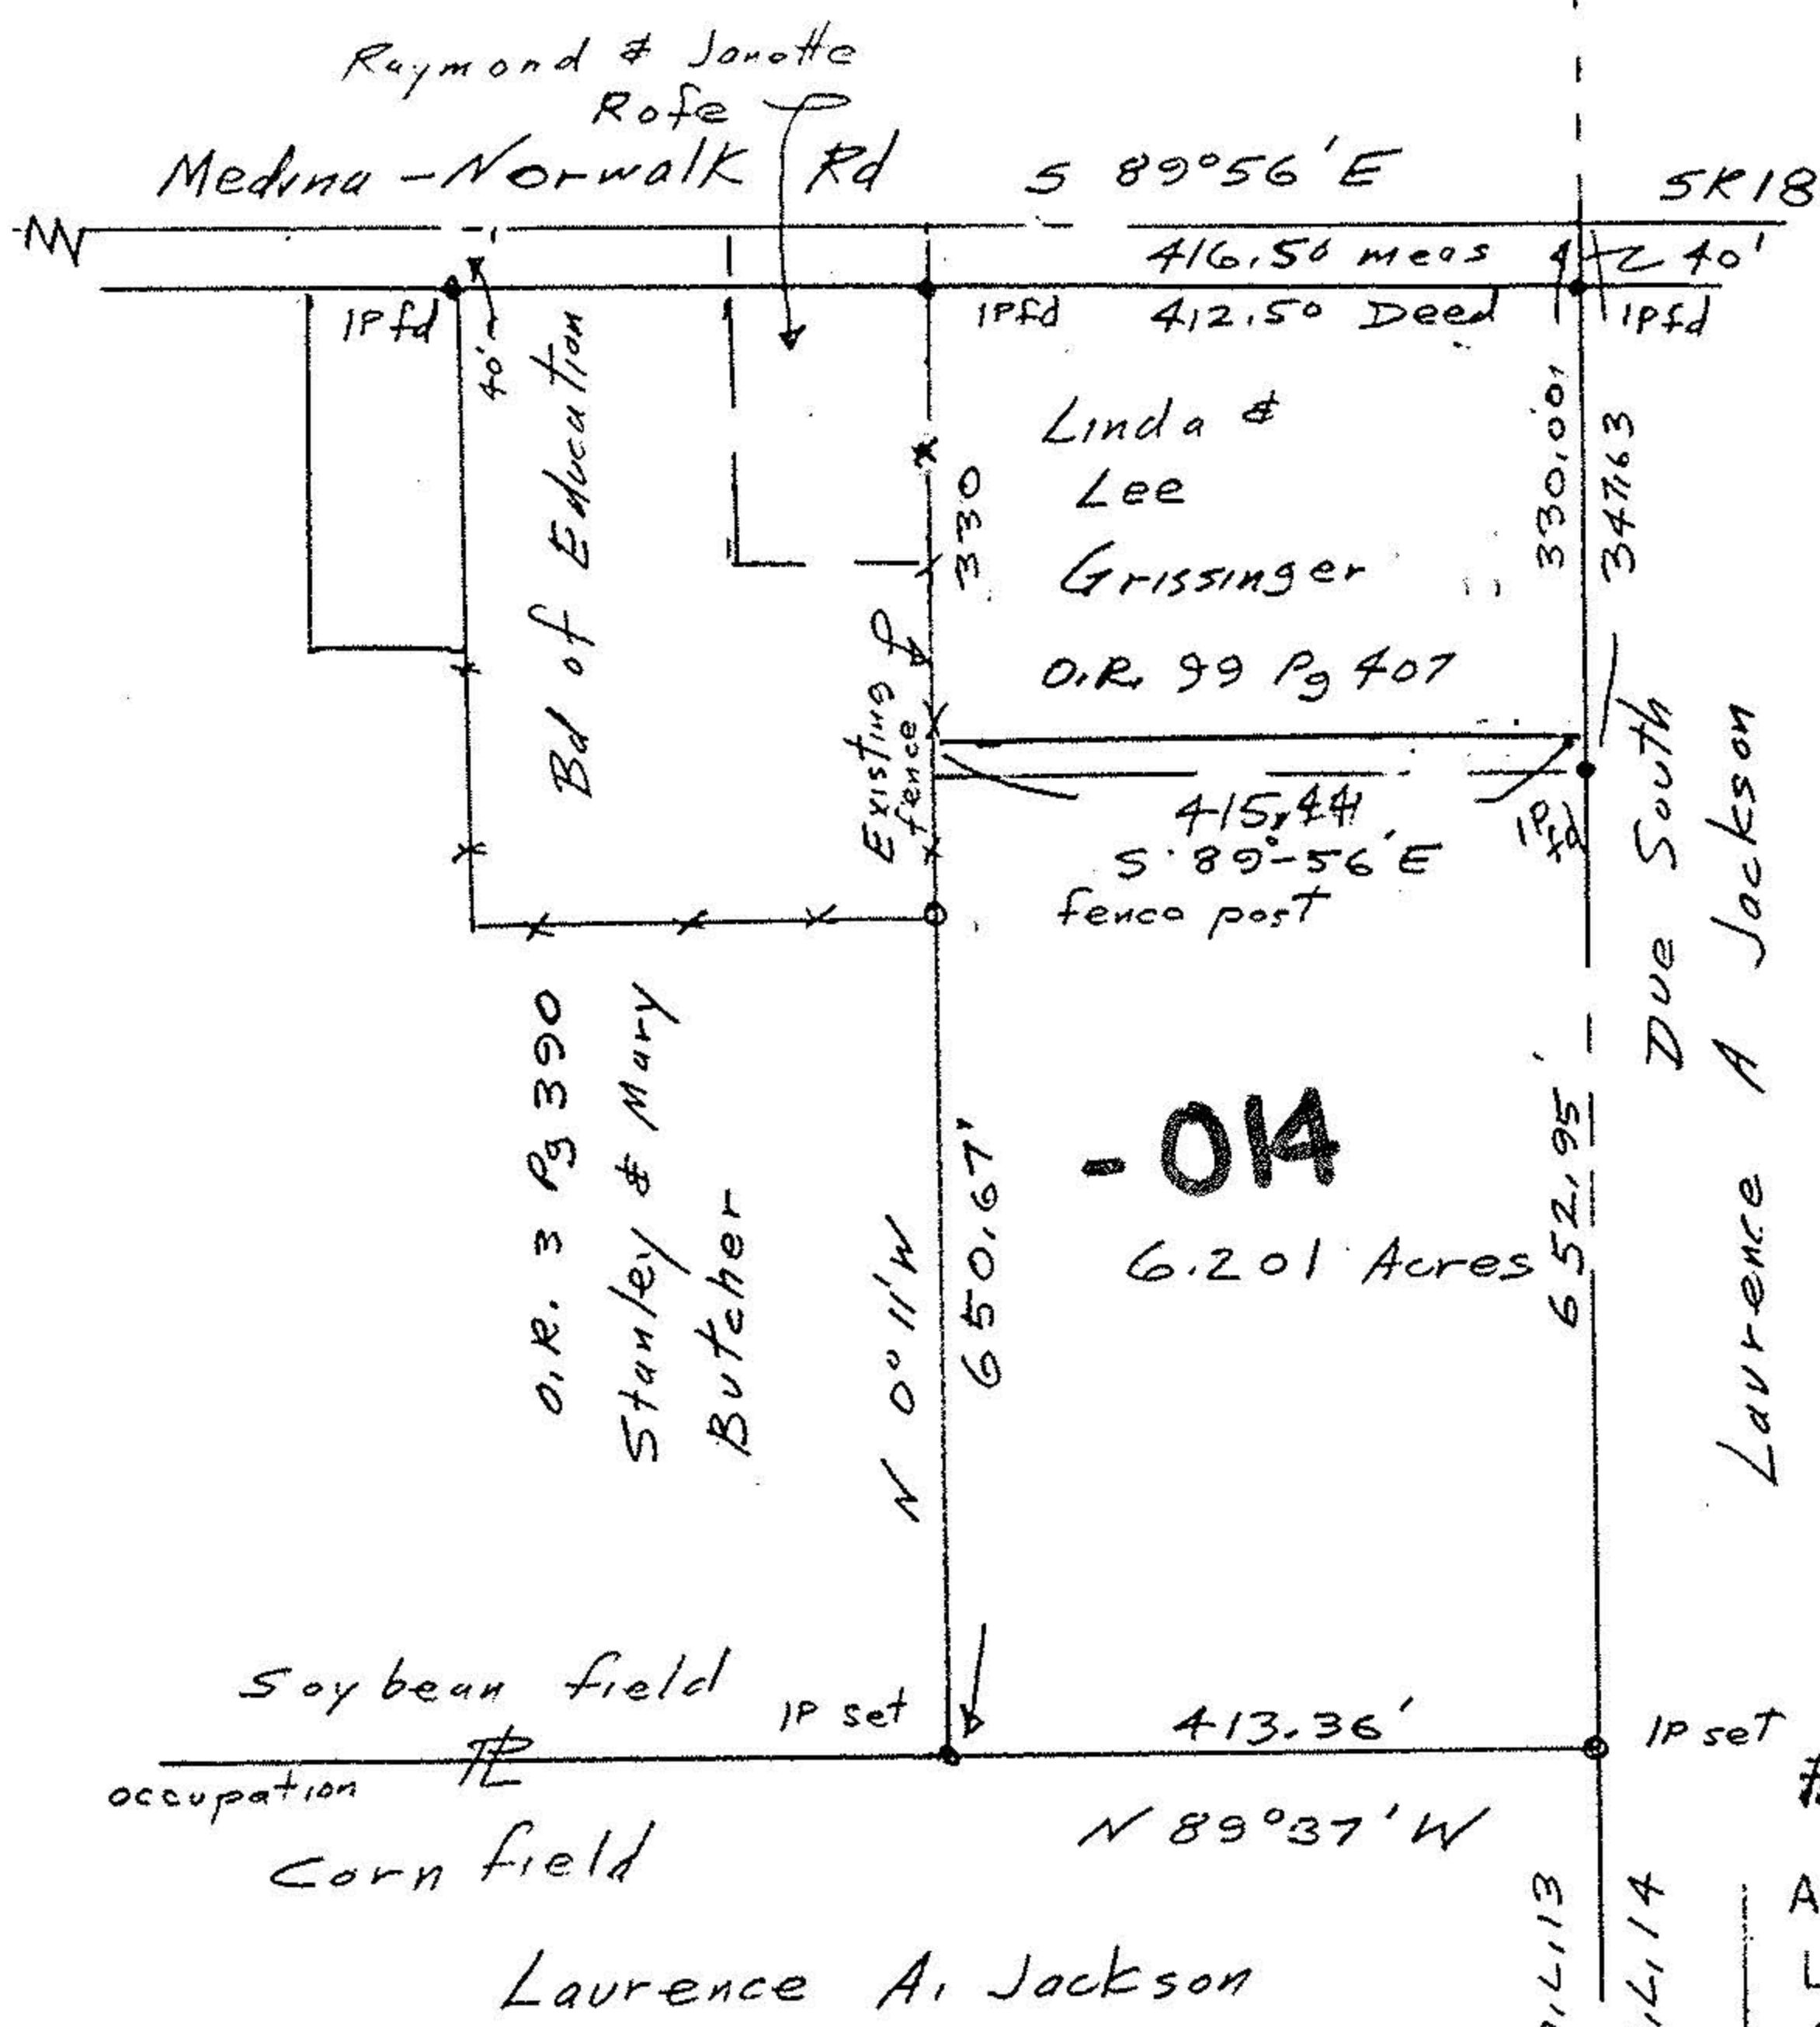

• I.P.'s fd or set  
1" ø

John Pozyswak  
Reg. Surveyor  
5292

Survey for  
Linda Grissinger  
Part of Original Lot 13  
Section 3 Penfield Twp  
Lorain County Ohio  
Scale 1" = 200 Oct 19, 1989

#19010	
APPROVED LORAIN CO. MAP DEPT.	
DATE 6-27-90	
PAGE 19-03-013	
BY CAROLYN FRANCIS	
VOID AFTER #	19010