


F. B. 258

2

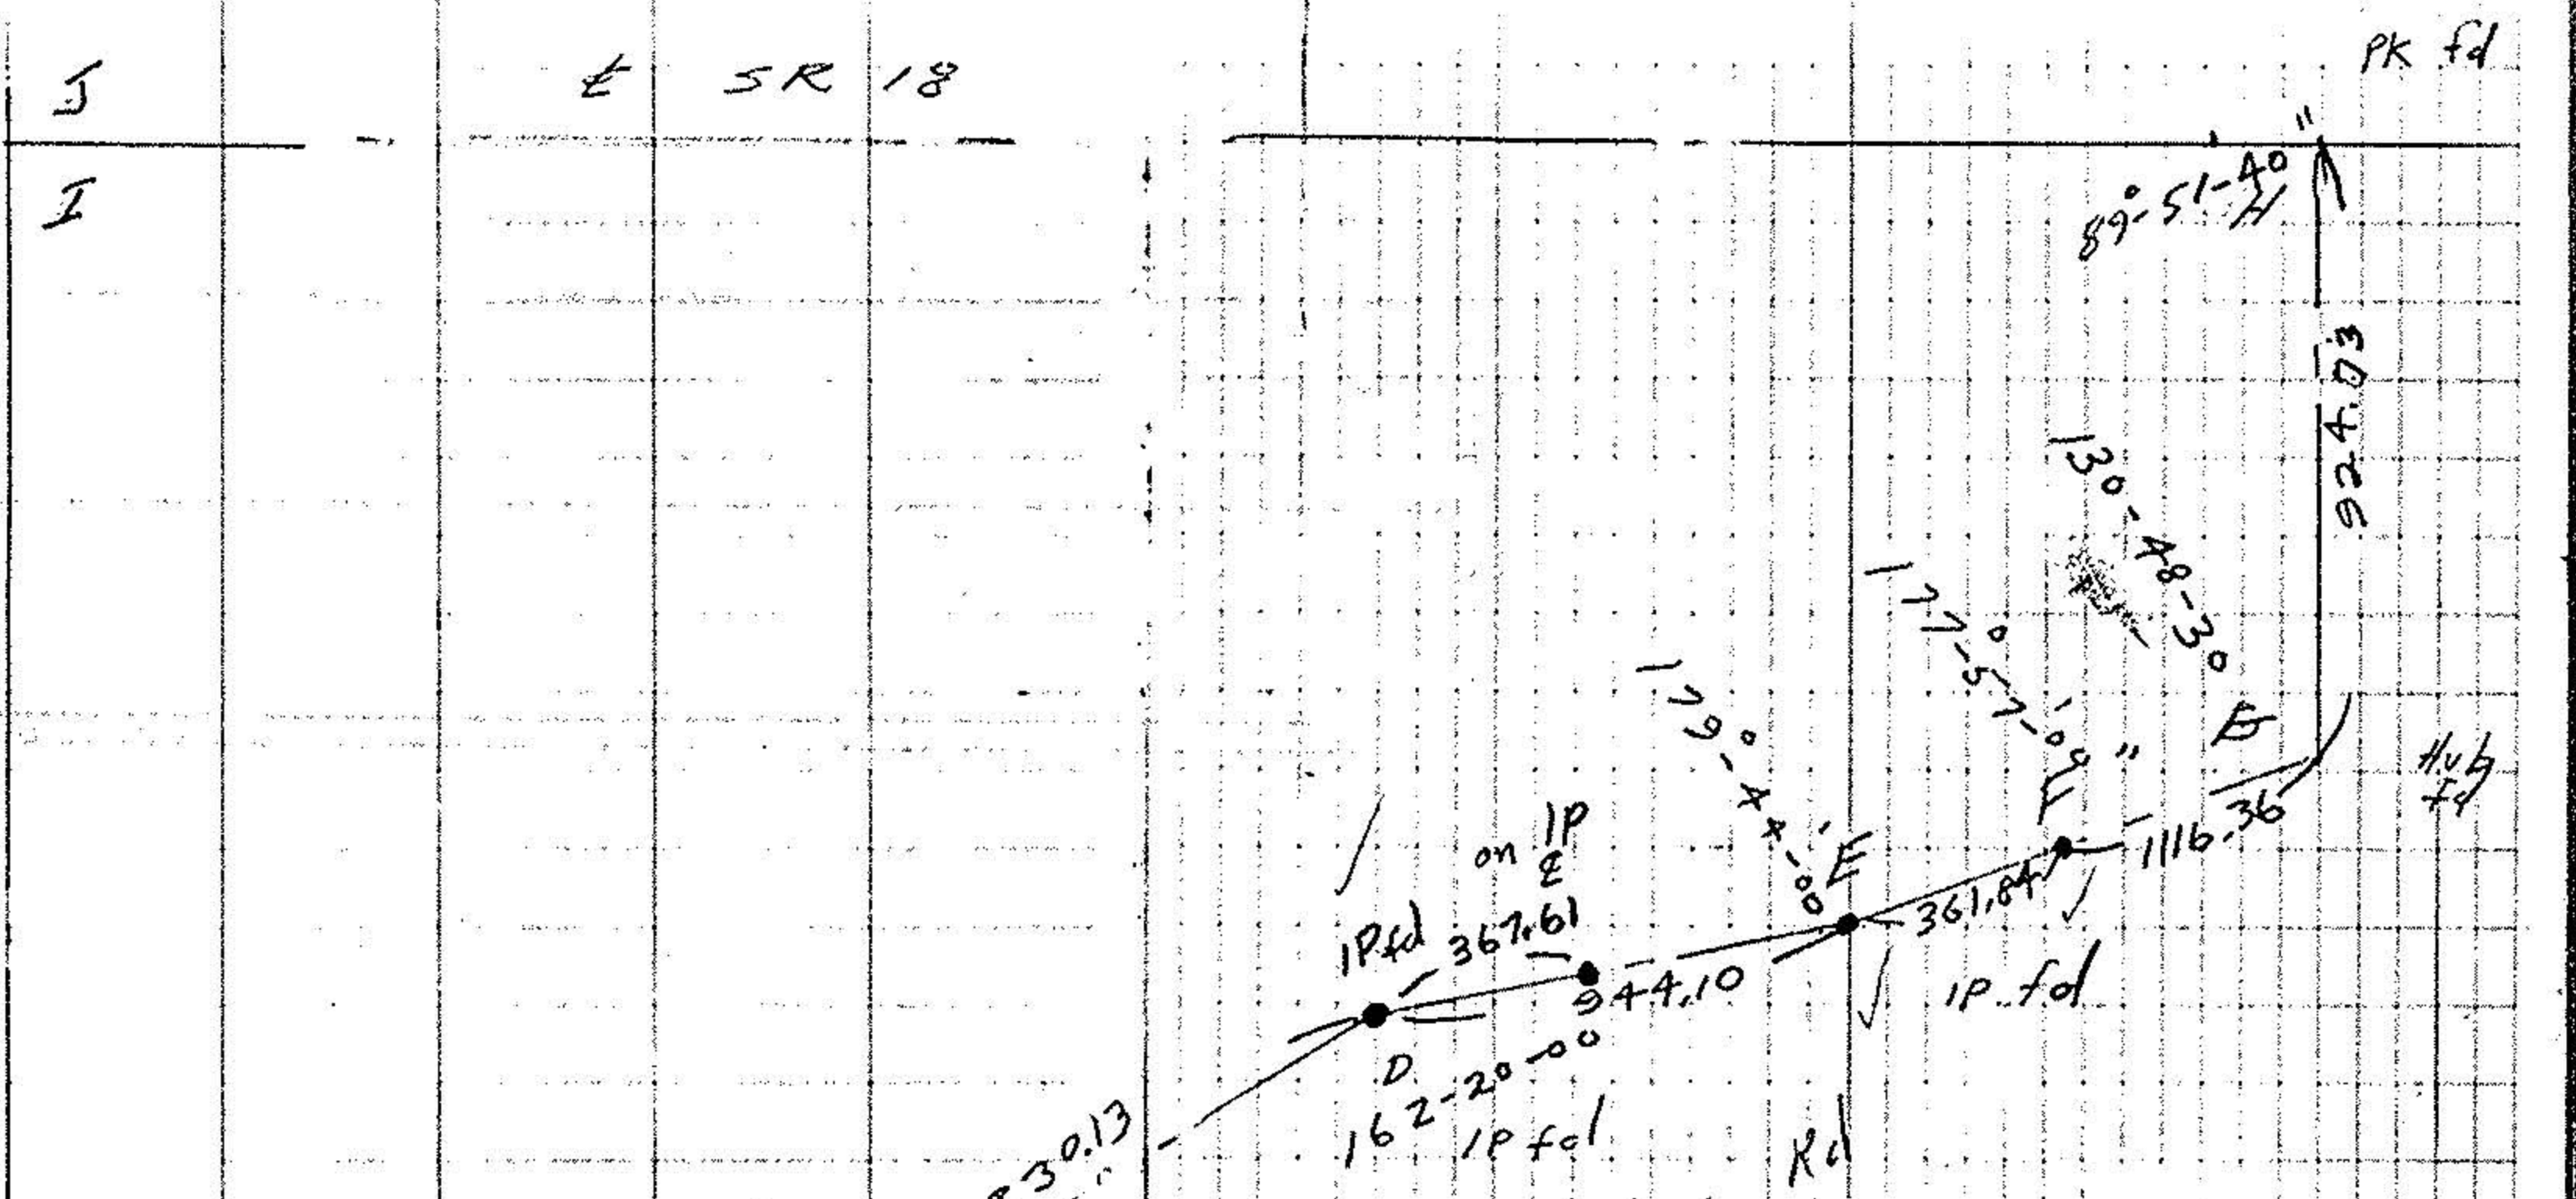


MAP OF SURVEY FOR GORDY HALES
 D.L. 15 - TRACT 3 - PENFIELD TWP. - LORAIN CO.
 MAY 1991 REV. 5/18 SCALE 1" = 100'
 JOHN R. HAMILTON - REG. SURVEYOR #6861

19436

LARRY JACKSON
 DEED VOL. 1380 P. 451
 12.73 AC. DUP.
 7.809 AC. REM.

19-03-015-000

NORTH
 SCALE 1" = 100'

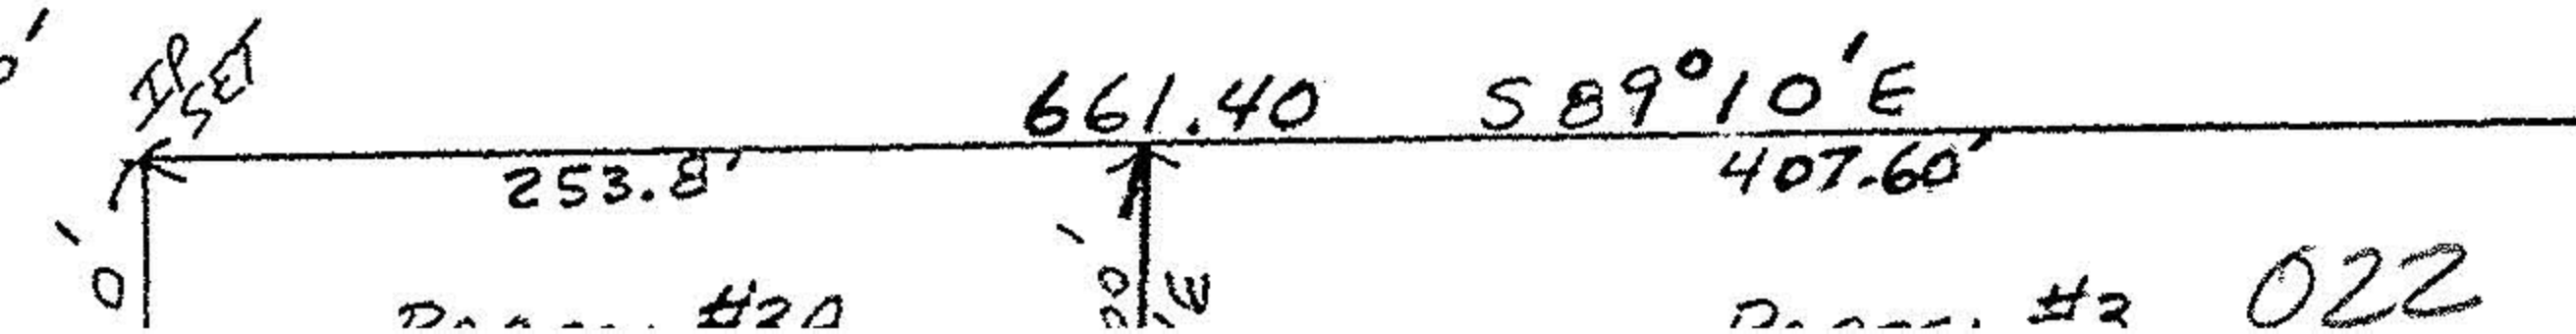

5.60' SET
 N 1° 26' E

HERMAN DULL
 DEED VOL. 1345, P. 113

HOLLOW
 WIDTH
 (SHED)

SR 301