

PLAT OF BOUNDARY SURVEY
DARRELL R. & ADELE I. DUNLAP
 PART OF O.L. 53, TRACT NO. 3
 TOWNSHIP OF PENFIELD, LORAIN COUNTY, OHIO

STATE ROUTE 18 MEDINA - NORWALK ROAD

VERMONT ST.

*Ref file 2001-0764/201
 2001-0758994
 6/20/01 John Walters, Cheryl*

PART OF O.L. 53

Legend

- Iron Pipe Found
- Ⓜ Iron Pin in Monument Box Found
- Ⓜ Concrete Right-of-Way Monument Found
- ⊙ Magnetic PK Spike Set
- ▲ 5/8" Iron Pin Set with Cap Stamped "Kelsner 7871"



00828

APPROVED LORAIN CO. MAP DEPT
DATE 7-31-01
PAGE 19-H
BY JHATFIELD
BEARINGS & DISTANCES ARE ASSUMED.



ERROR OF CLOSURE IS LESS THAN 1:10,000.

SCALE 1"=120'

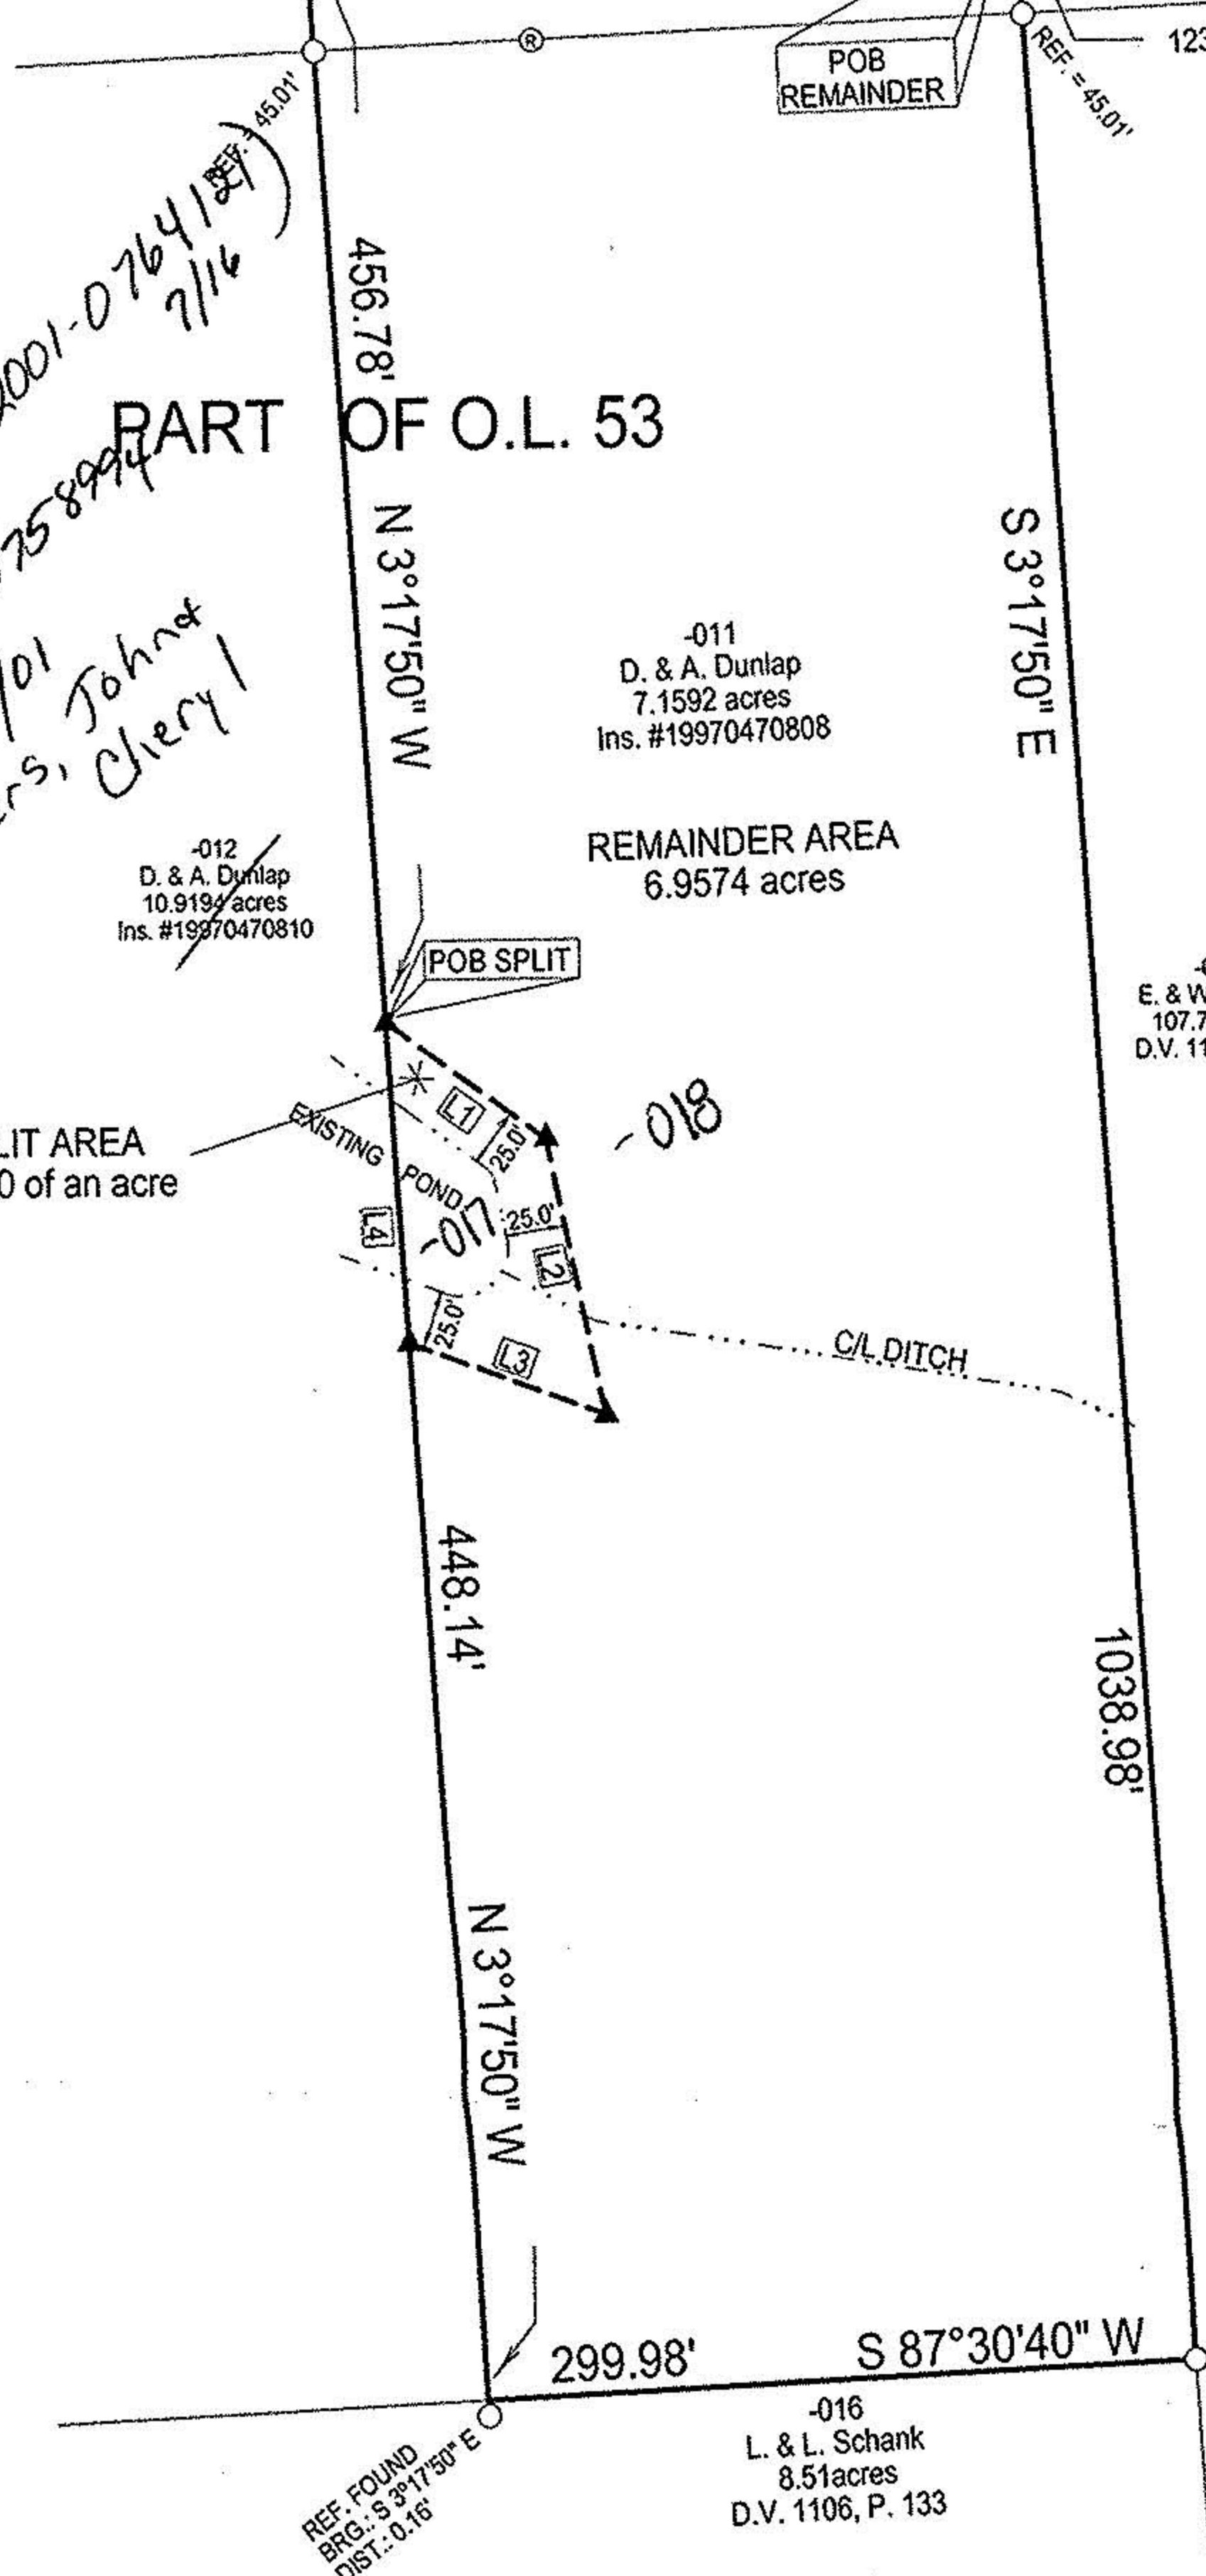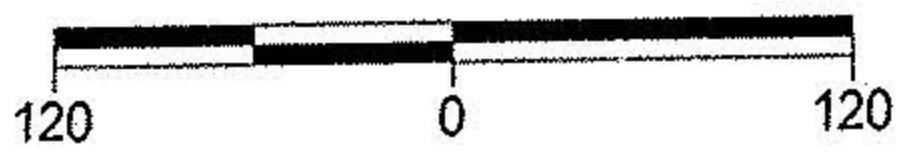

SPLIT		
Id	Bearing	Distance
L1	S 53°29'50" E	83.18'
L2	S 11°27'40" E	119.26'
L3	N 69°25'52" W	88.40'
L4	N 3°17'50" W	135.53'

DATE:	05/23/01
JOB NO.:	013365--(REF. FILE 97-2933)



LAUNDON • SIMON • KELSNER & ASSOC., INC.
 PROFESSIONAL LAND SURVEYORS
 110 MIDDLE AVE. • ELYRIA, OHIO • 44035
 PHONE (440) 322-7625

Alex Kelsner
 Alex Kelsner RLS #7871