



19-04-049-000 01
17916
19-D

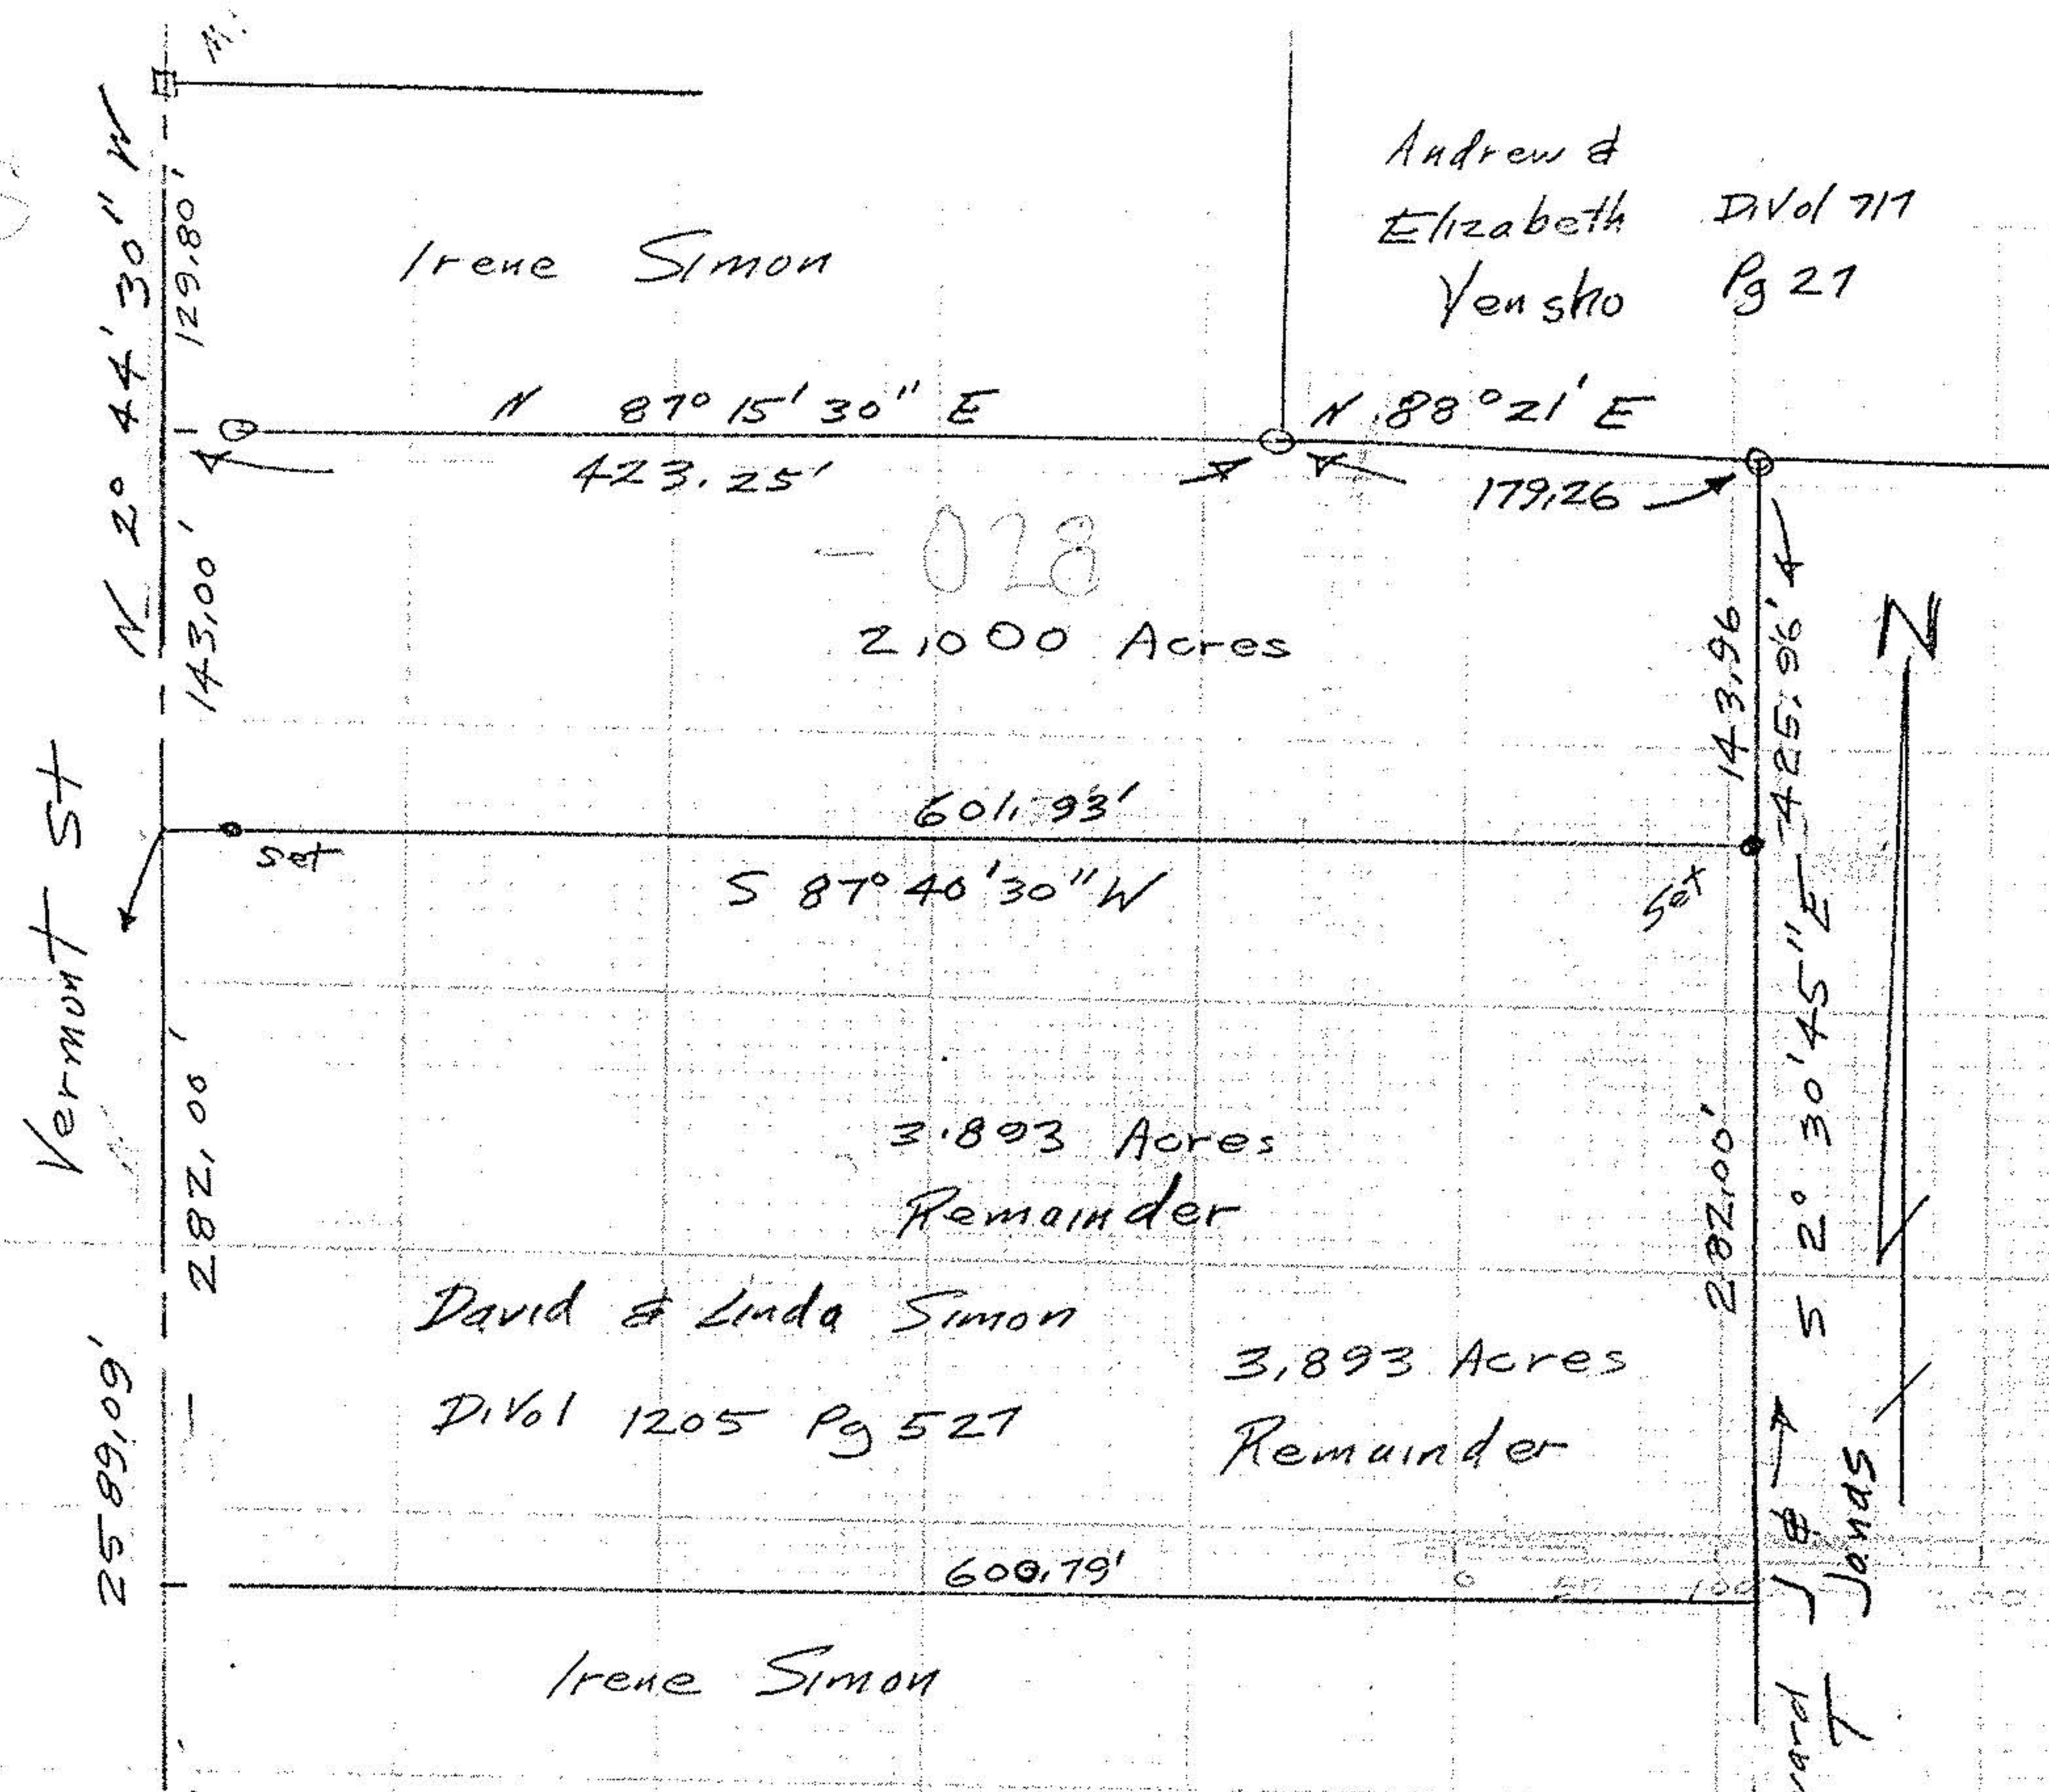


#17916

APPROVED
LORAIN CO.
MAP DEPT.
DATE 4-29-88
PAGE 17-D
BY CAROL FRANCIS
VLS
REDACTED 17916


Survey for David Simon
2,000 Acre Parcel Split
Original Lot 49 Tract 4
Penfield Township
Lorain County Ohio
Scale 1"=100' January 1988
Revised Apr 27, 1988

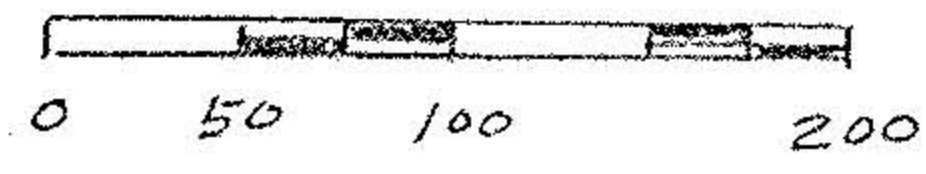

John Pozzywal
Reg Surveyor
5292

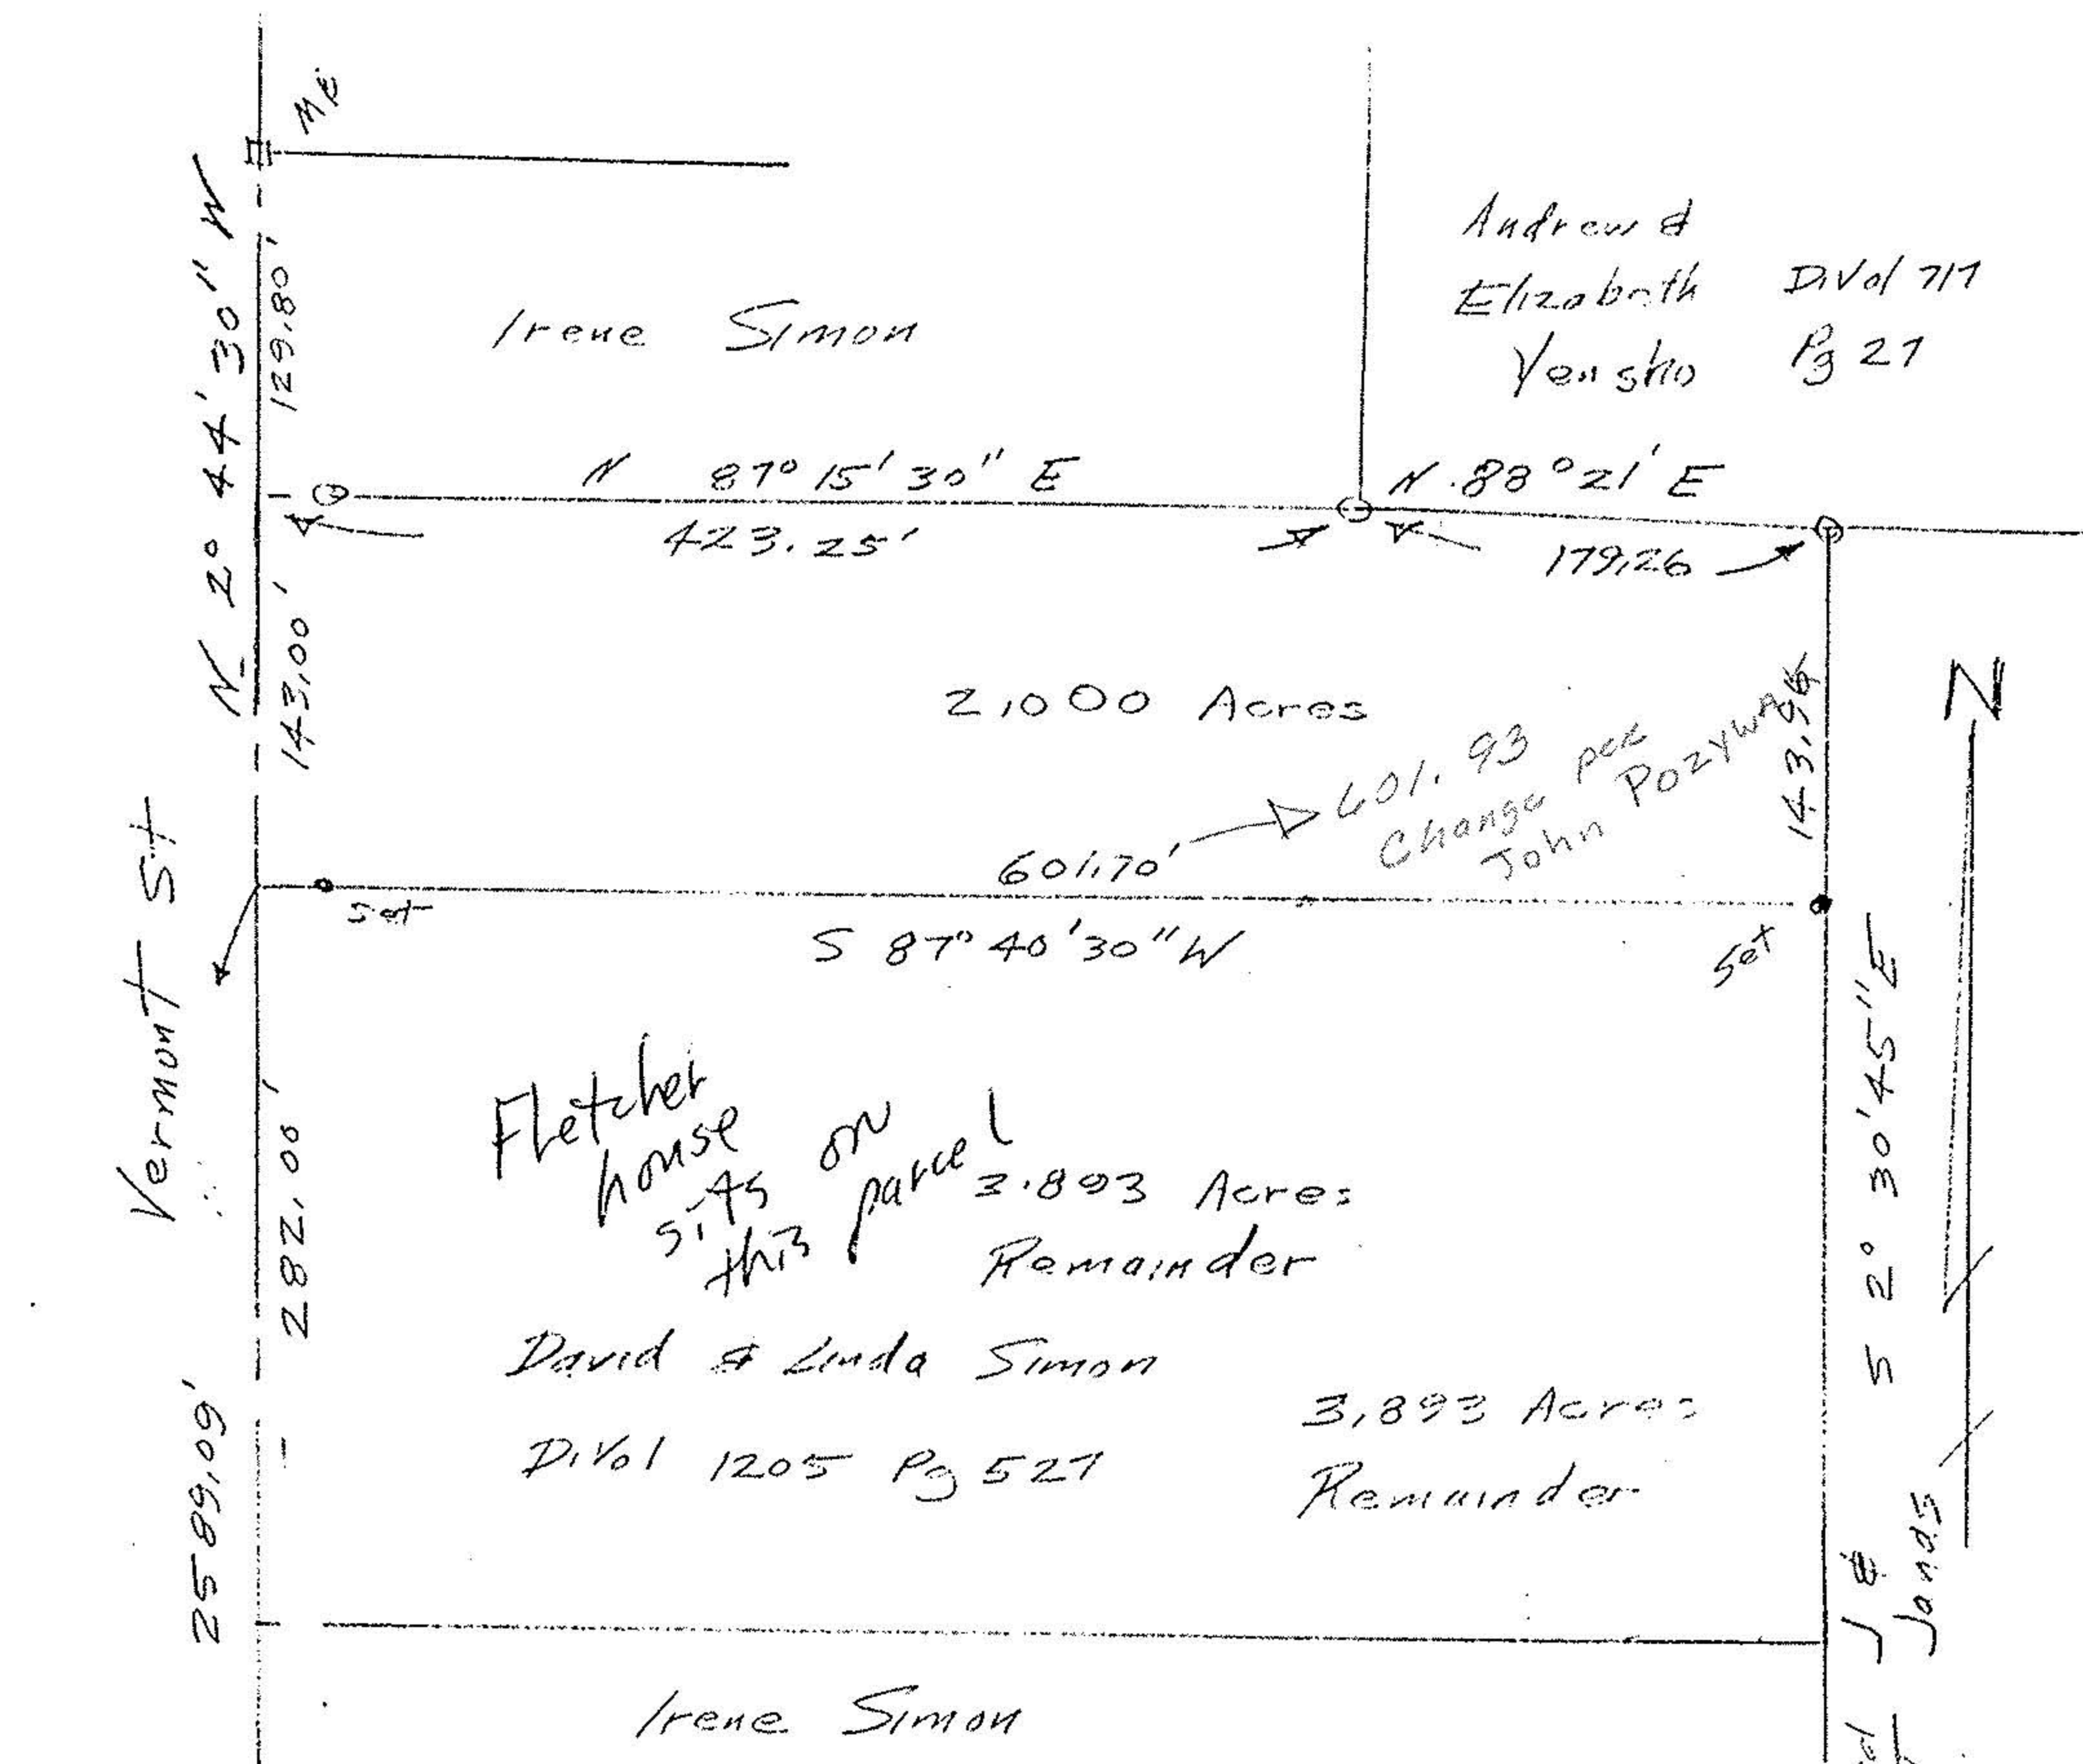

Survey for David Simon
2,000 Acre Parcel Split
Original Lot 49 Tract 4
Penfield Township
Lorain County Ohio
Scale 1"=100' January 1988

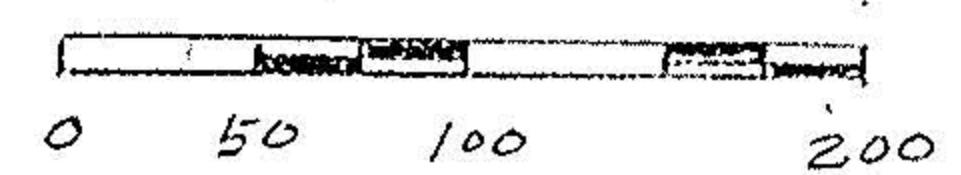

John Pozzywal
Reg Surveyor
5292