


Neils Larson
Vol. 319-304

N88:40'E
Fence 1123.93

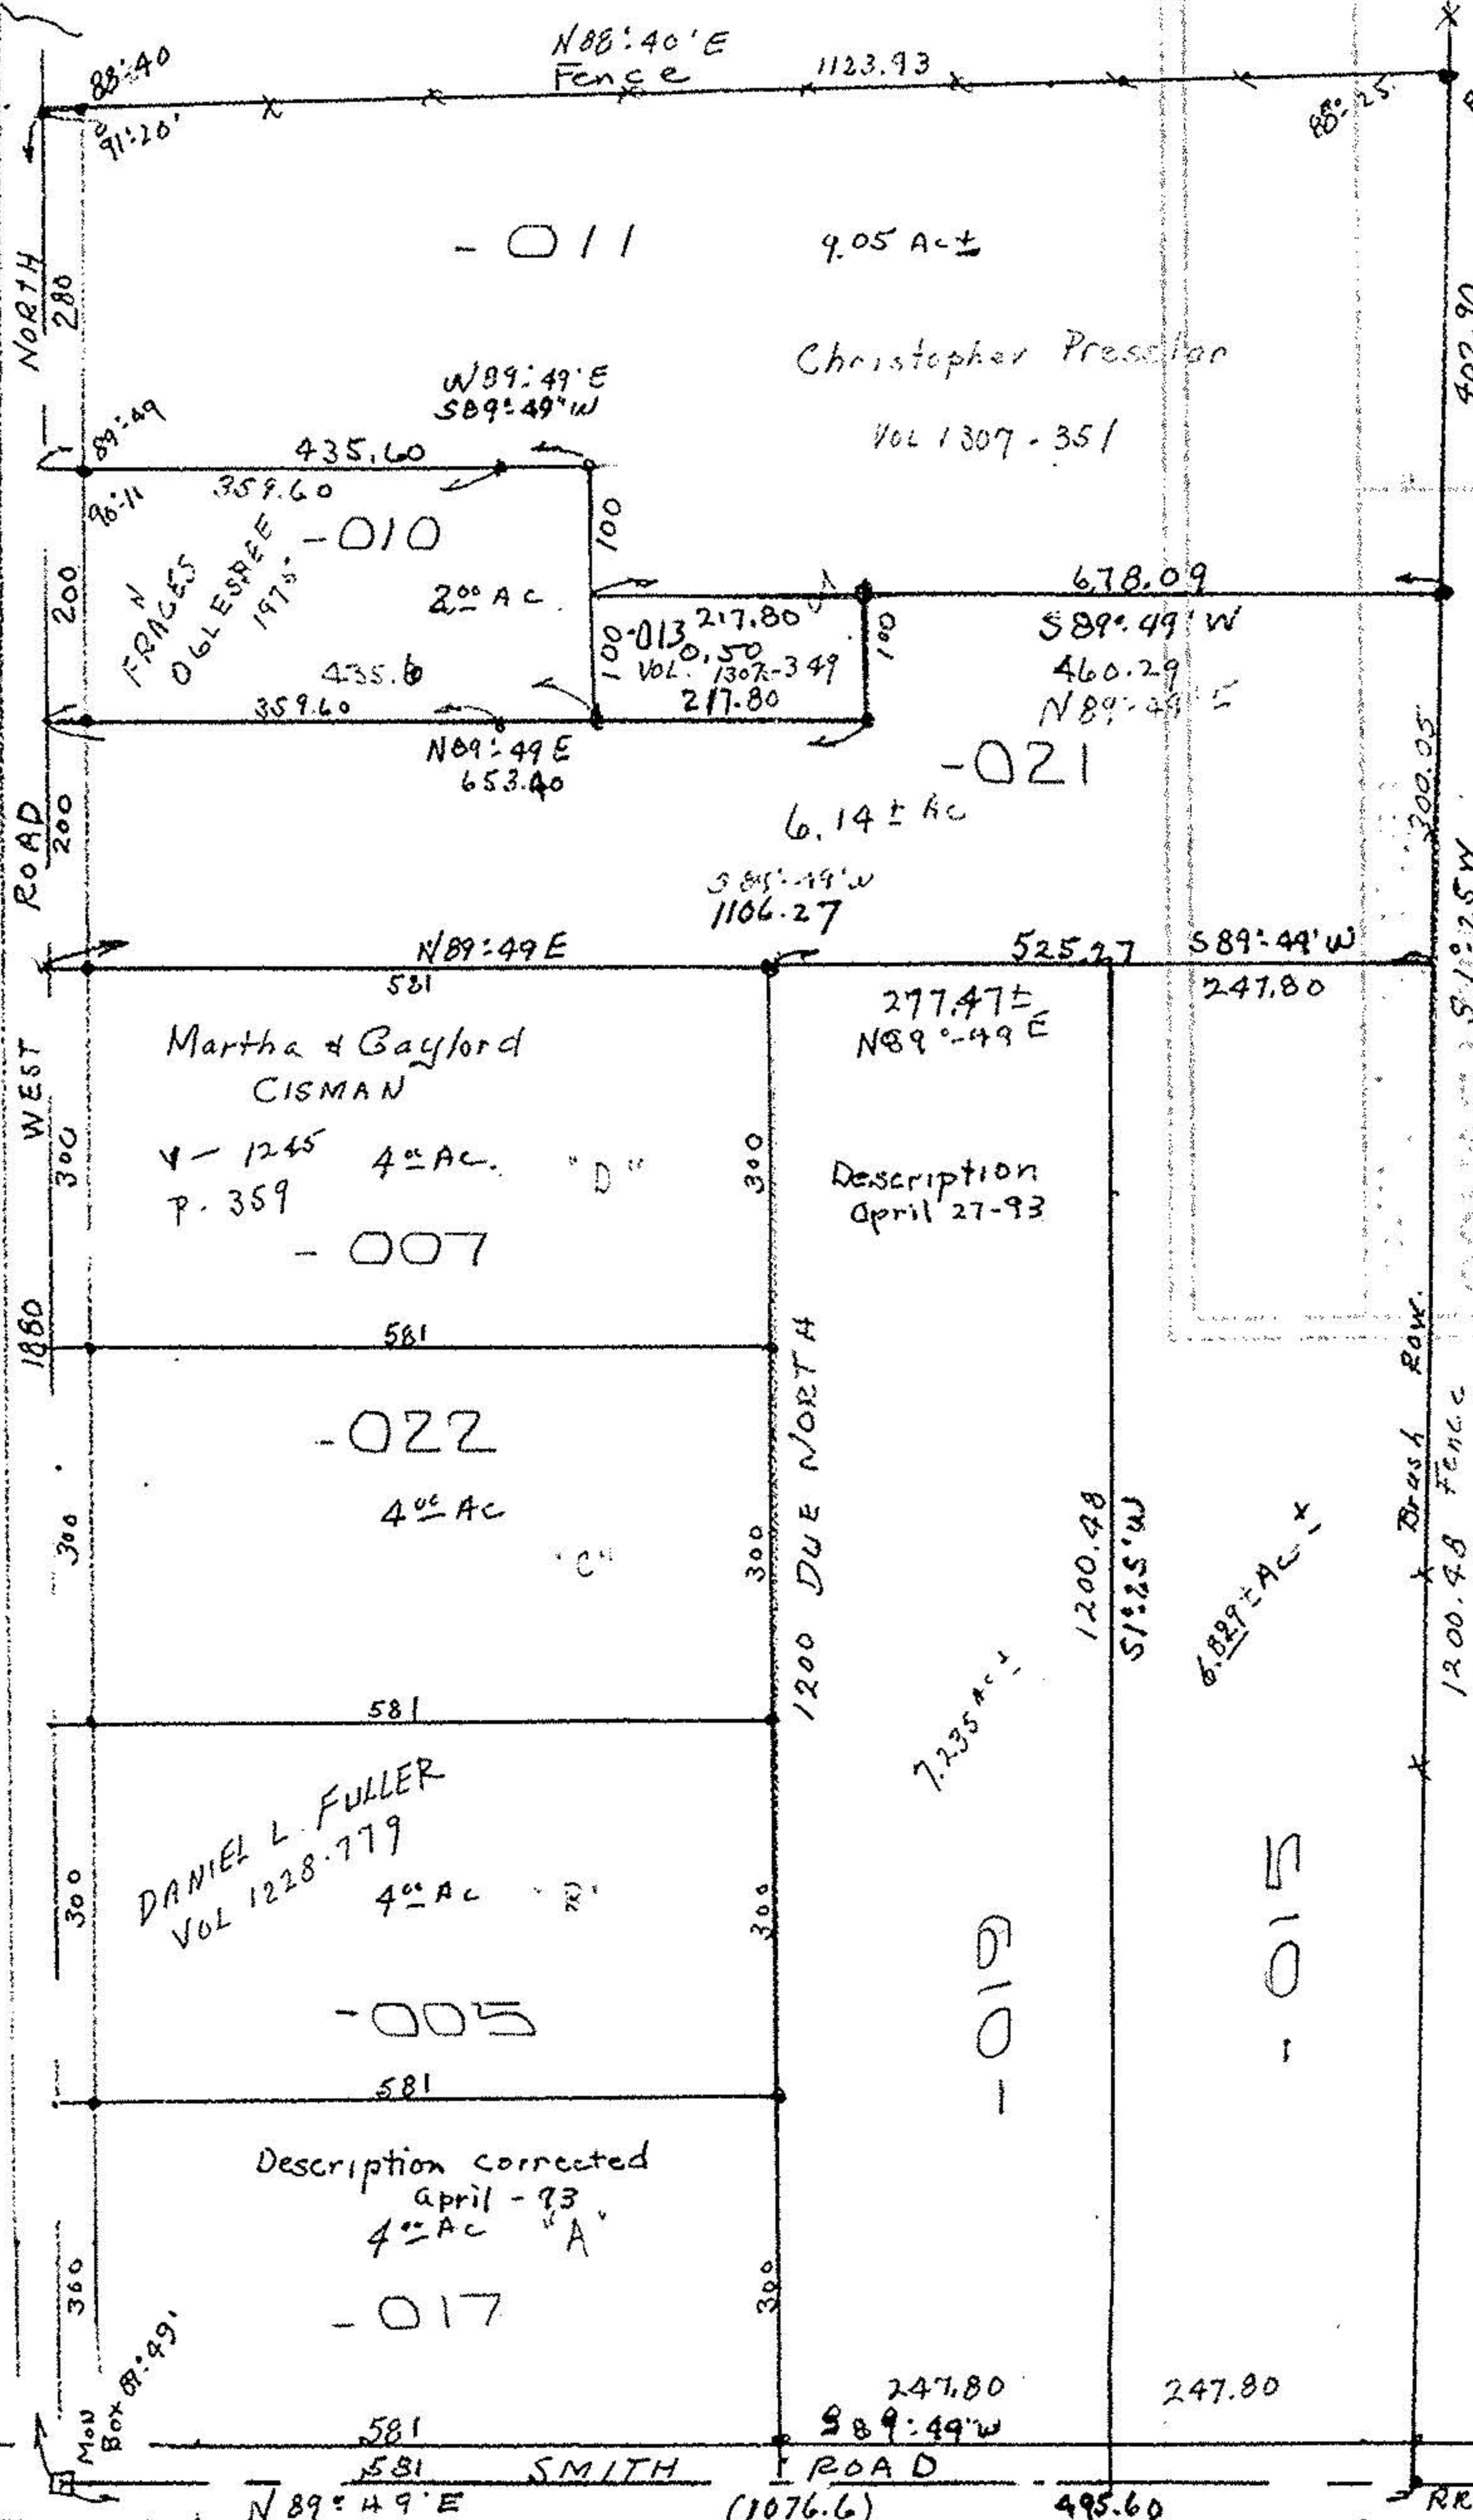

Christopher Preslar
Vol 1307-351

FRANCES
O'LEARY
1975
-010
2.00 AC

Martha & Baylord
CISMAN
V-1245
P. 359
4.00 AC
"D"
-007

DANIEL L. FULLER
VOL 1228-779
4.00 AC
"A"
-005

Description corrected
April - 93
4.00 AC
"A"
-017

Description
April 27-93

Map of Part of Lot 9 Tract 1 Penfield Twp. Lorain Co. Ohio
Scale 1"=200'
April 10, 1979
Revised Dec. 8, 1979
By A. F. Koeppe Reg. Surveyor

Donald C
CLARK
LINDEN
VOL. 929-146
Pg. 146

Survey done and returned
Revised by Koeppe Reg. Surveyor

20724

APPROVED
LORAIN CO.
MAP DEPT.

DATE 2-3-94

RRS PAGE 19 E

BY CAROLYN
FRANCKS

MAP # 20724