


17.2

H A M I L T O N

11

006-006

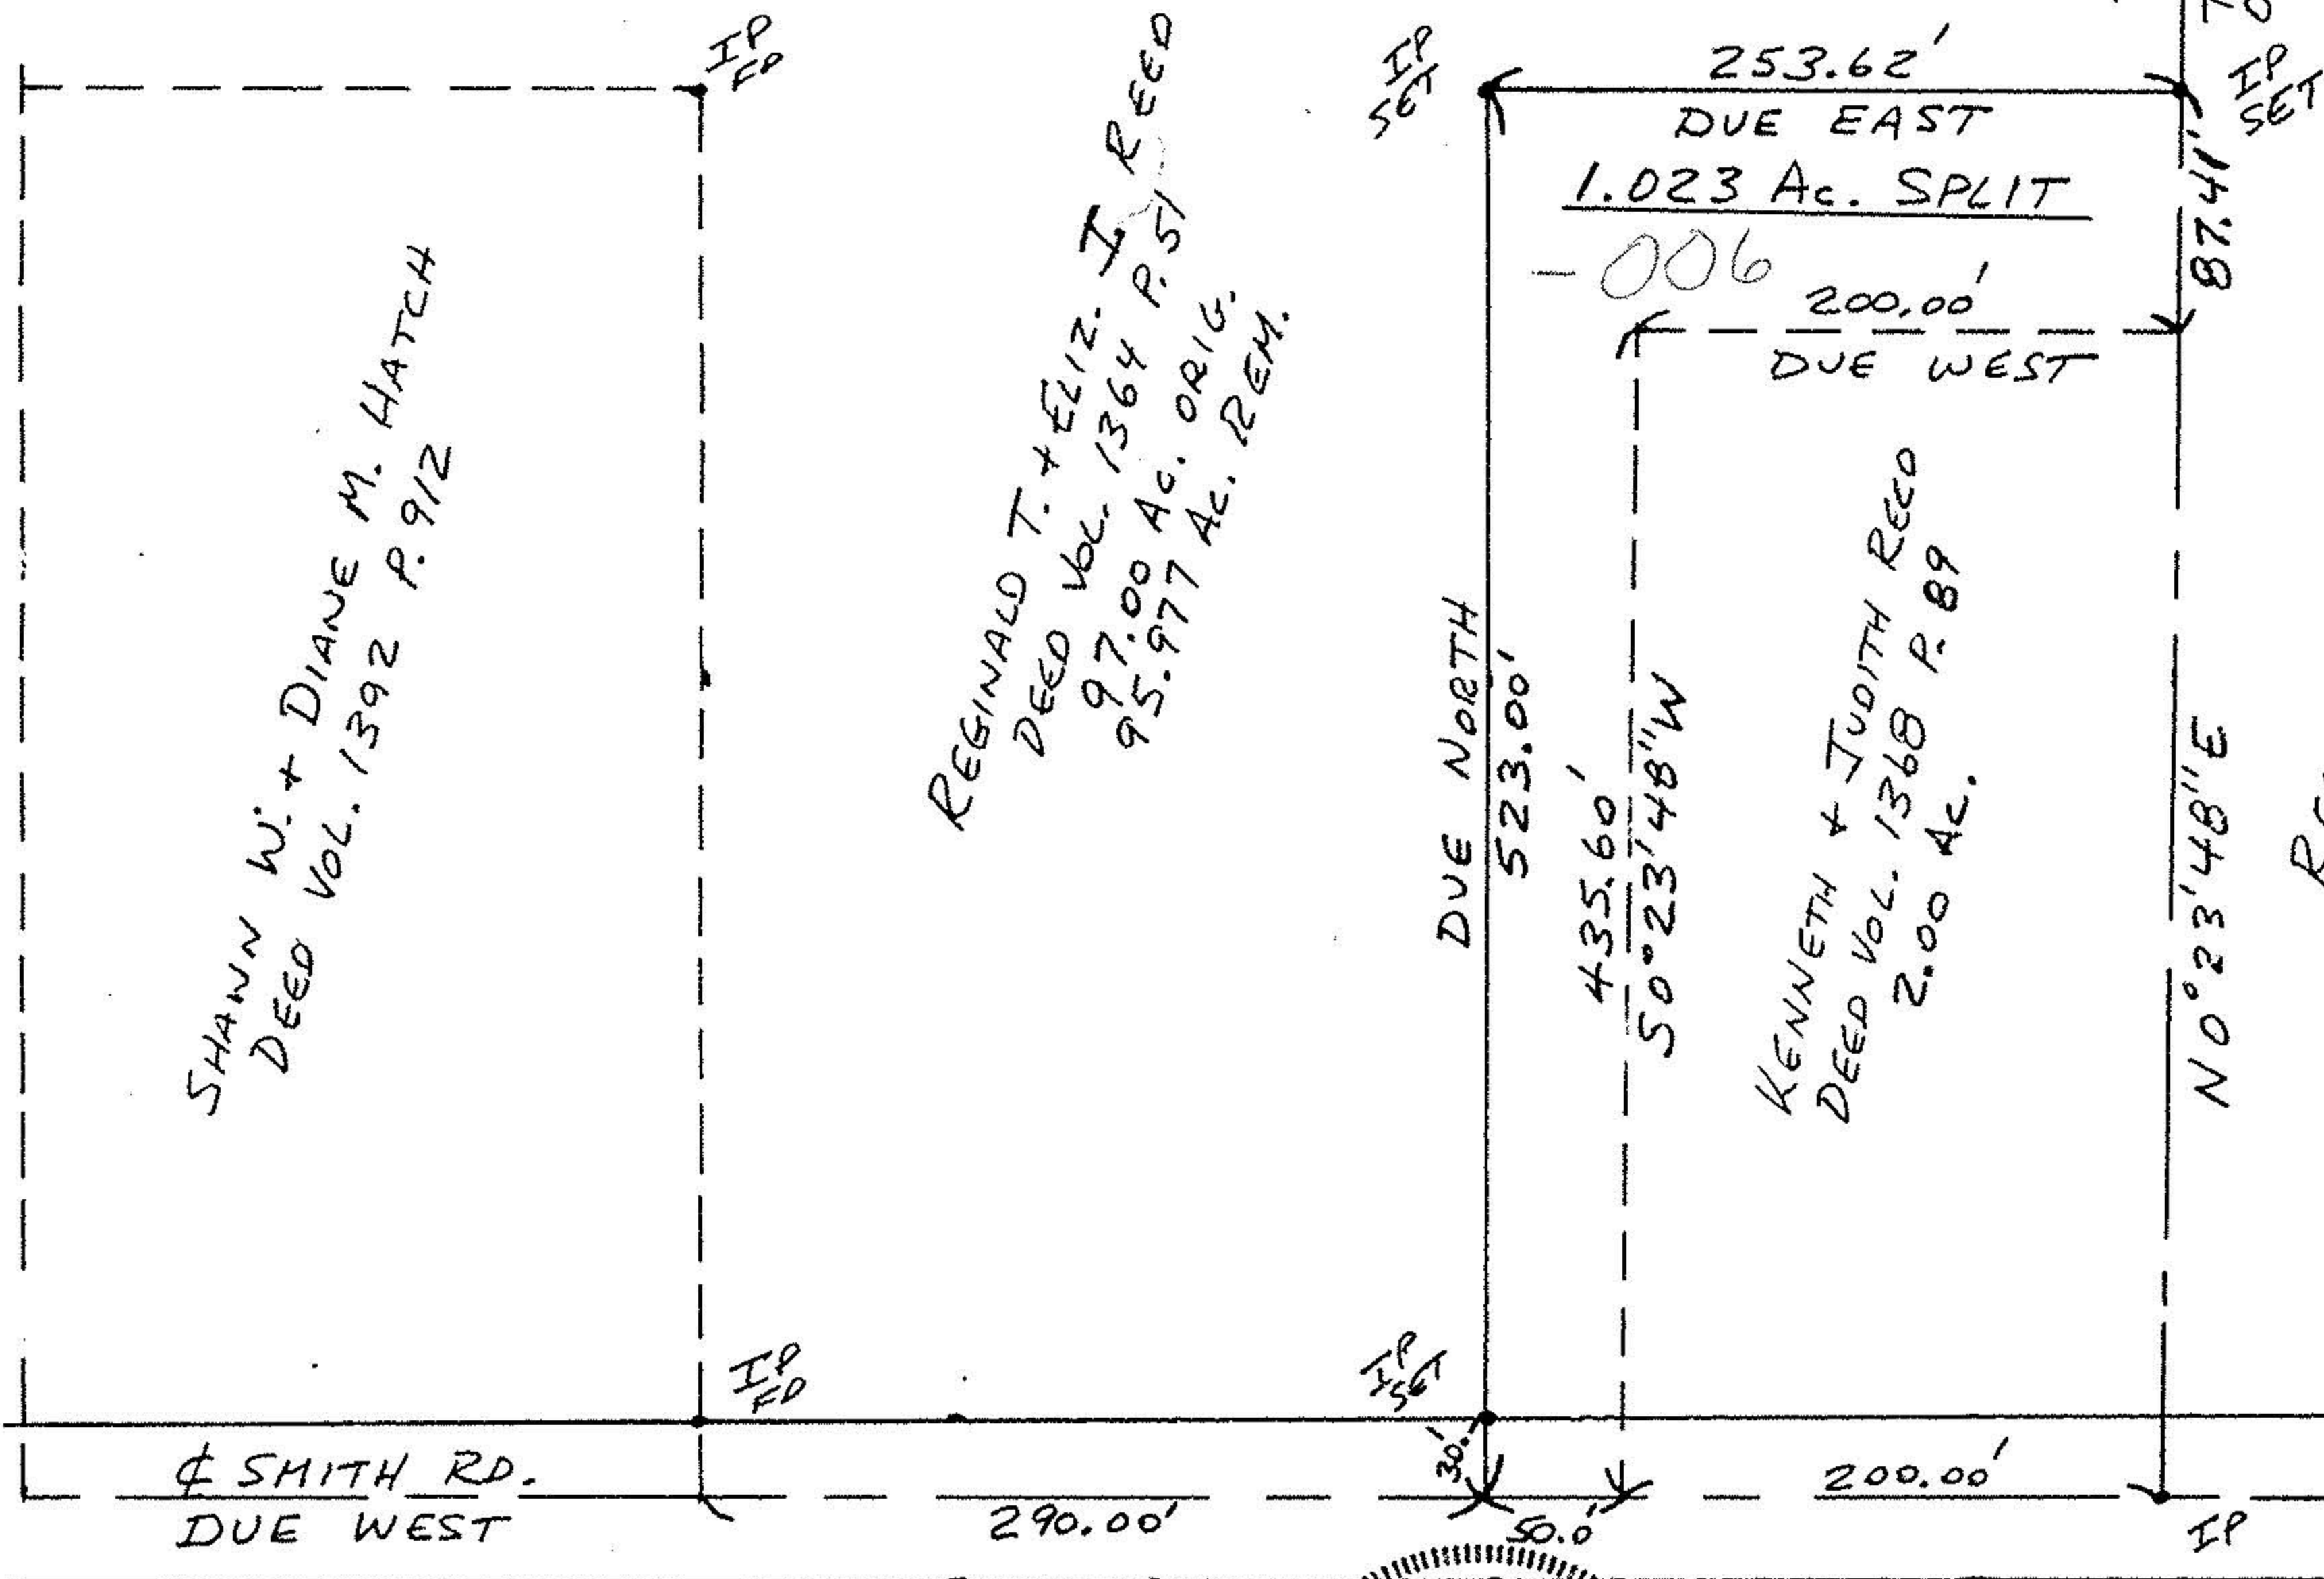

SHANN W. + DIANE M. HATCH
DEED VOL. 1392 P. 912

REGINALD T. + ELIZ. J. REED
DEED VOL. 1364 P. 51
97.00 AC. ORIG.
95.977 AC. REM.

KENNETH + JUDITH REED
DEED VOL. 1368 P. 89
2.00 AC.

REGINALD T. + ELIZ. REED
DEED VOL. 626 P. 85


NORTH
SCALE 1"=100'

#18570

APPROVED
LORAIN CO.
MAP DEPT.

DATE 8-8-89
LORAIN Co.
MADINA Co. 19-E
BY CAROLYN FRANCIS

VOID AFTER #18570

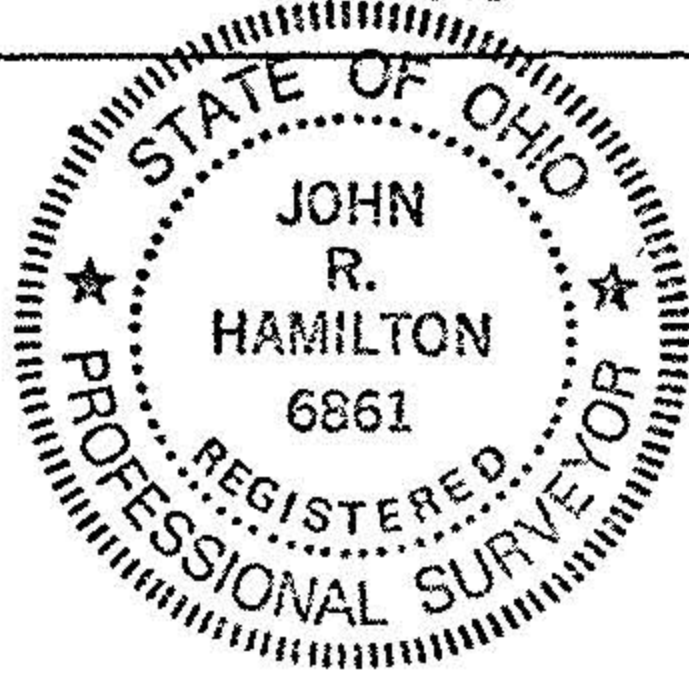

MAP OF SURVEY FOR
PENFIELD TWP. - TRACT 1 - D.L. #6
JUNE 1989 SCALE 1"=100'
JOHN R. HAMILTON
REG. SURV. #6861