



LAUNDON . SIMON . CAHL & ASSOC. INC.  
 CONSULTING ENGINEERS & SURVEYORS  
 219 COURT ST. ELYRIA, OHIO 44035

SURVEY FOR:

GEORGE JACKSON JR.

Orig. Lot 23	City of	Date SEPT. '91 Scale 1"=100
Orig. Sec 1	Village of	Dwn. by R.G.S. Chkd. by R.C.
Tract	County of LORAIN	Job No. 91-2085 F.B.
Township of PENFIELD	State of OHIO	Printed

GEORGE JACKSON JR.  
 D.V. 1377 P 718

Rmac - 013 15.31 Ac. Calc

19653

APPROVED  
 LORAIN CO.  
 MAP DEPT.

DATE 11-14-91  
 PAGE 19-G  
 CAROLYN  
 BY FRANCIS  
 VOID AFTER # 10653

1 P. Set S 89° 33' 28" E. 1 P. Set  
 125.00

250.00 E  
 250.00 W  
 250.00 S  
 250.00 N  
 - 016  
 1.00436 Ac


EDW. F. & NAOMI J. ALBRECHT  
 V. 378 P. 187



-009


FOSTER

Lorain Co.  
 CO. LINE  
 Medina Co.

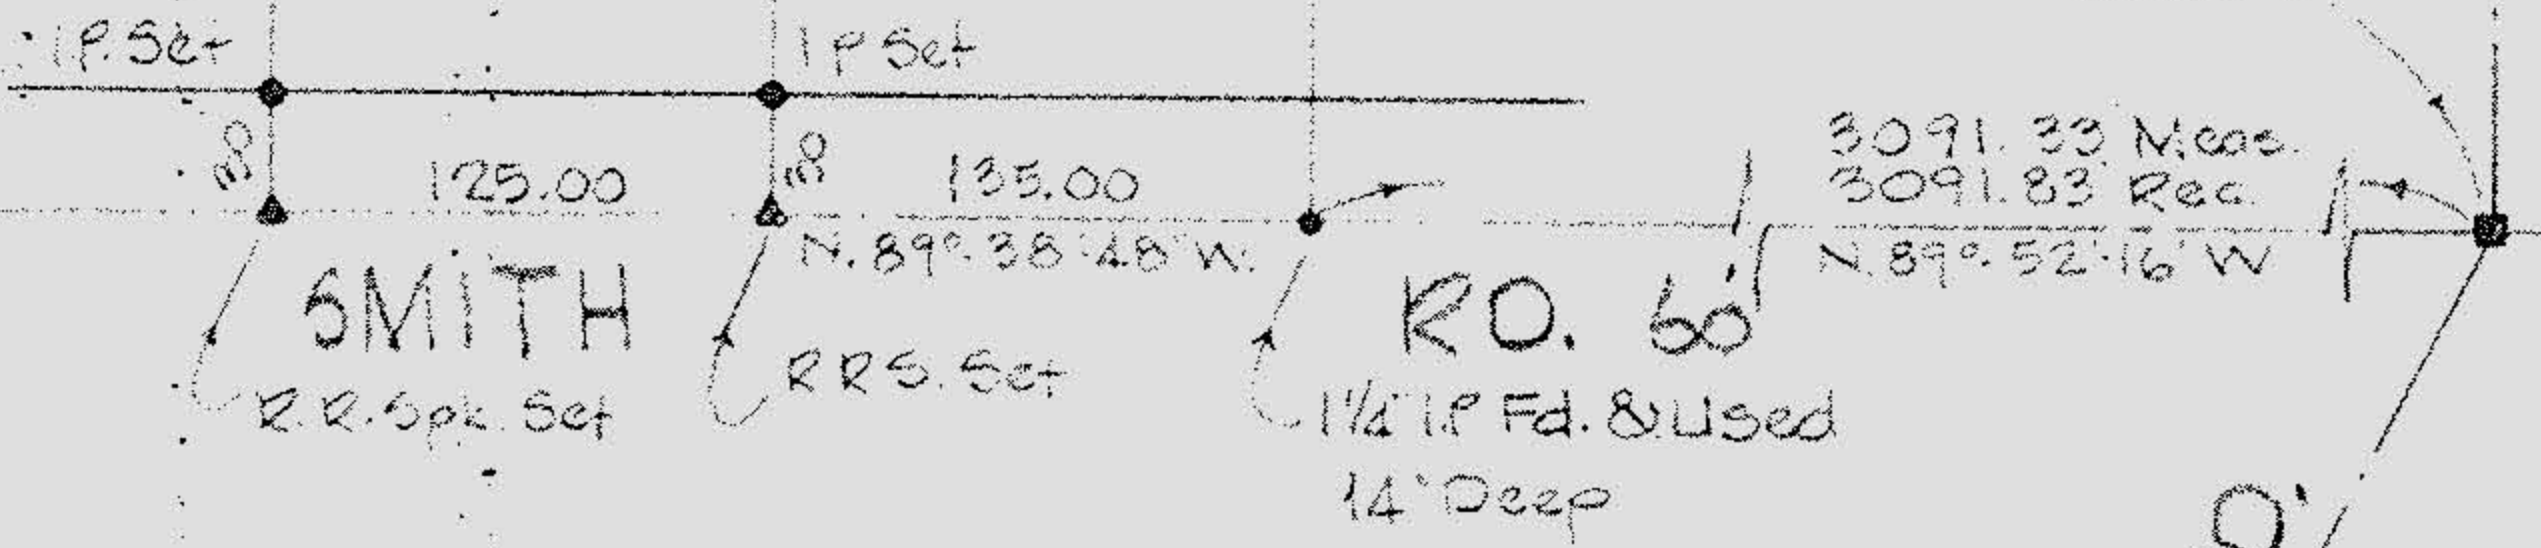

1 P. M.B. Fd. Used

3091.33 Meas.  
 3091.83 Rec.  
 N. 89° 52' 16" W

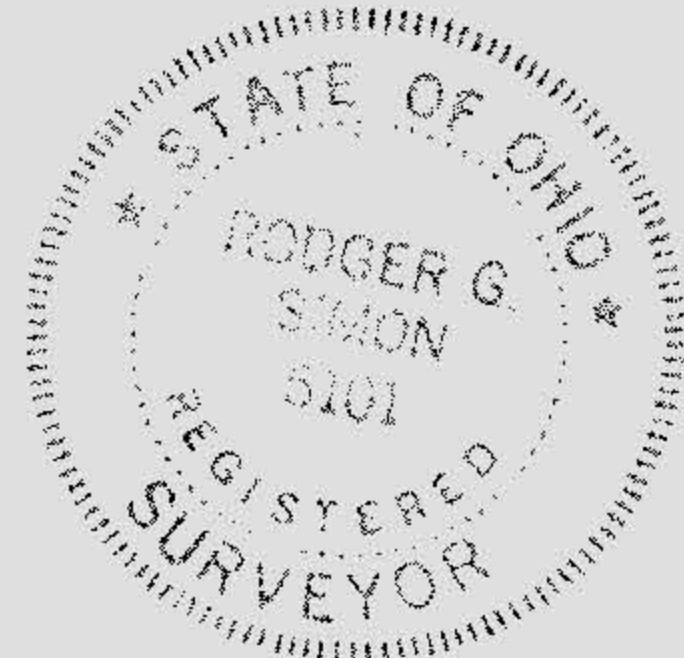

RIVER CORNERS RD.

19-01-025-000-0

19653

19-05