
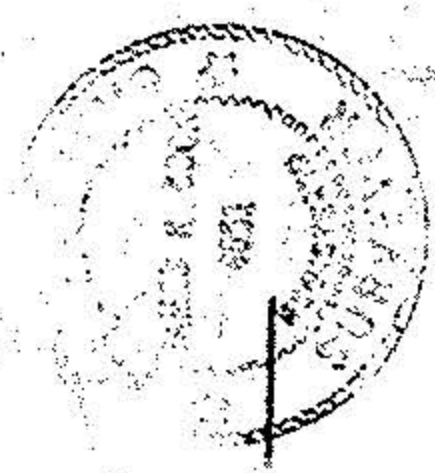


19-01-063
19-14
9975
19A

19-01-063
-000004

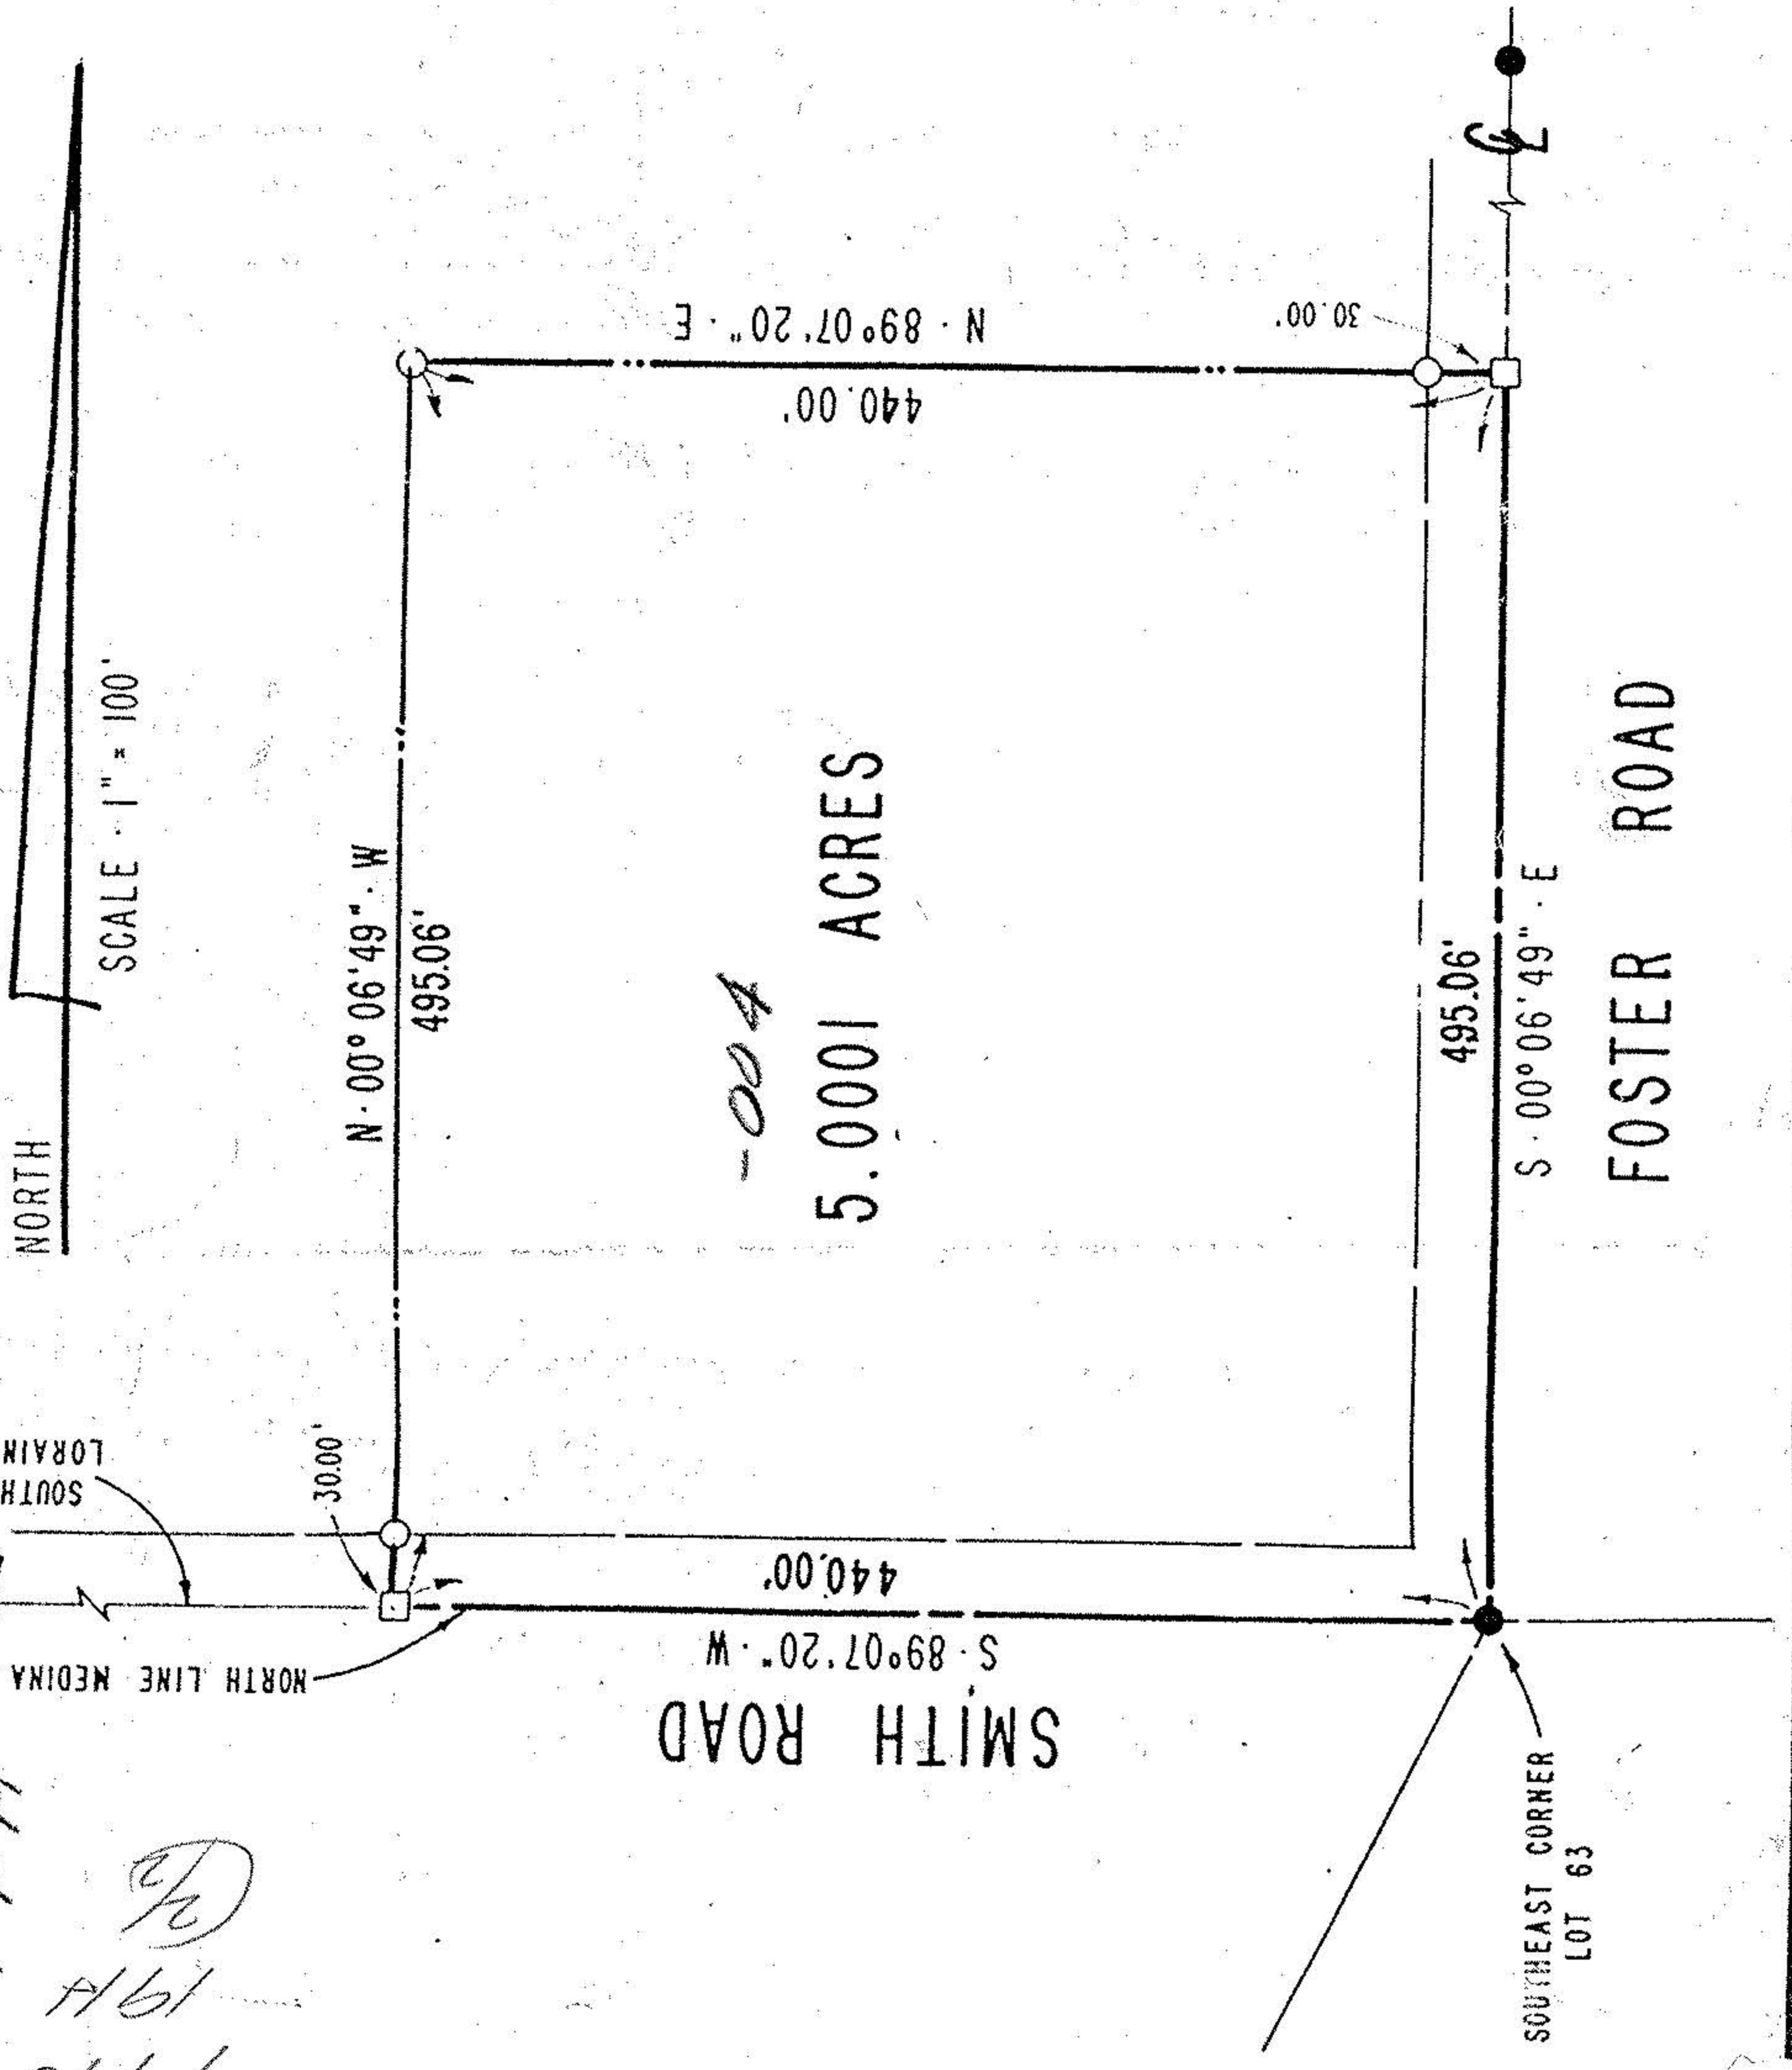

JAMES R. BOCK · P.S.
REG. SURVEYOR No 6051

- IRON PIN FOUND
- R.R. SPIKE FOUND
- ⊠ P.K. NAIL FOUND
- ▲ BREAK POINT FOUND
- ⊞ STONE FOUND
- FENCE POST FOUND & USED
- IRON PIN SET
- R.R. SPIKE SET
- ⊞ P.K. NAIL SET
- ▲ BREAK POINT SET

OWNER: MARGARET PACKARD ETAL

STATE OF OHIO, COUNTY OF LORAIN

TOWNSHIP OF PENFIELD, TRACT

I, LOT 63

DATE: AUG., 1976 PROJECT: 76555