
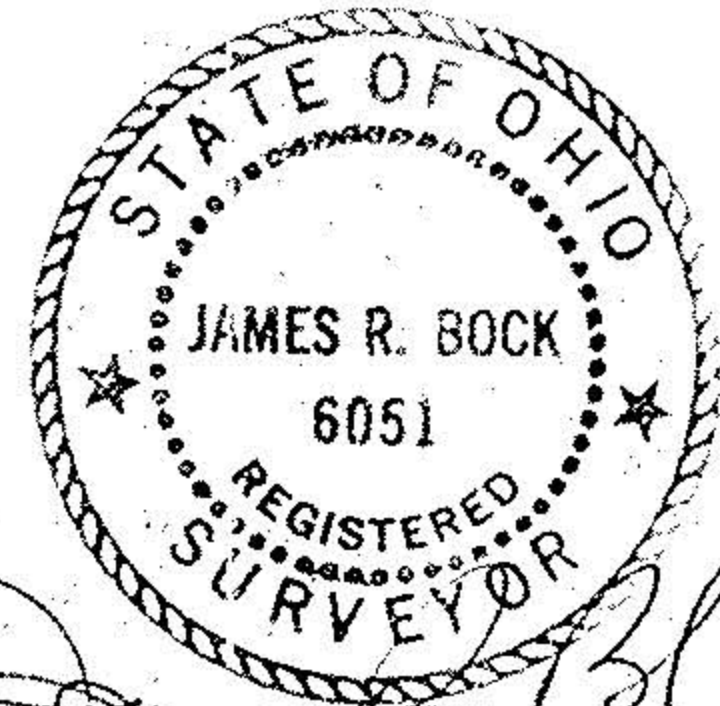


22-A

10556

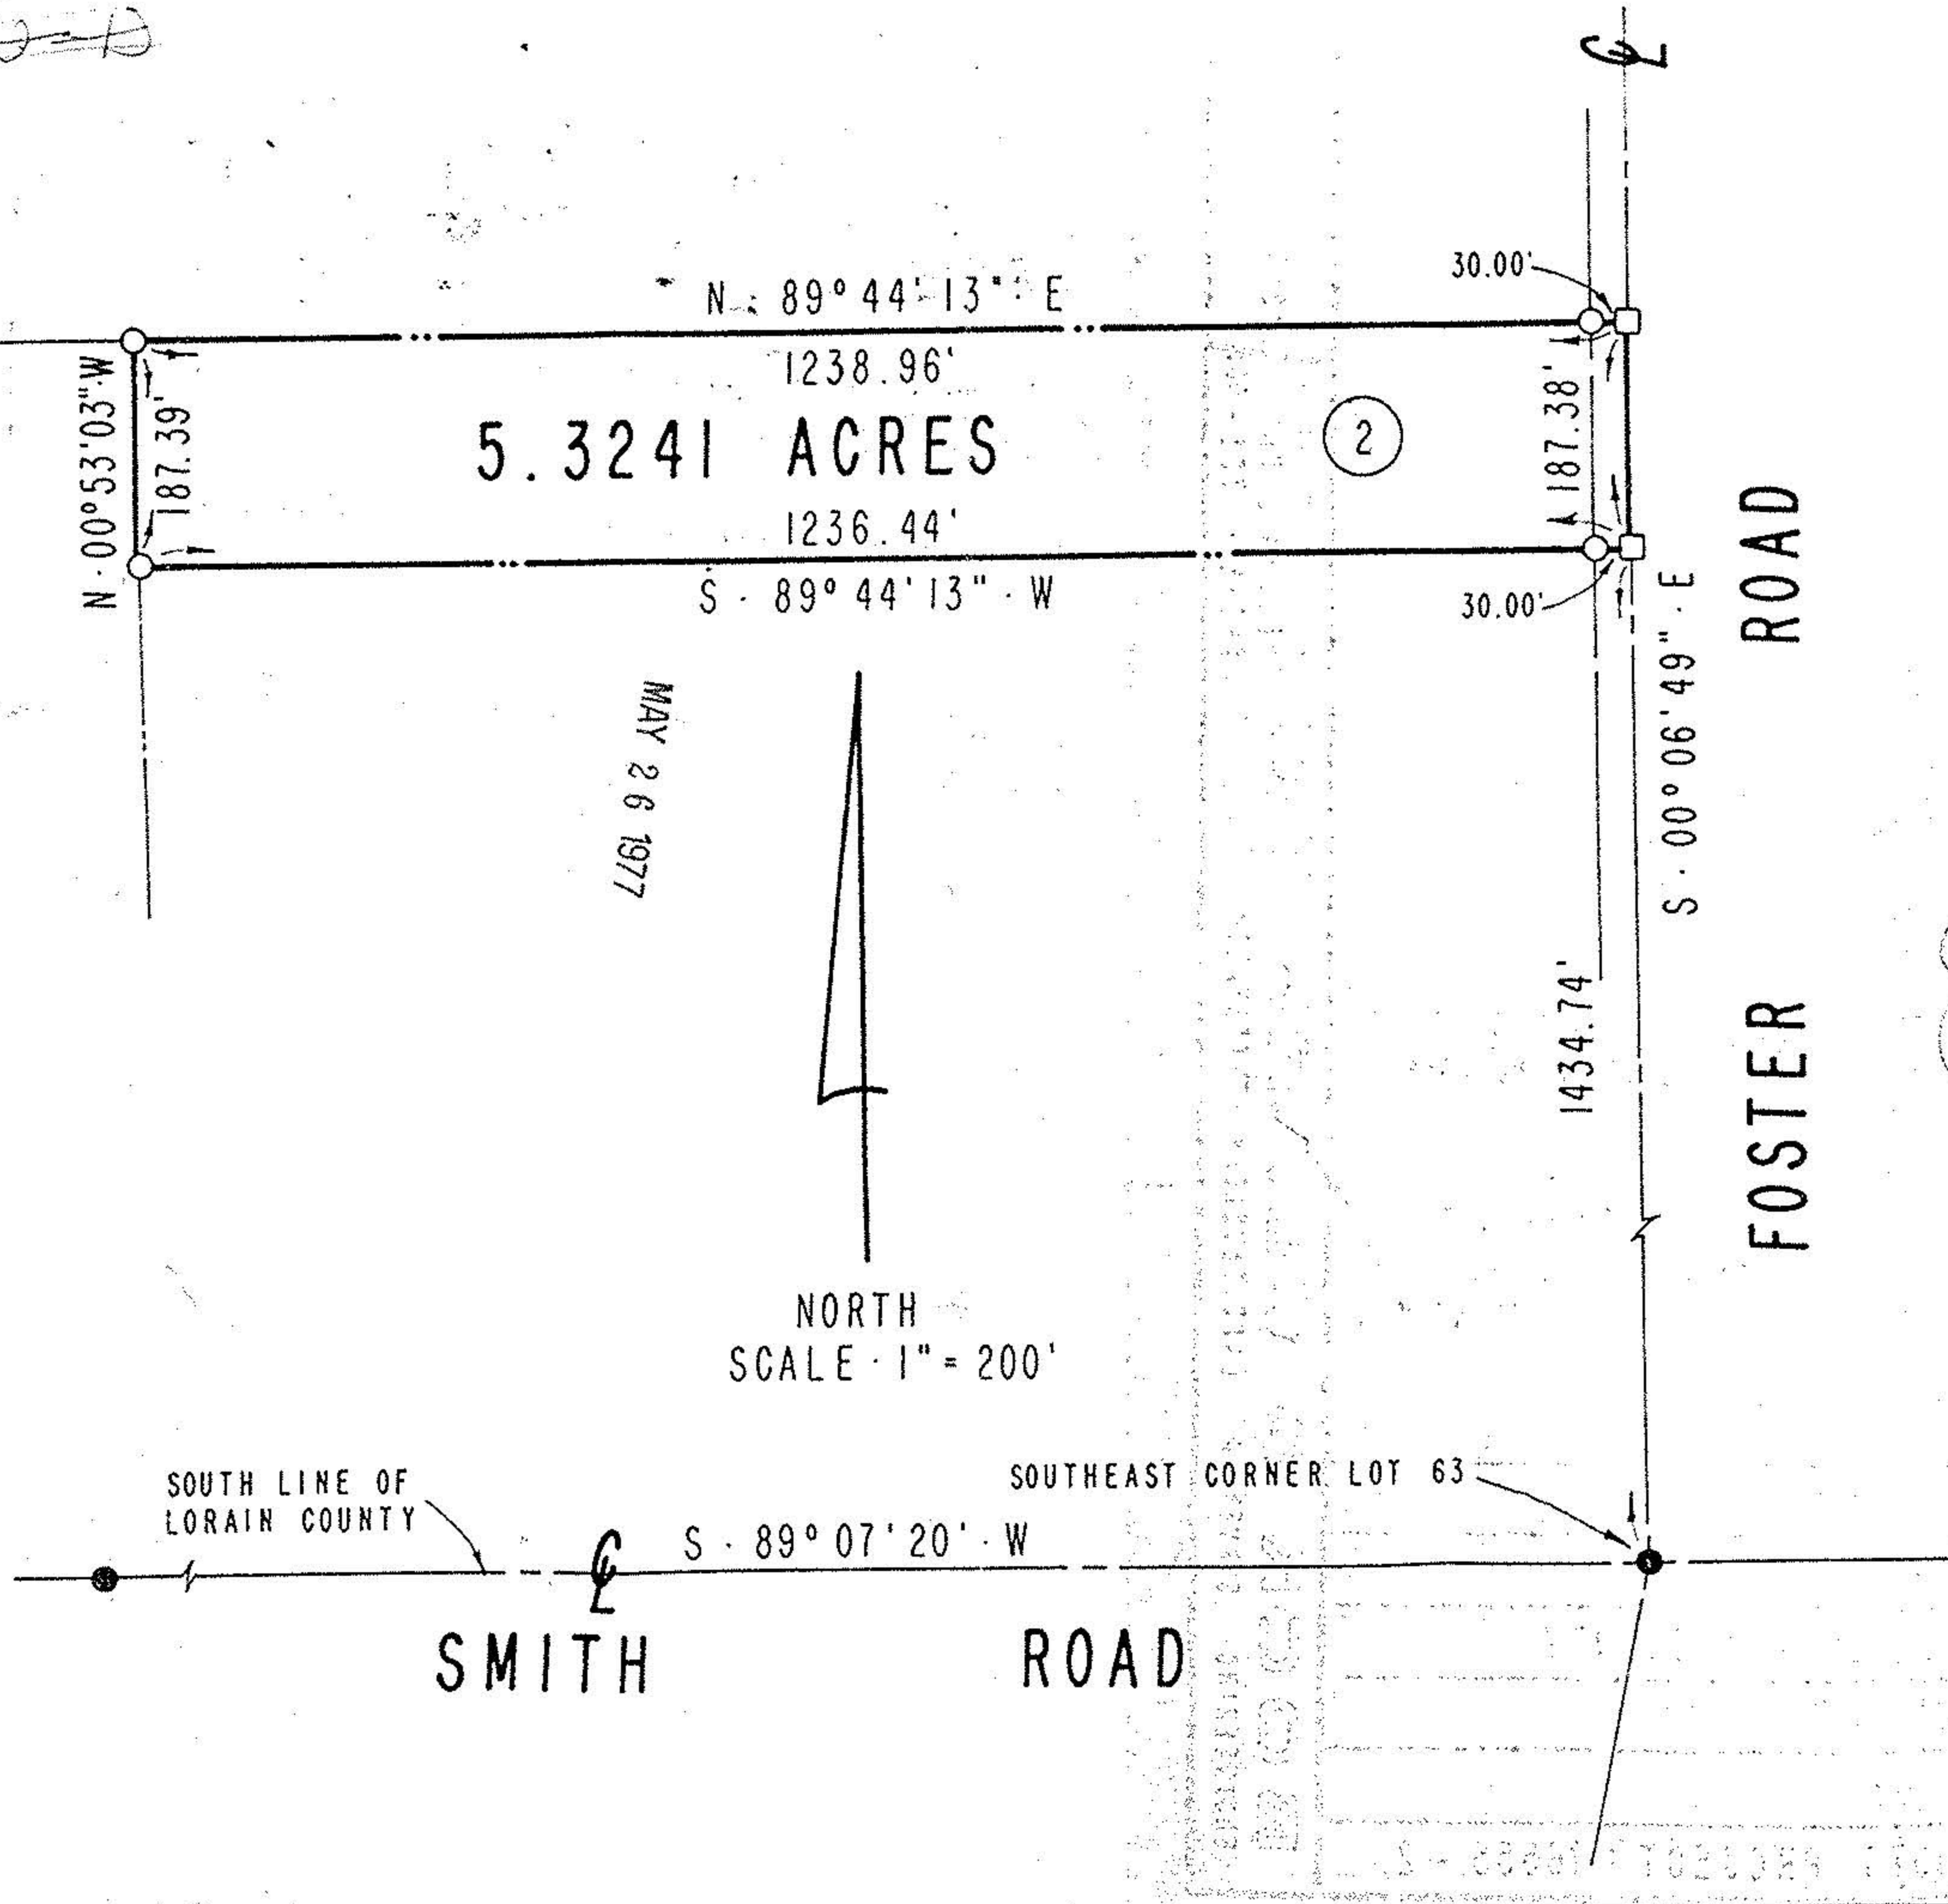

JAMES R. BOCK P.S.
REG. SURVEYOR No. 6051

CARL M. CLARK P.S.
REG. SURVEYOR No. 6358

- IRON PIN FOUND
- R.R. SPIKE FOUND
- ✕ P.K. NAIL FOUND
- ▲ BREAK POINT FOUND
- ⊠ STONE FOUND
- FENCE POST FOUND & USED
- IRON PIN SET
- R.R. SPIKE SET
- ⊠ P.K. NAIL SET
- △ BREAK POINT SET

OWNER: THE SPENCER
LAND COMPANY
STATE OF OHIO, LORAIN COUNTY
PENFIELD TOWNSHIP
TRACT 1, LOT 63
DATE: DEC., 1976 PROJECT: 76555 - 2

BOCK & CLARK INC
 ENGINEERING SURVEYING · LAND DEVELOPMENT RESEARCH
 219 E. LIBERTY ST.
 MEDINA, OHIO 44256
 PHONE · 725-0011