




LAUNDON • SIMON • CAHL & ASSOC., INC.
CONSULTING ENGINEERS & SURVEYORS
110 MIDDLE AVE. ELYRIA, O. 44035

SURVEY FOR:
JEFFREY M. & DIANA B. SMITH

Orig. Lot 58	City of	Date OCT. '93 Scale 1"=200'
Orig. Sec	Village of	Dwn. by R.G.S. Chkd. by R.C
Tract 2	County of LORAIN	Job No. F.B.
Township of PENFIELD	State of OHIO	Printed

REF. JOB 83-1215

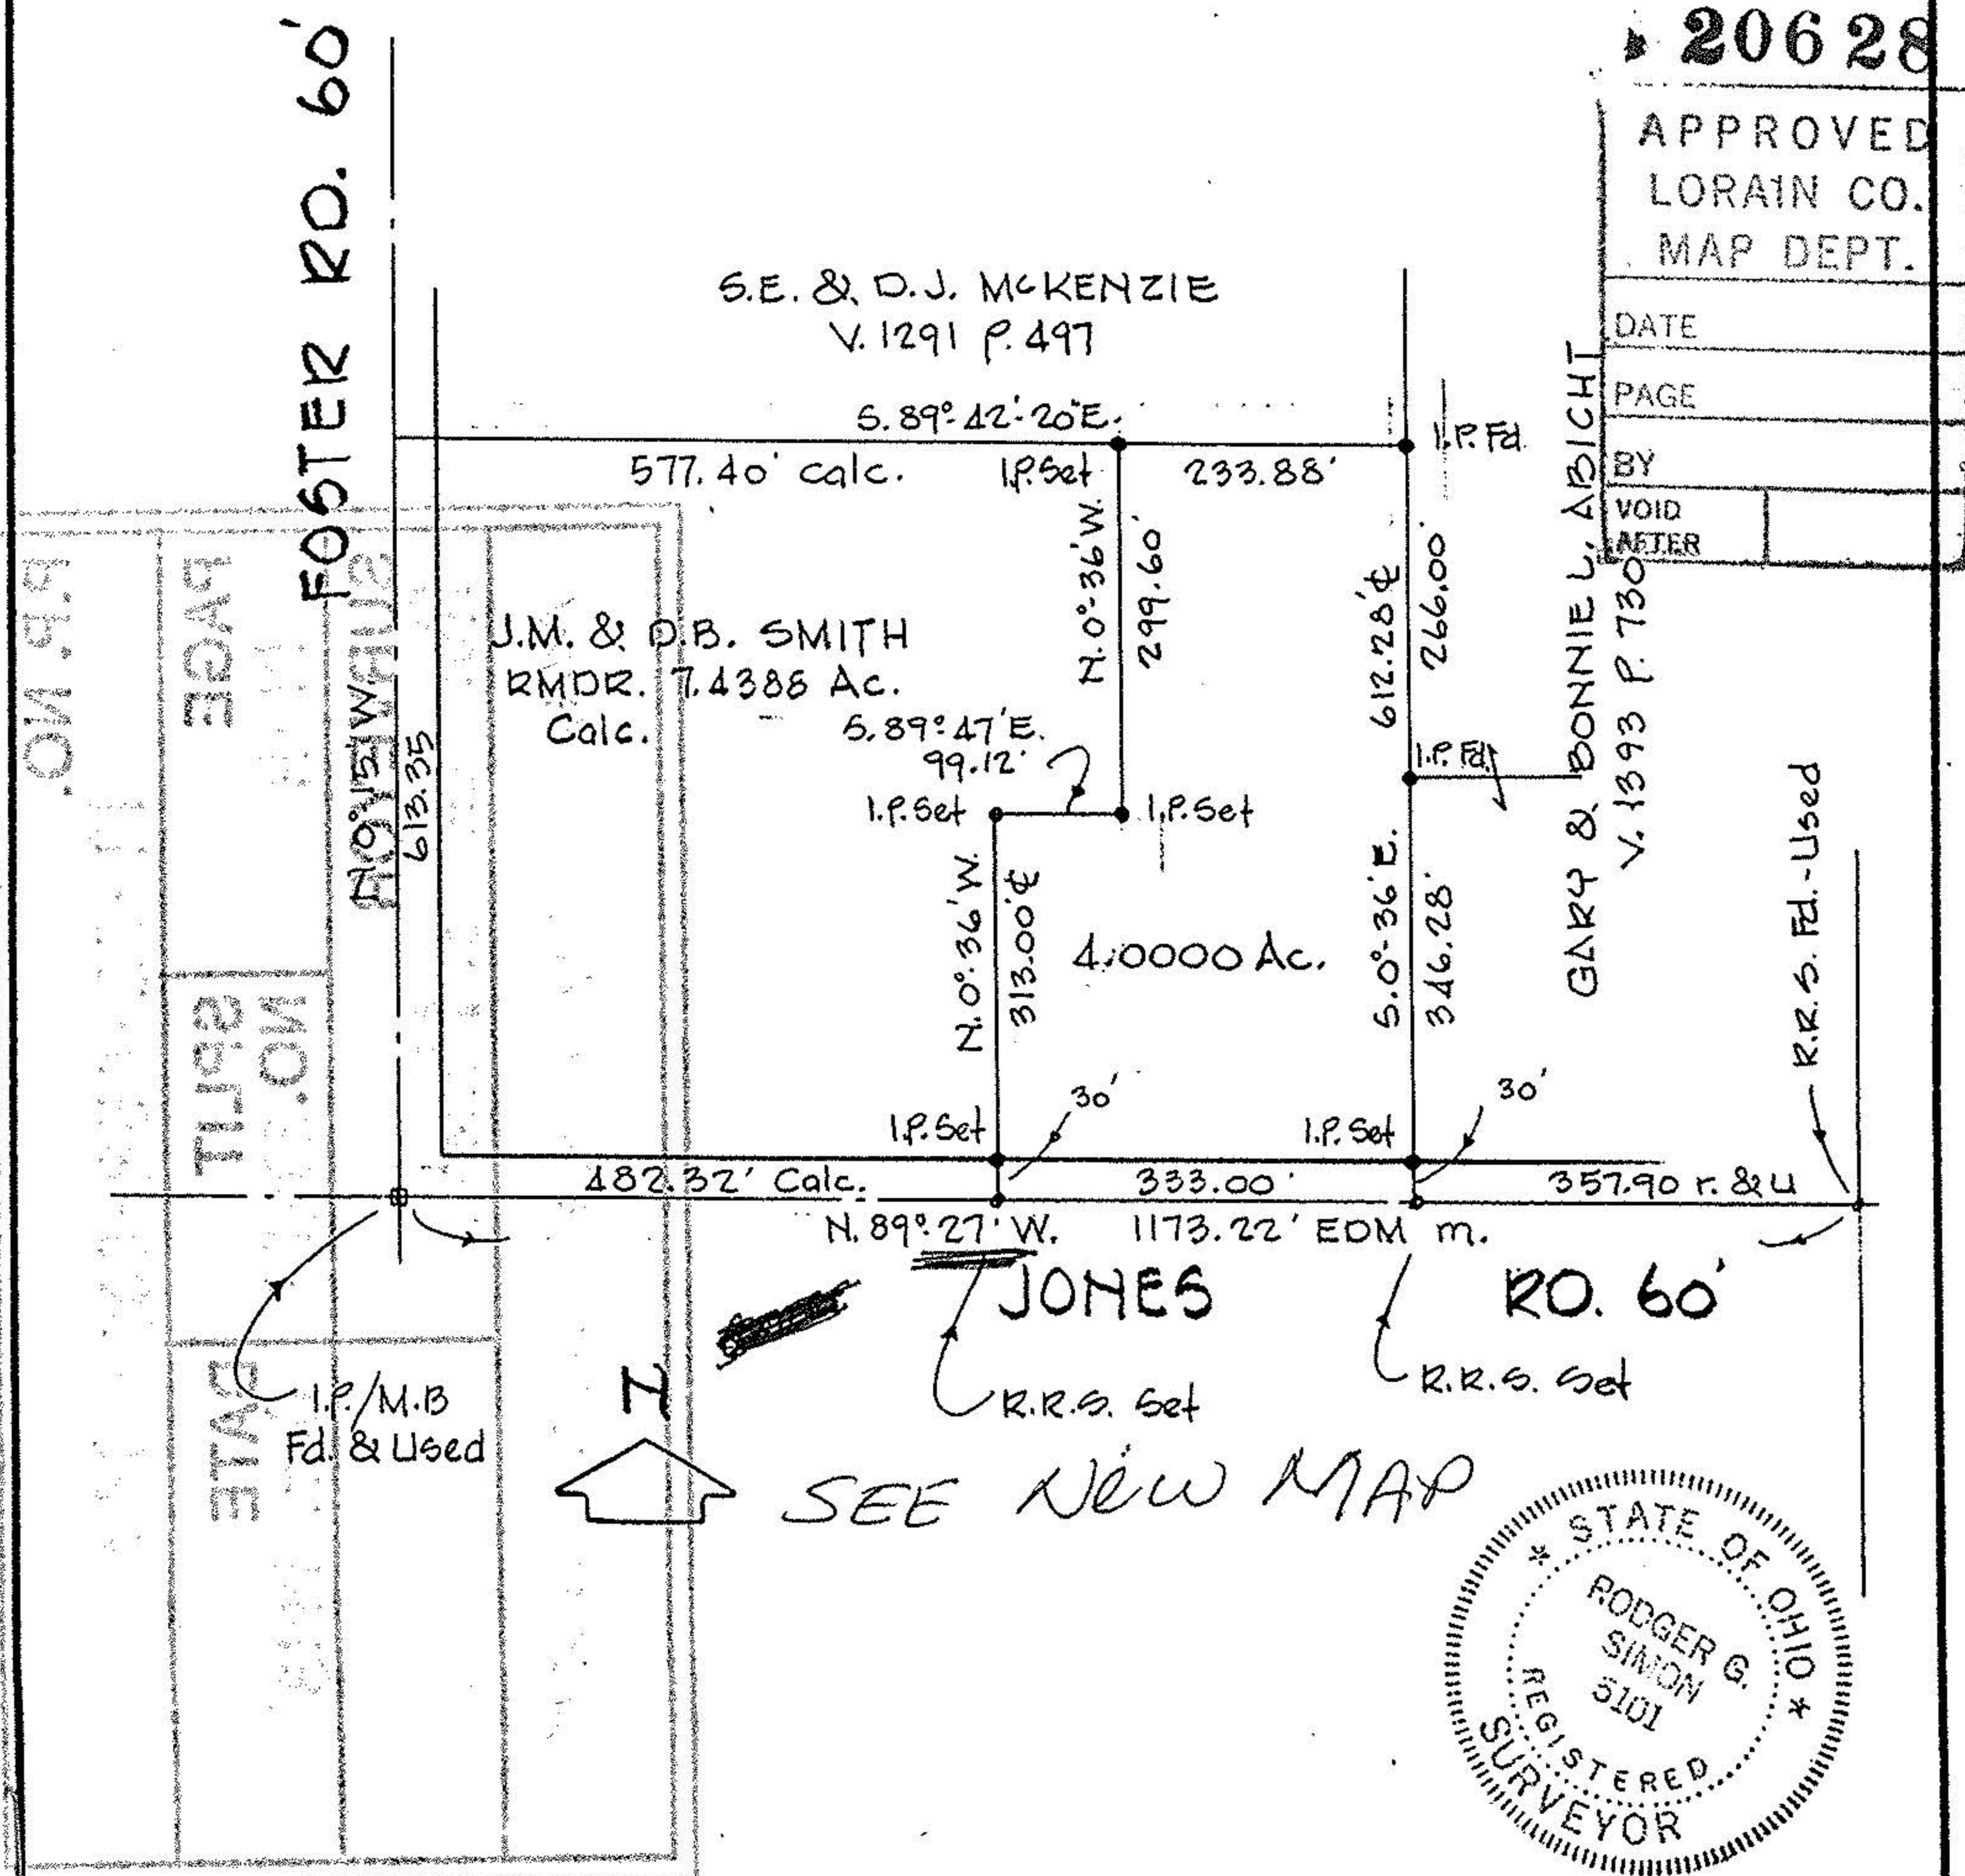

LAUNDON • SIMON • CAHL & ASSOC., INC.
CONSULTING ENGINEERS & SURVEYORS
110 MIDDLE AVE. ELYRIA, O. 44035


SURVEY FOR:
JEFFREY M. & DIANA B. SMITH

Orig. Lot 58	City of	Date OCT. '93 Scale 1"=200'
Orig. Sec	Village of	Dwn. by R.G.S. Chkd. by R.C
Tract 2	County of LORAIN	Job No. 93-2501 F.B.
Township of PENFIELD	State of OHIO	Printed

REF. JOB 83-1215

19-01-058-00-039

New Map

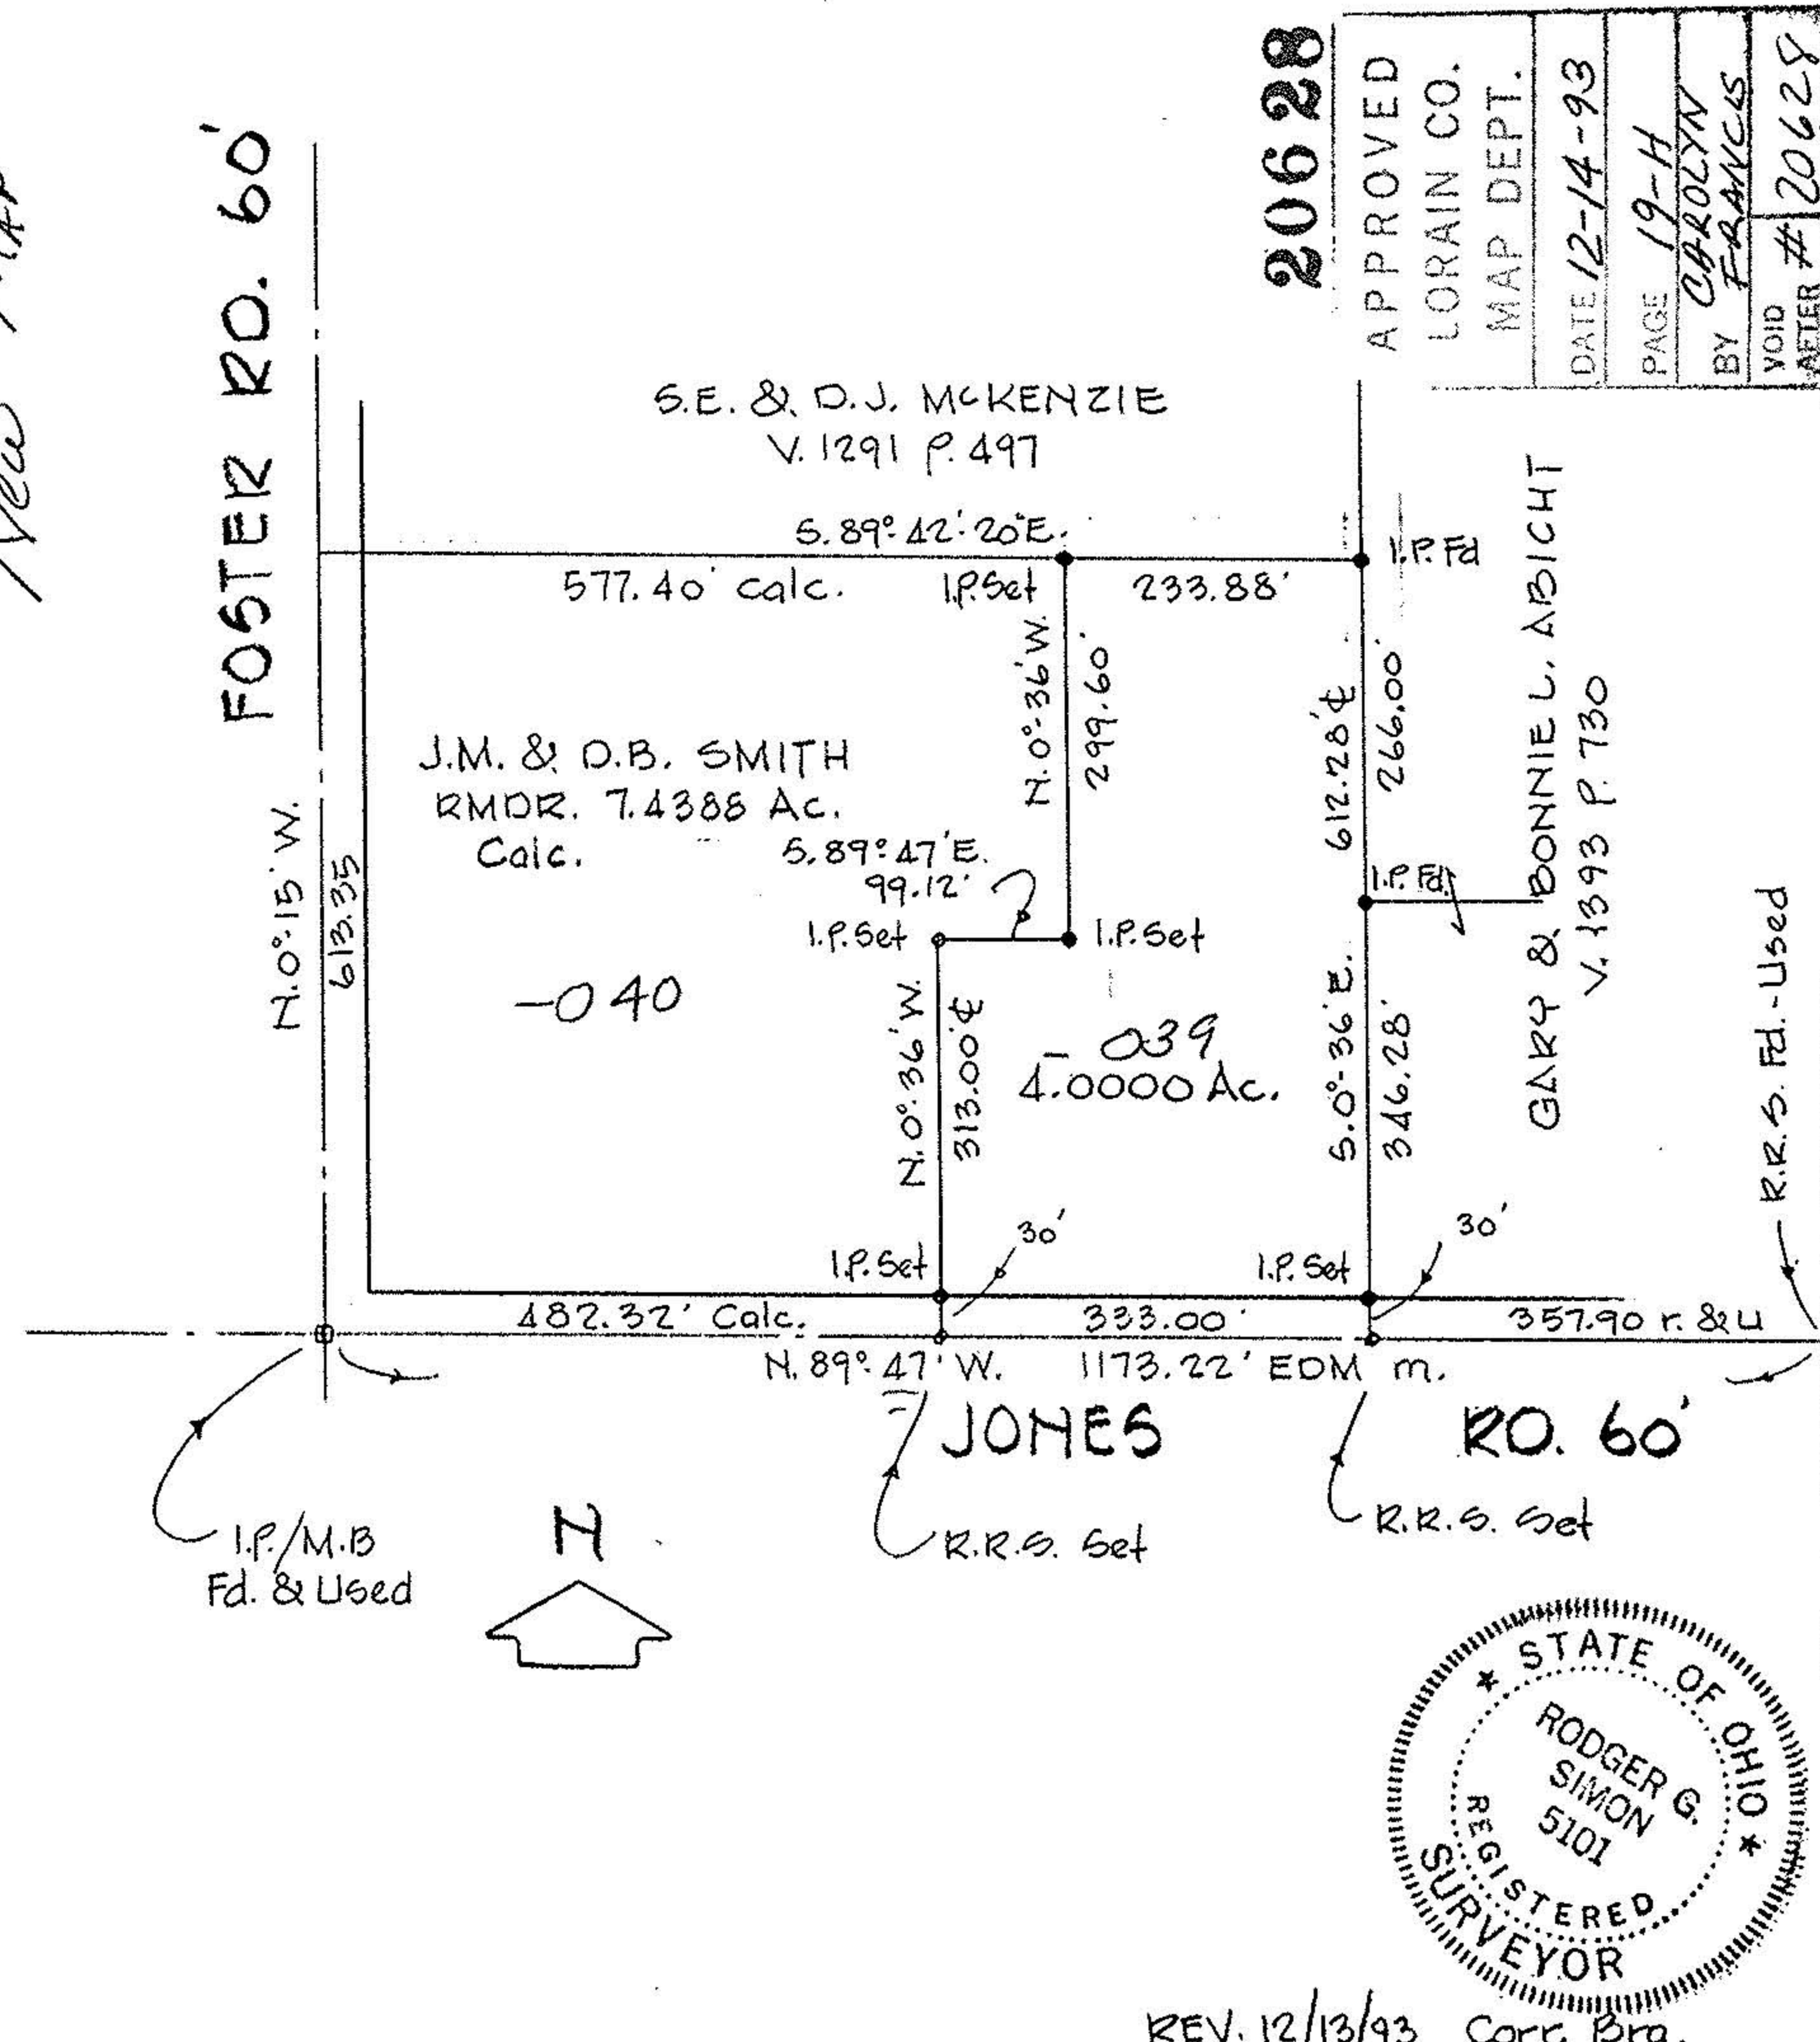

REV. 12/13/93 Corr. Brg.