



SCALE: 1"=100'  
DATE: JAN 1989

# SURVEY

OF PART OF  
ORIGINAL LOT NO. 11  
TRACT NO 4  
PENFIELD TWP.

COUNTY OF LORAIN STATE OF OHIO


EUGENE T. & ALICE J. KLINK  
DV. 988 PG. 457

PREPARED FOR:

FRANK AND IRENE PASADYN  
15712 INDIAN HOLLOW RD.  
GREATON, O

PREPARED BY:

HAPONEK AND ASSOC.  
SURVEYORS  
N. BLOCEVILLE, O

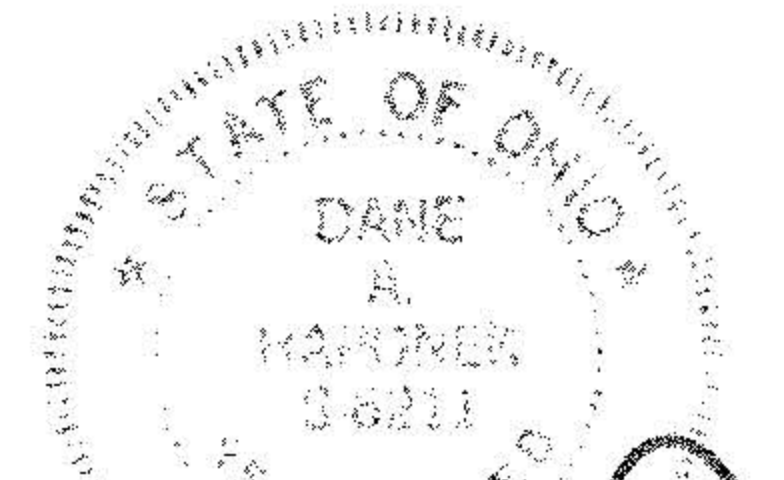

*D. A. Haponek*

BOARD OF TRUSTEES OF  
PENFIELD TWP.  
DV. 1278 PG. 722

BOARD OF TRUSTEES OF  
PENFIELD TWP.  
DV. 1281 PG. 843

EUGENE T.  
AND  
ALICE J. KLINK  
DV. 988 PG. 457

DUE EAST 188.58  
CAL. 1968

JOHN URSANIC  
AND  
MADALINE  
URSANIC  
DV. 284 PG. 55

DUE EAST 231.06  
CAL. 1968

DUE EAST 188.58  
CAL. 1968

DUE EAST 214.10  
OBS

NORWALK - MEDINA RD

N 89° 53' 53" E 1000.49 OBS ±

IPFD. 0.28N 436.38

564.11 ±

IPUSED N 89° 53' 53" E

N 0° 50' 26" E 420.88

351.85 R.F.D.

5.5505 Ac

N 0° 18' 50" E 652.64 ±

308.67

4.0001 Ac.

IPSET

N 89° 53' 53" E 564.11 ±

IPSET

4.4581 Ac.

343.75 ±

309.87

653.50 R.

INDIAN HOLLOW RD 60'

344.76

N 0° 18' 50" E 653.65 OBS

STATE R/V MARKER FD.  
40.0 ± STA. 28+34.40.  
NOTE: STATE R/V MARKERS AS SHOWN  
ON STATE PLAN SH 291 OUR  
OBLITERATED BOTH SIDES OF  
R/V (TO STA. 14+0)

#18464

19-04-011-000

APPROVED
LORAIN CO.
MAP DEPT.
DATE 6-3-89
PAGE 19-C
BY Carol Francis
VOID AFTER 18464