

19-06-116-000-009

19-A


19-06-116-000

-009

#13048

| | | | | |
|-------------------------------------|----------------|--------------|----------------------|------------------------|
| APPROVED LORAIN CO. MAP DEPT. | DATE 9-7-79 | PAGE 19-A | BY C. [Signature] | VOID AFTER 13048 |
|-------------------------------------|----------------|--------------|----------------------|------------------------|

DOE NORTH

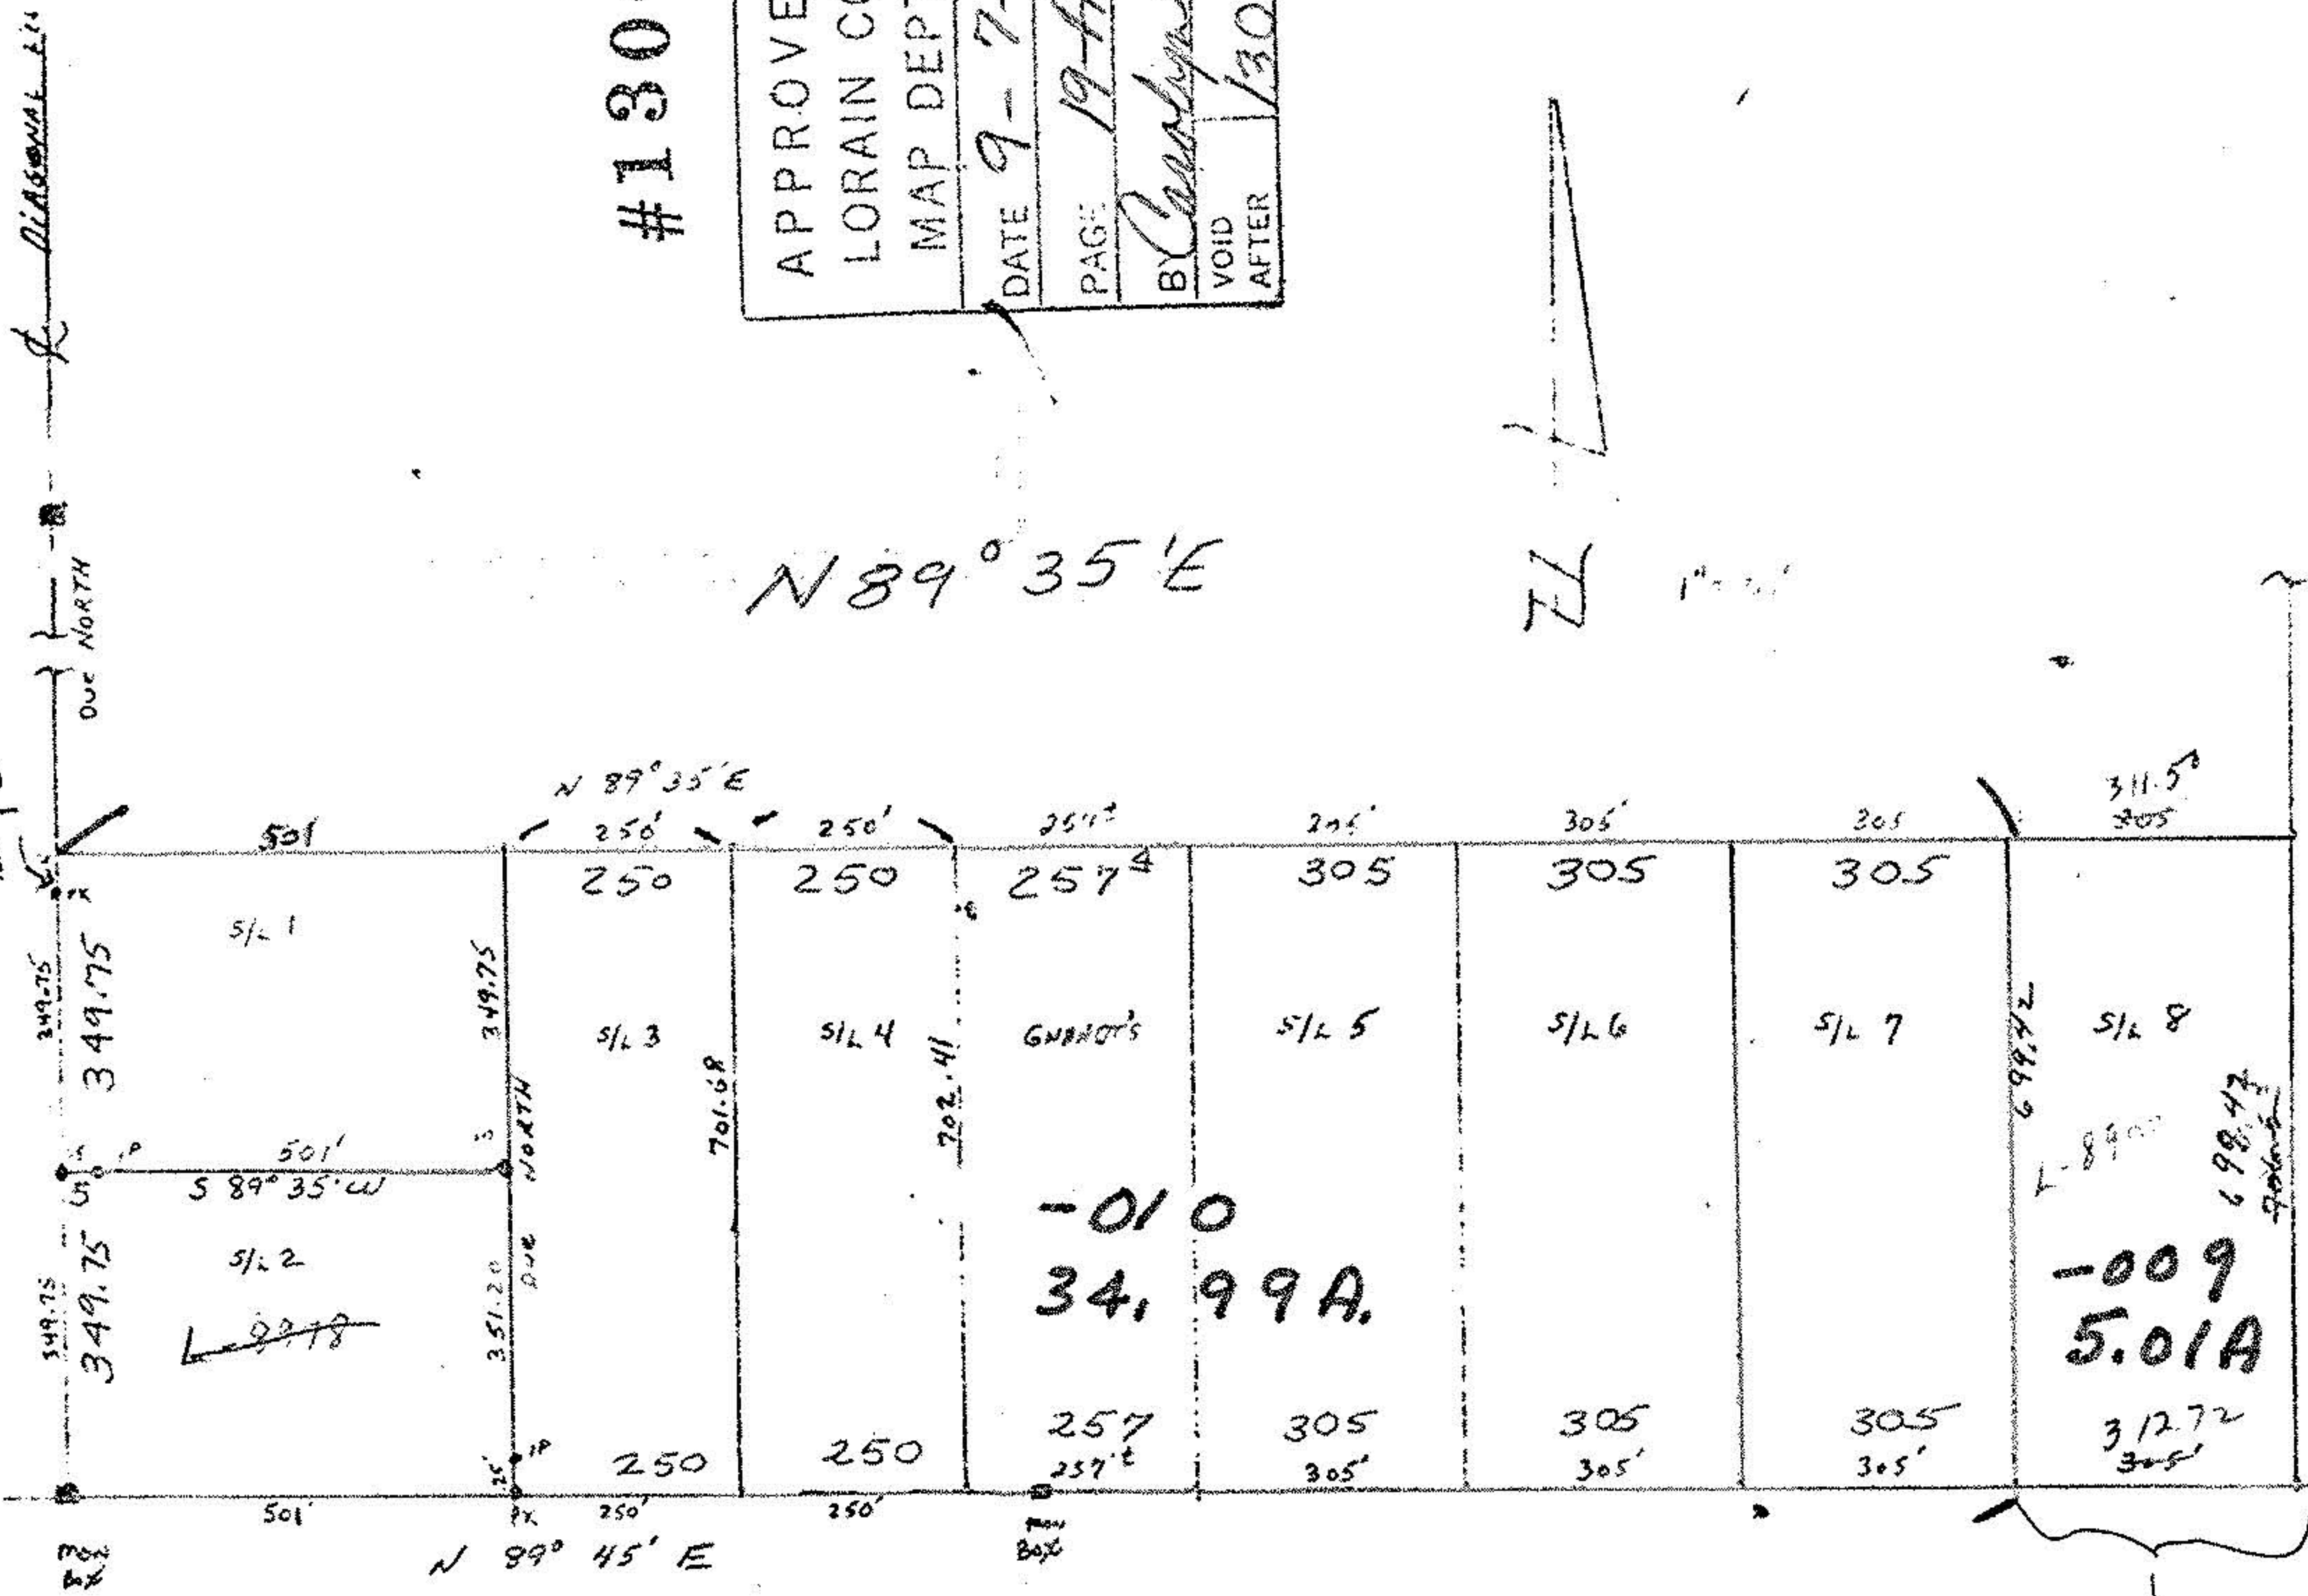

N 89° 35' E

N 89° 45' E



MAP PG. - 19-A

To be split out
new.

S 89° 35' E