

16150
 APPROVED
 LORAIN CO.
 MAP DEPT.

WILLIAM B. BARTON
 REG. LAND SURVEYOR NO. 4438
 188 PARKWOOD AVENUE
 AVON LAKE, OHIO 44012
 TELEPHONE (216) 933-6662


Charles M. Smith D.V. 1161 Pg. 848

DATE 4.29.85
 PAGE 19-D
 BY T. McLean
 VOID BELIEF

Charles M. Smith
 D.V. 1161 Pg. 848

#16150

7-008
 ROLPH E. & MARY
 BOSS
 D.V. 1026 Pg. 602

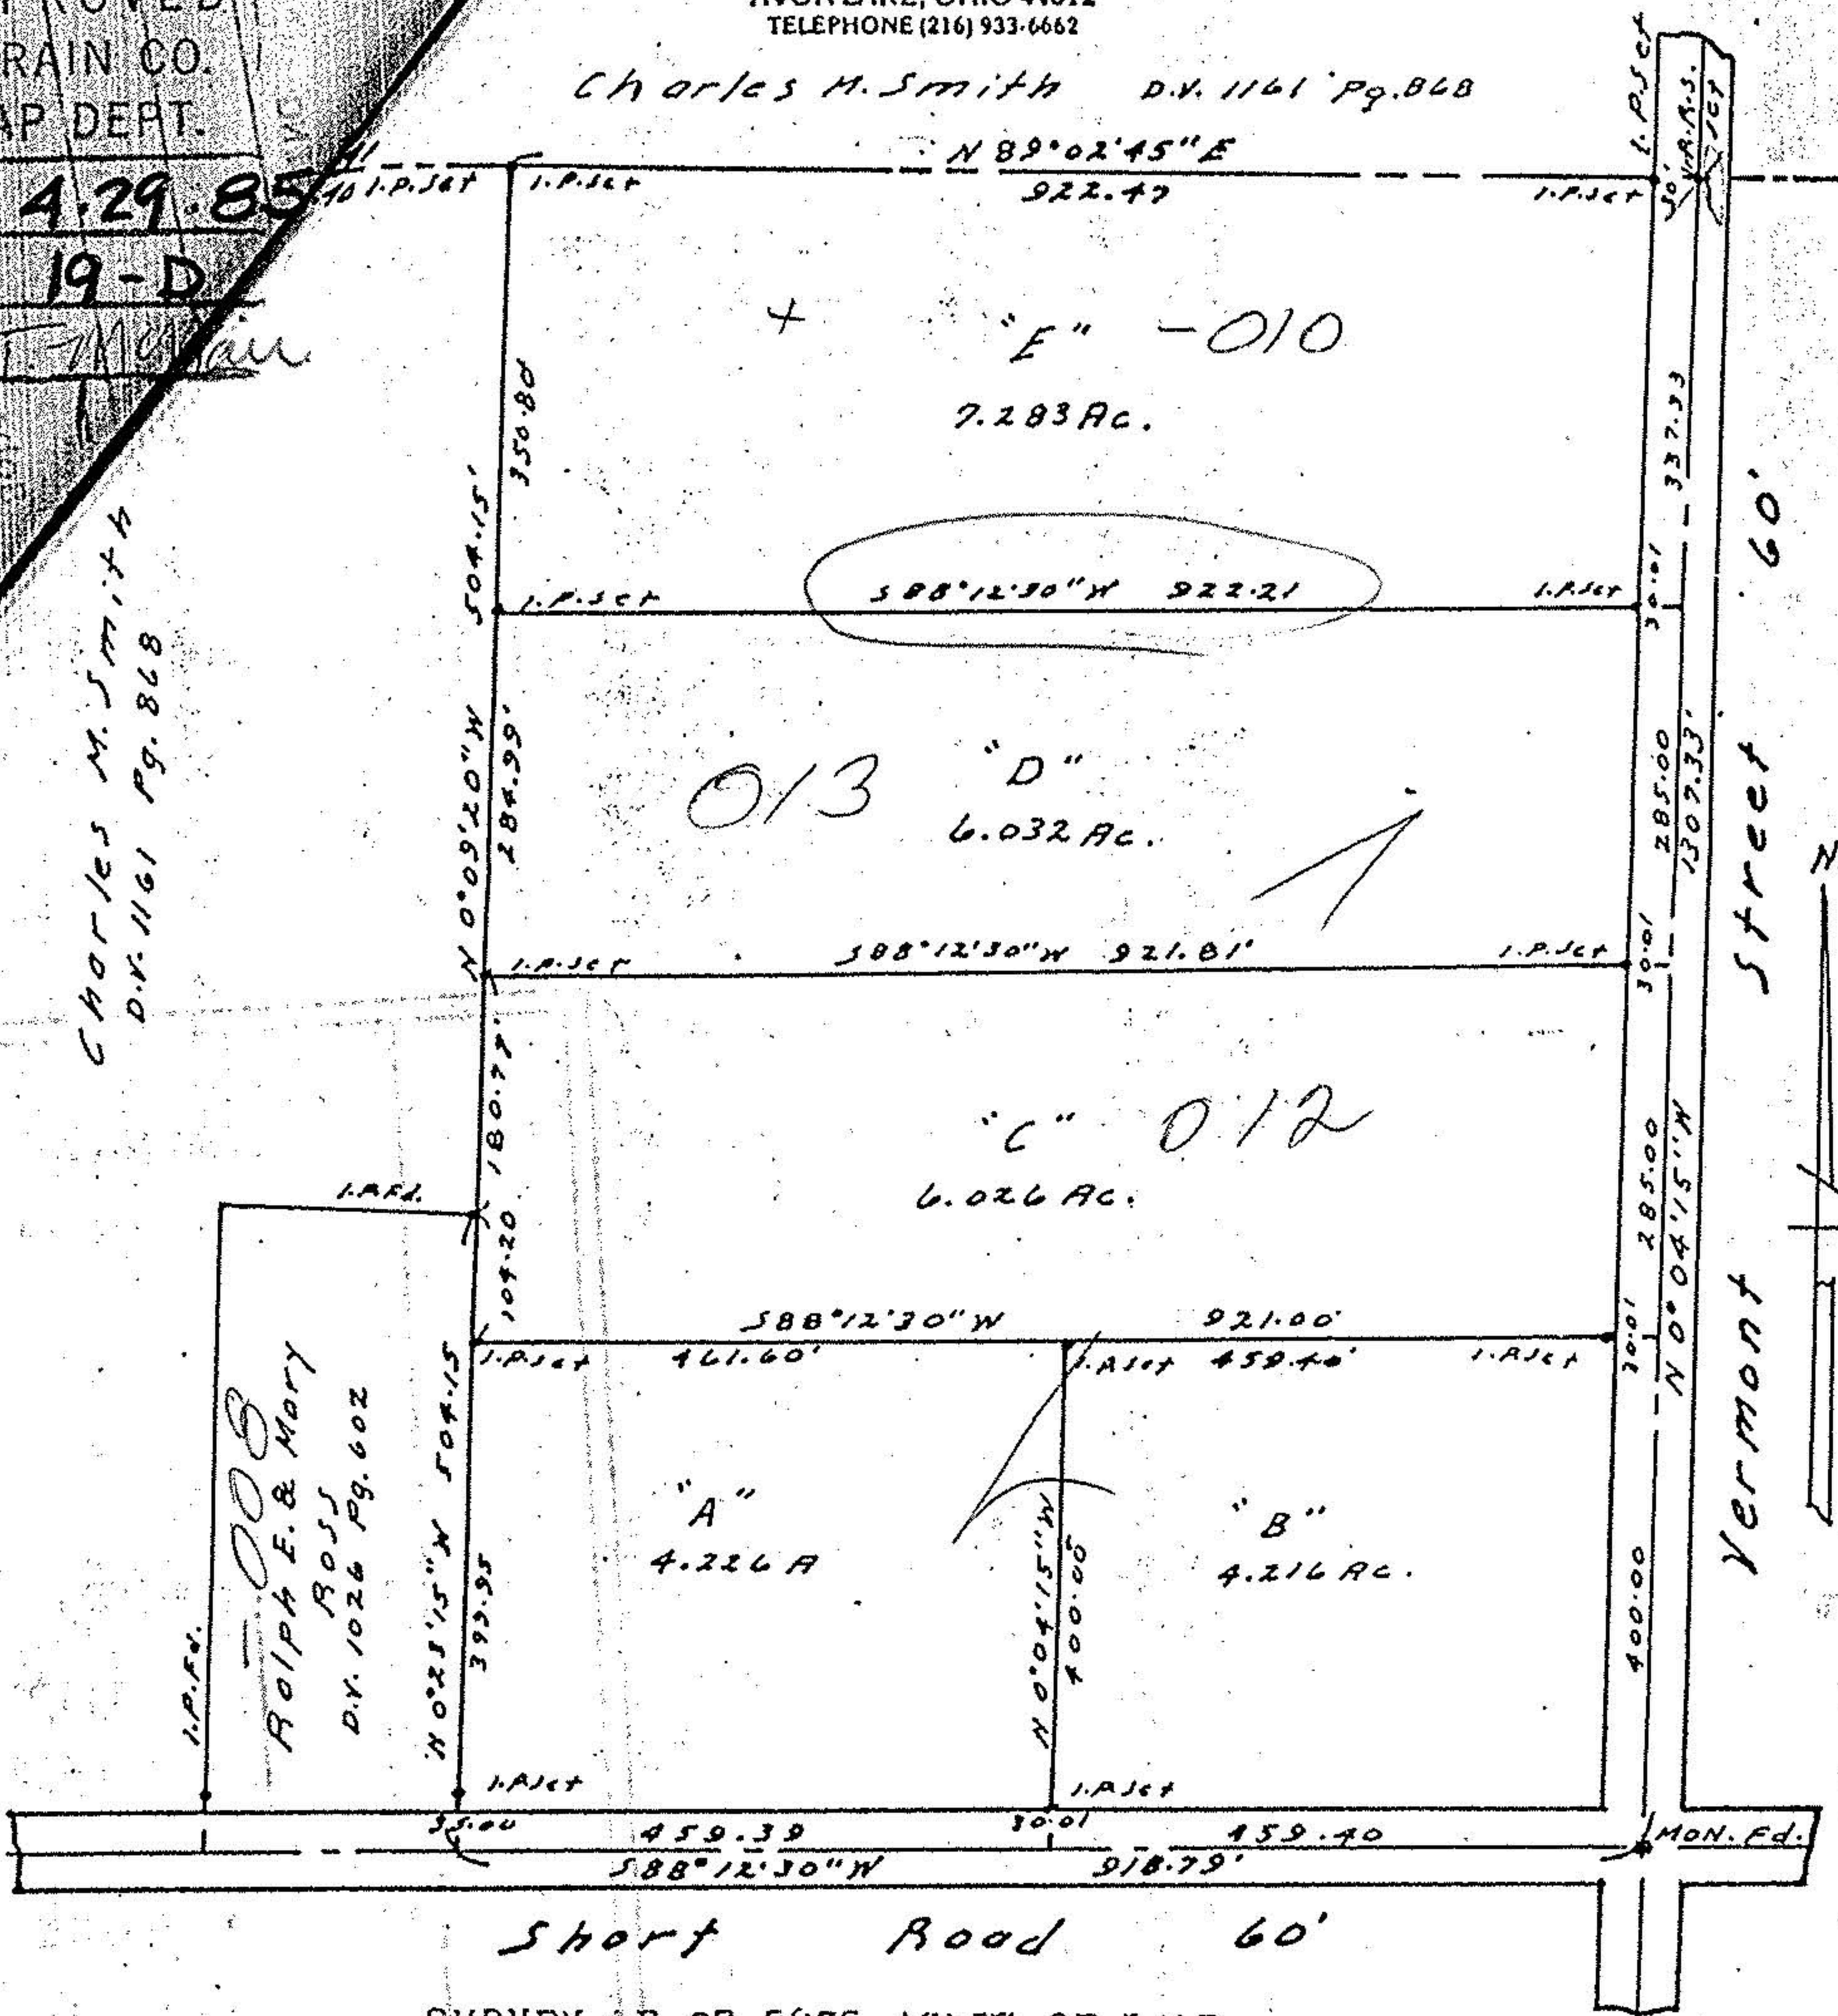

SURVEY OF 27.7835 ACRES OF LAND
 In part of original lot No. 40 section No. 6
 Penfield township Lorain County Ohio. Oct. 11, 1985
 Scale 1" = 200'



19-D

160