



19-06-003-000

See Detail

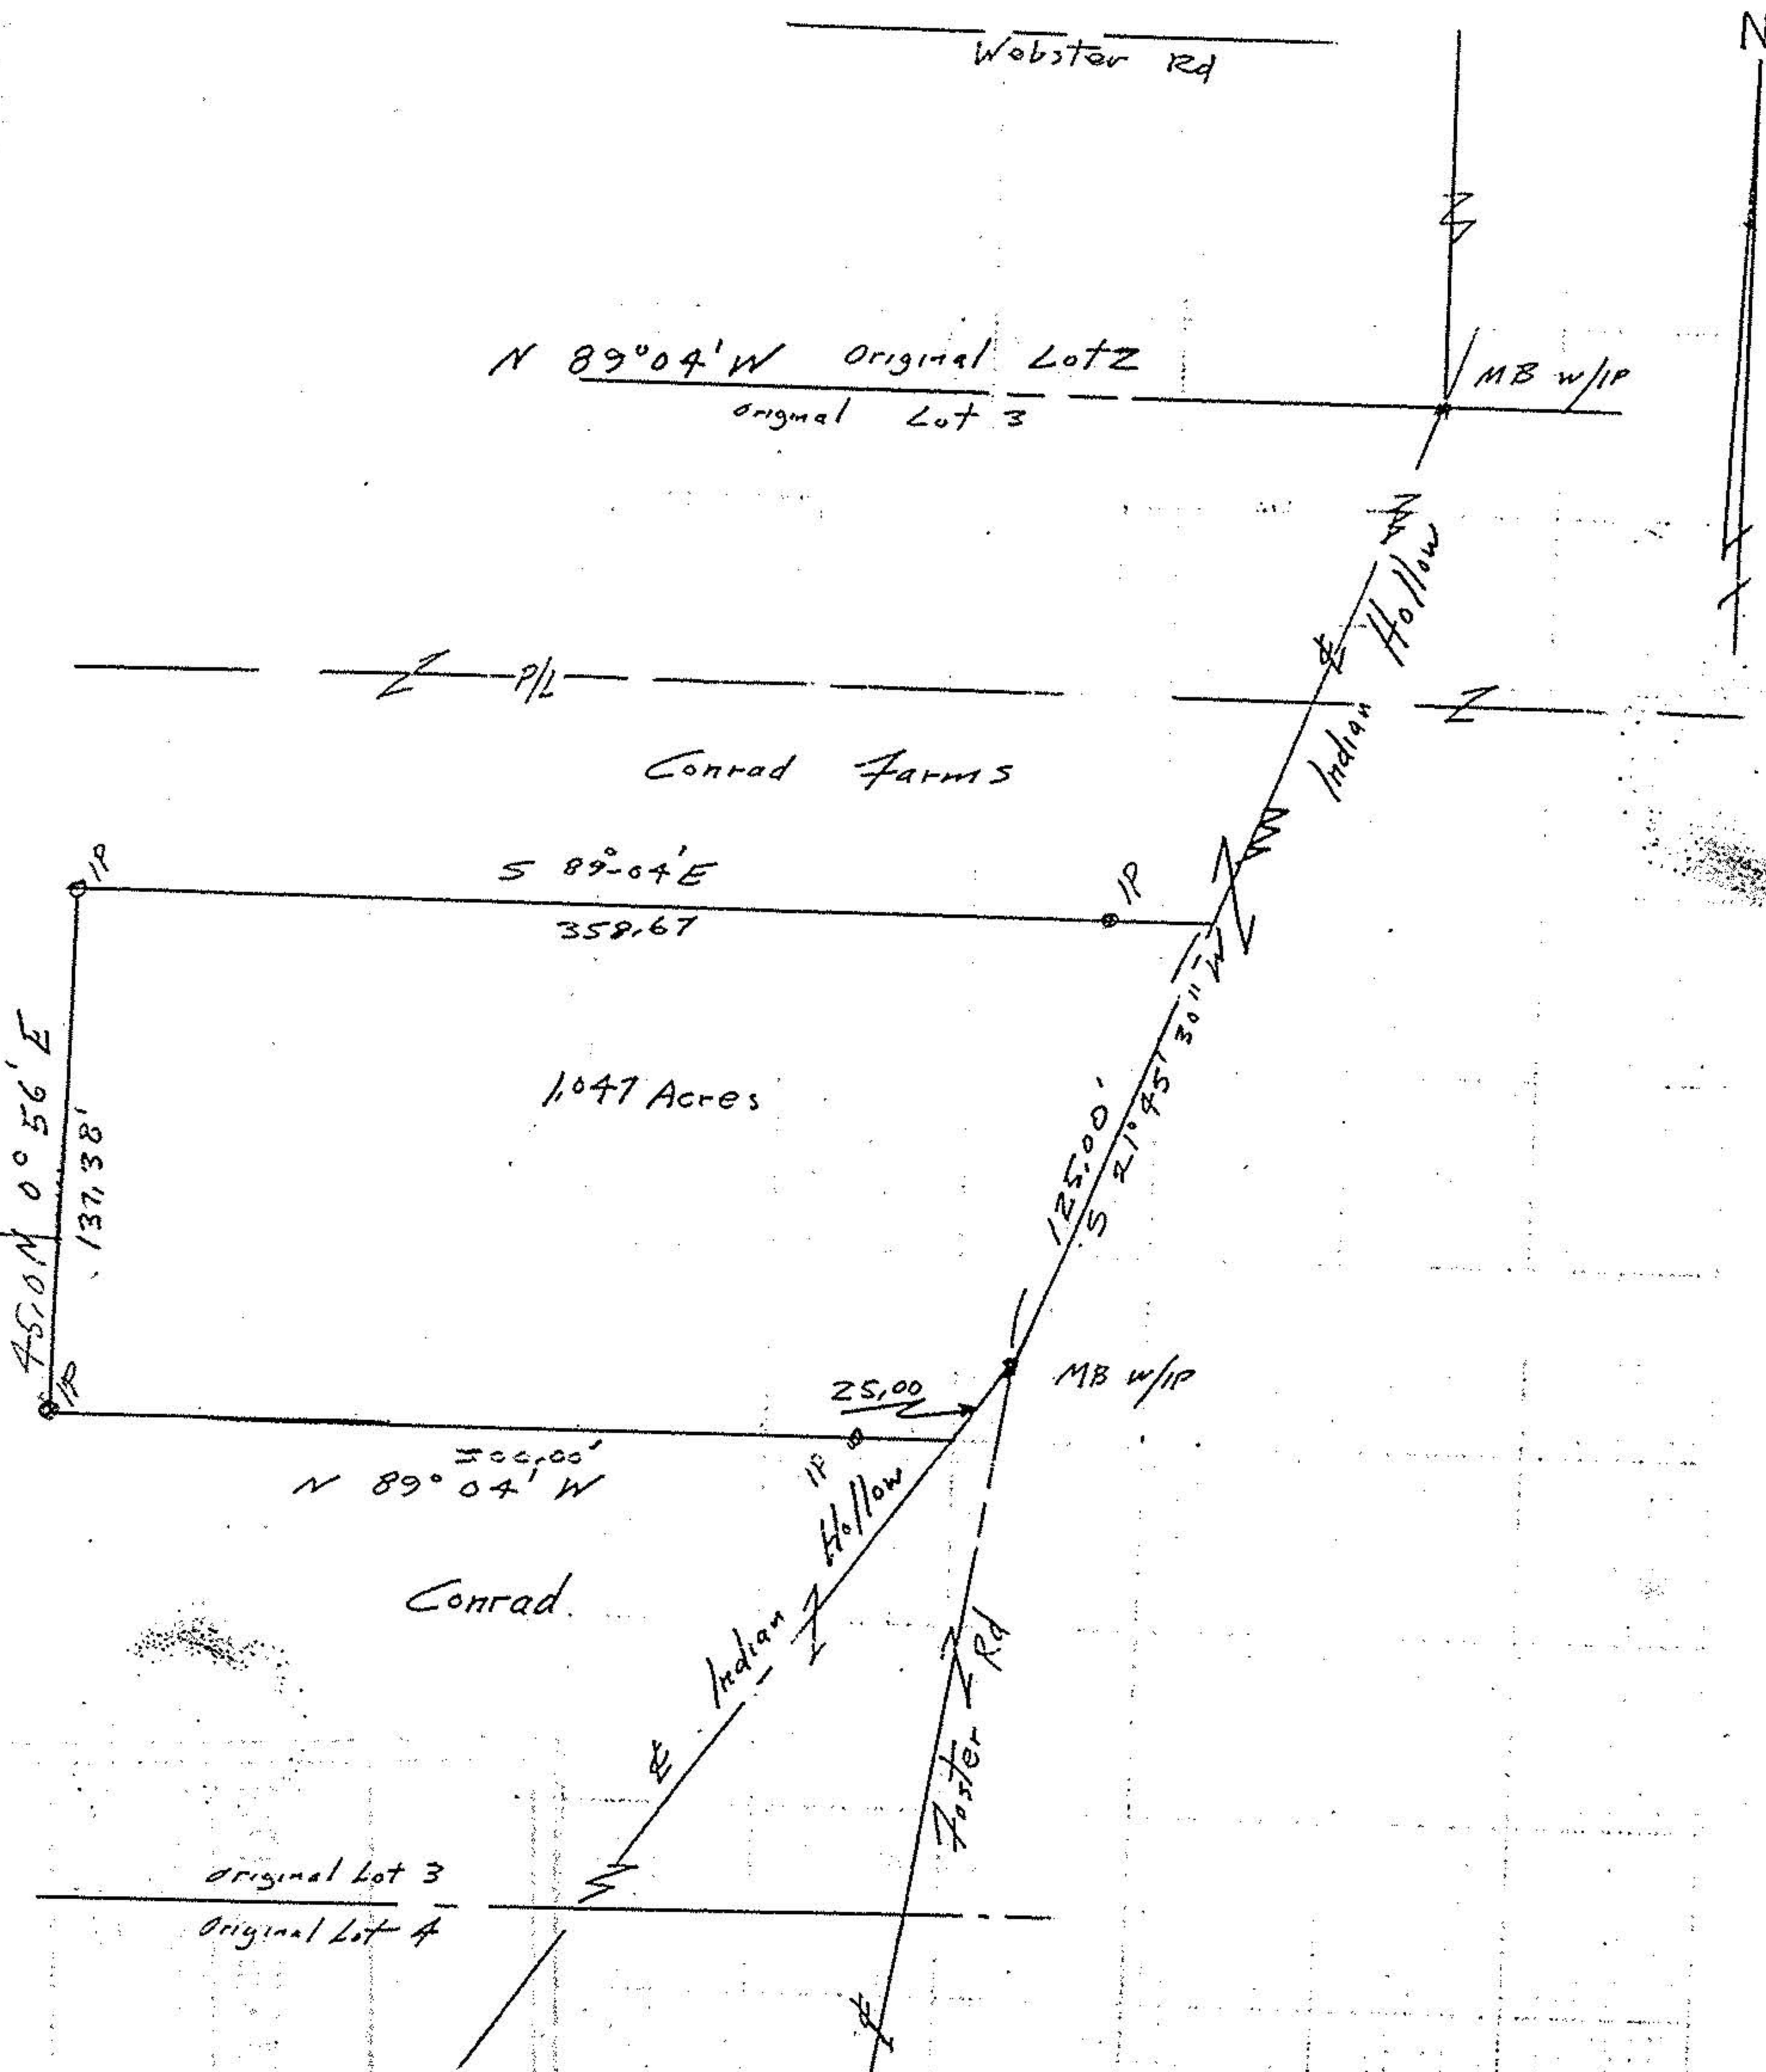


John Pozyswal  
Reg Surveyor  
5282

Parcel Split in  
Original Lot 3 Tract 6  
Penfield Township,  
Lorain County Ohio  
Scale 1"=60' Mar 5, 1987

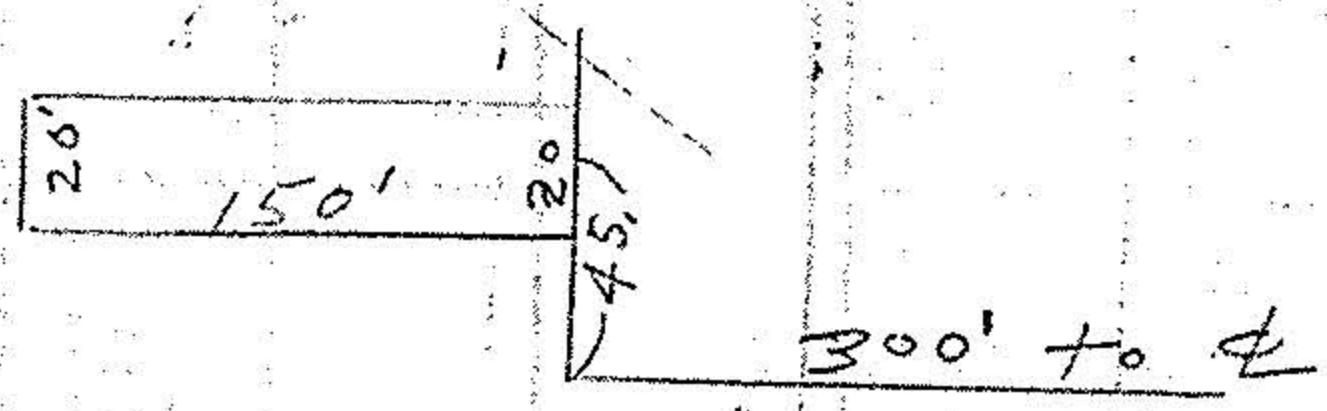

Detail for  
easement  
NTS  
3/28/87

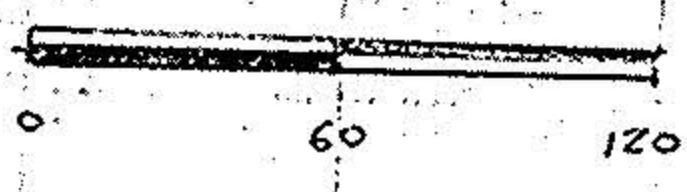

IPS set 3/28/87  
& 30' @ CL to CL

#17581

APPROVED
LORAIN CO.
MAP DEPT.
DATE 8-6-87
PAGE 19-C
BY C. FRANCIS
VOID AFTER 17581