



#18445 19-05-014-000

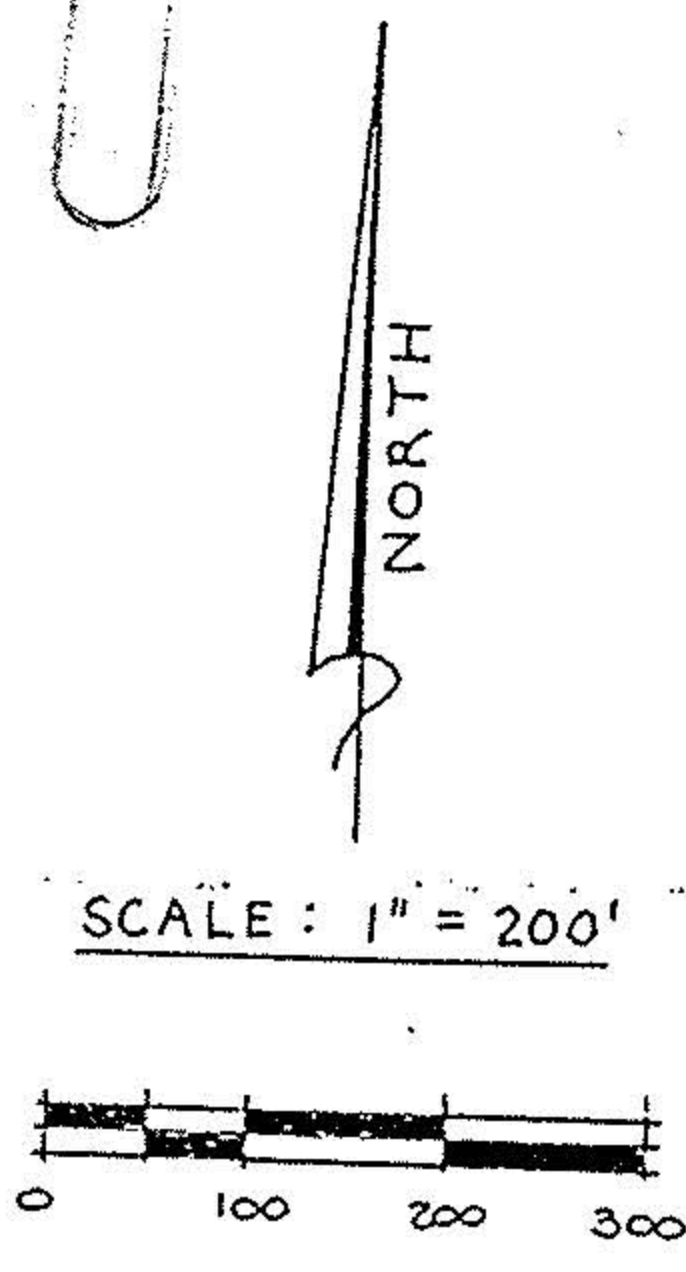

(19-05-014-000-006)
65.10 AC.

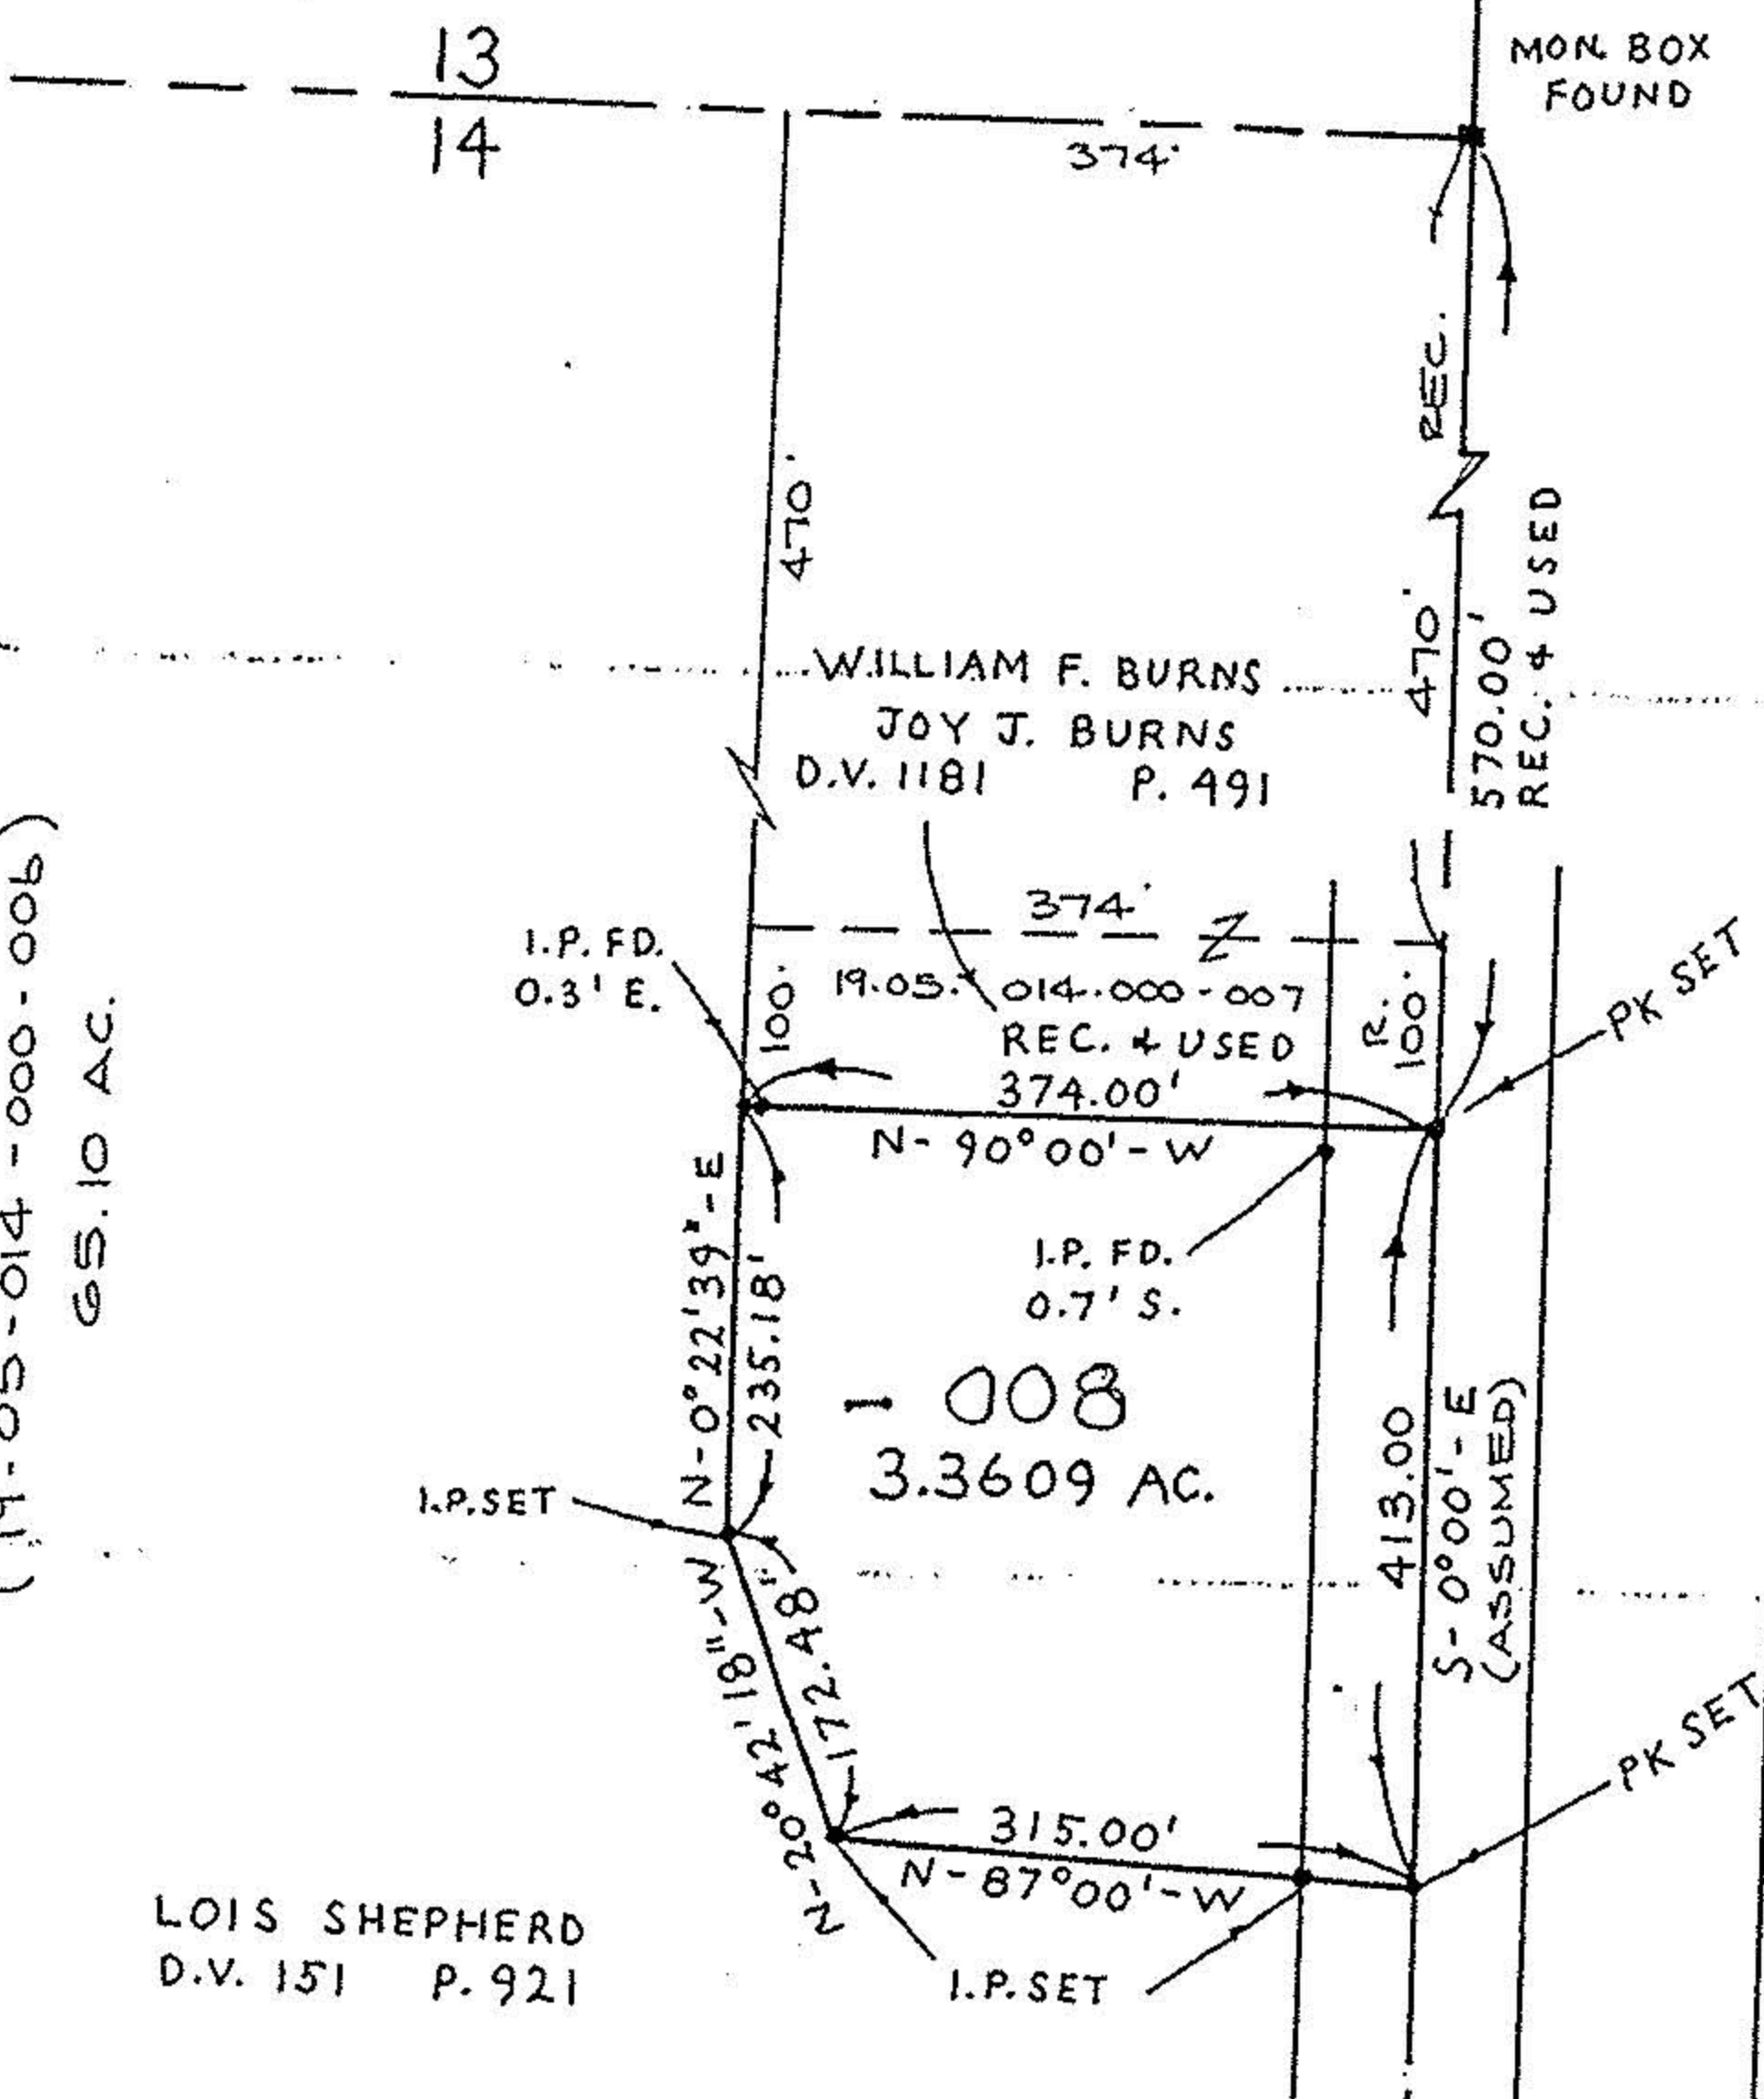

BOUNDARY SURVEY

OF PART OF

PENFIELD TOWNSHIP

ORIGINAL LOT 14 TRACT 5

TOWNSHIP OF PENFIELD COUNTY OF LORAIN

STATE OF OHIO

14 TRACT 5
3 TRACT 4

MON BOX FOUND

WHITEHEAD ROAD

#18445

STATE OF OHIO DAVID L. ELWELL 6333 REGISTERED SURVEYOR	APPROVED
	LORAIN CO. MAINT. DEPT.
	DATE 5-22-89
	PAGE 19-A
BY CAROL FRANCIS	VOID AFTER # 18445

David L. Elwell
 DAVID L. ELWELL REG. SURVEYOR
 NO. 6333