

14 B


19 LOT-12 T-5

19-05-012-000
-007
008

Map of Part of Lot 12 Tract 5 Replotted Twp. Lorain Co., Ohio
Scale 1" = 400'

By Arnold F. Koepf Registered Surveyor No. 4306

12400

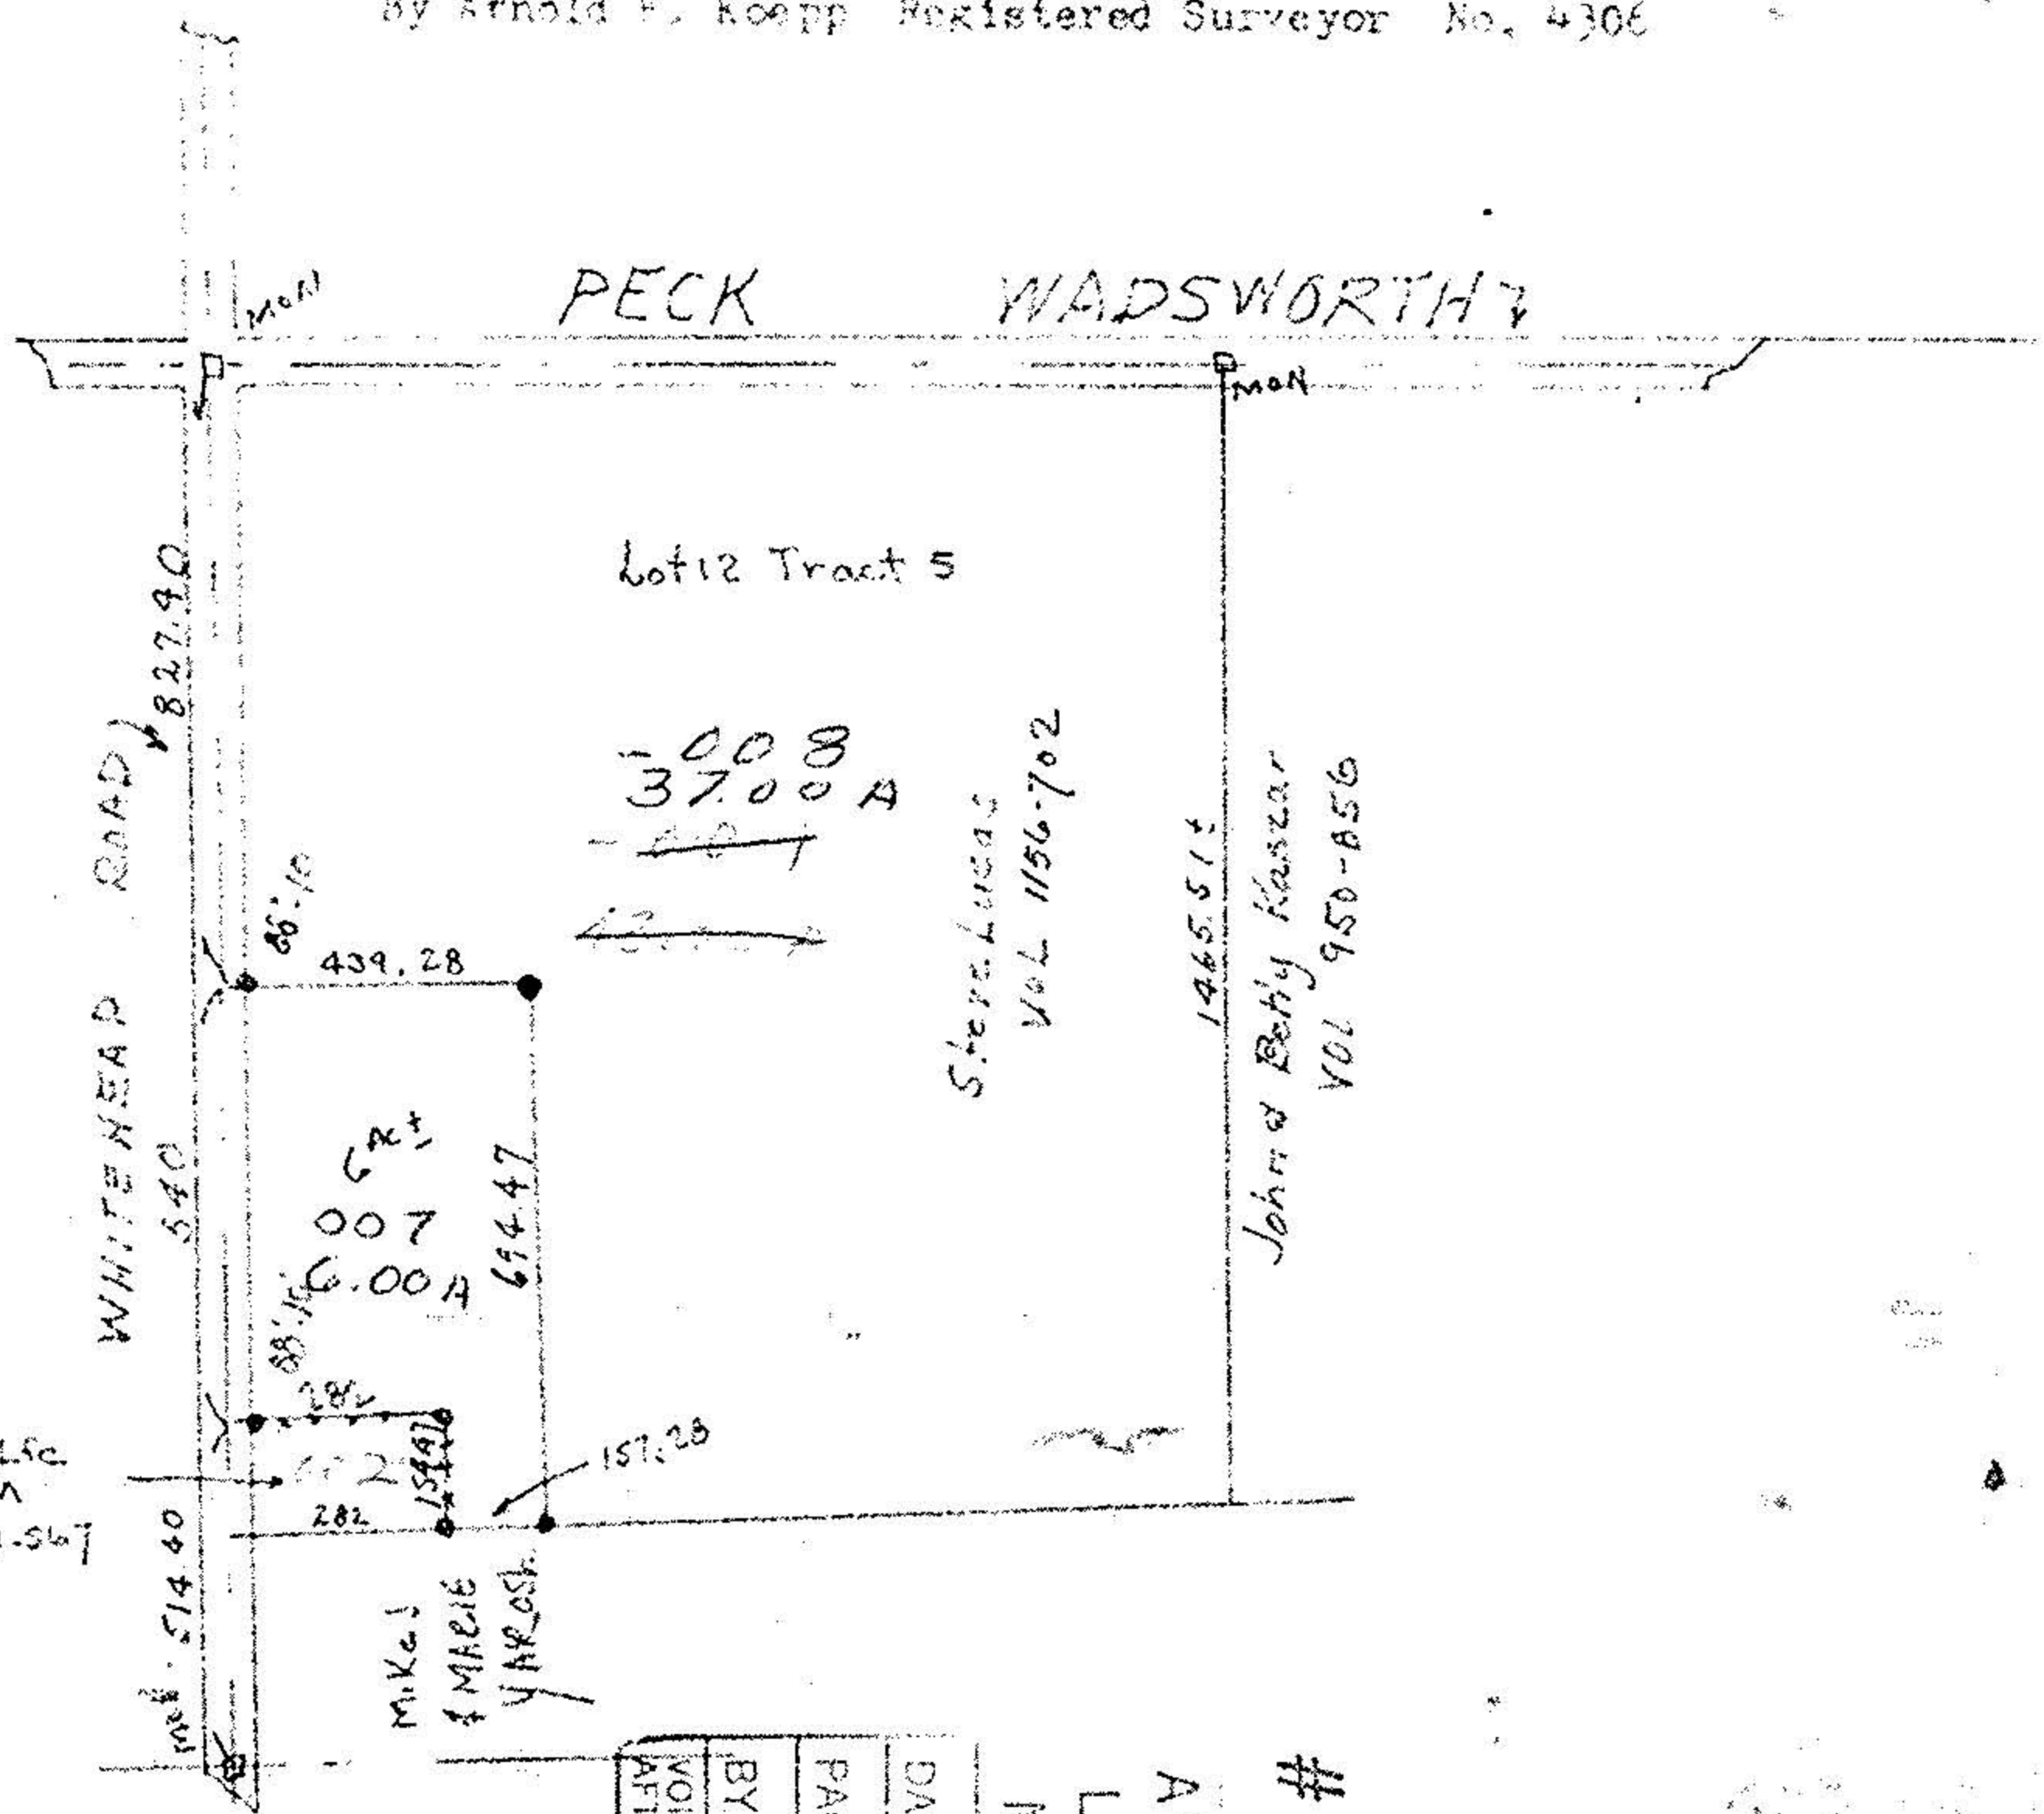

12400

APPROVED
LORAIN CO.
MAP DEPT.

DATE 1-23-79

PAGE 19-B

BY Carolyn [Signature]

VOID AFTER 12400

12400