


20542

-002 Paul Bauer D.Vol 881 P. 440

Peck &  
Wadsworth  
Rd


- o iron pipes fd
- iron pipes set
- monument box

APPROVED LORAIN CO. MAP DEPT.
DATE 10-5-93
PAGE 19-C
BY CAROLYN FRANCOIS
VOID AFTER # 20542

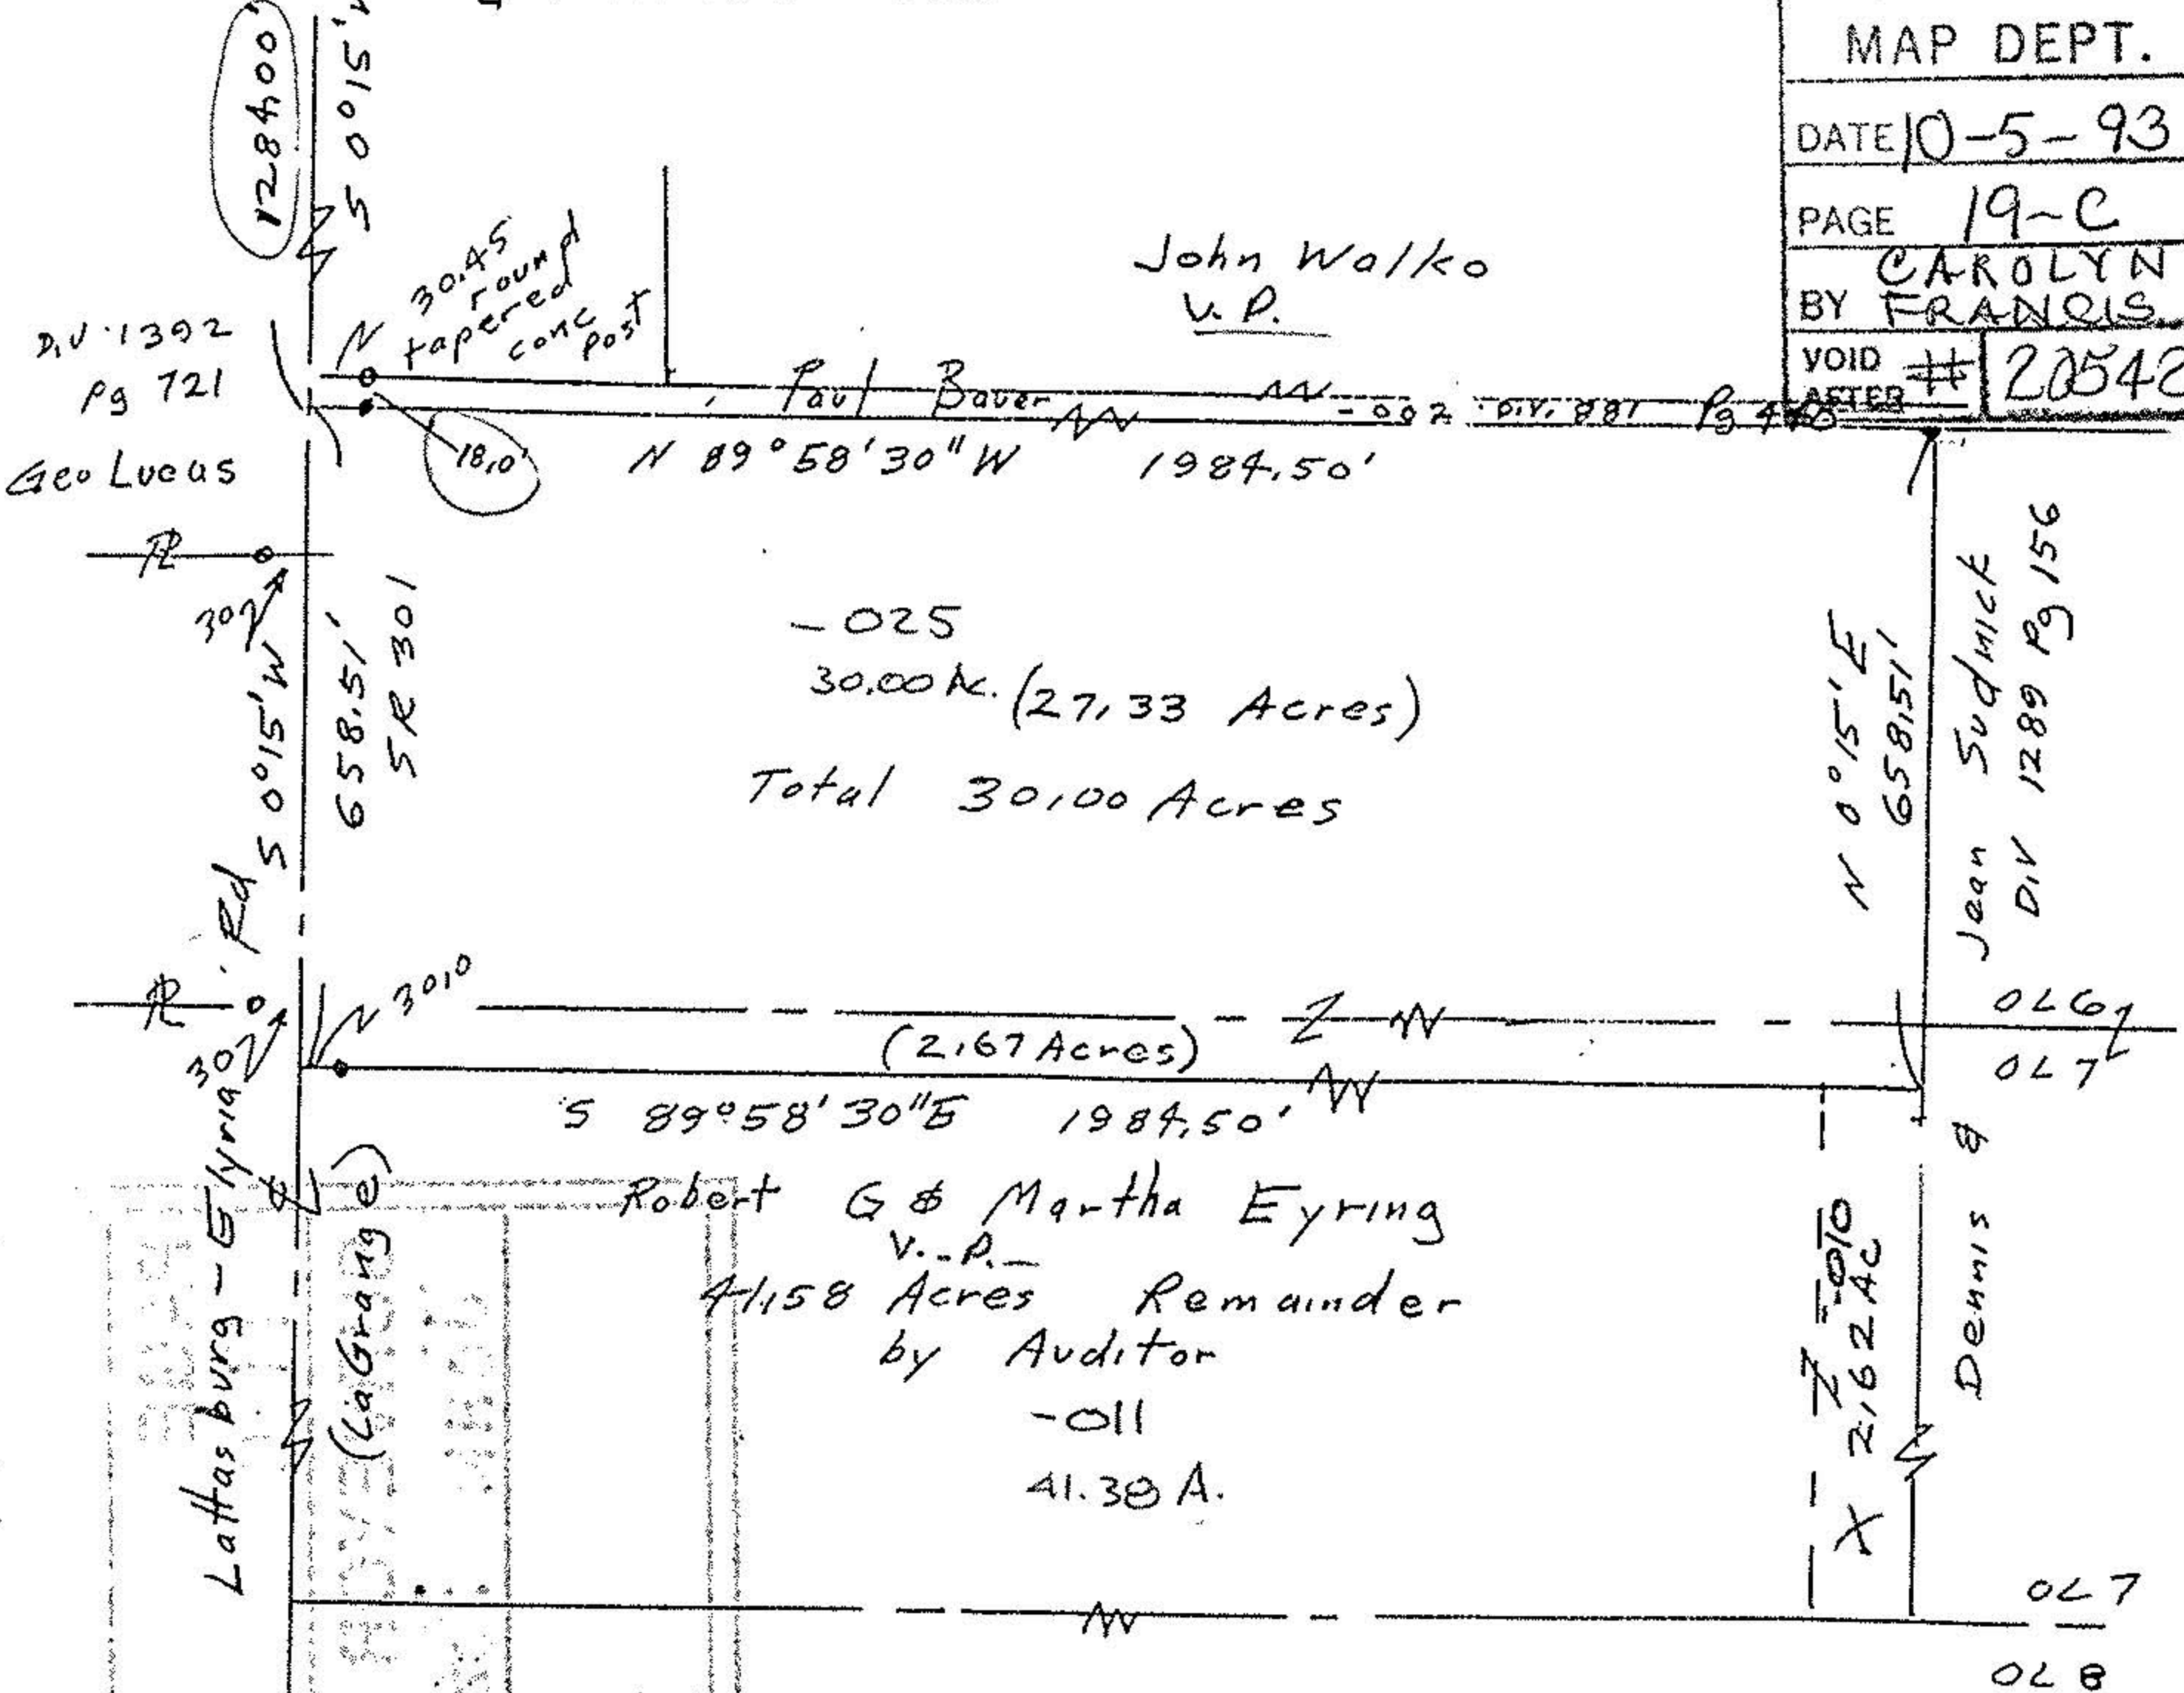

John Poznywak

Reg Surveyor 5292

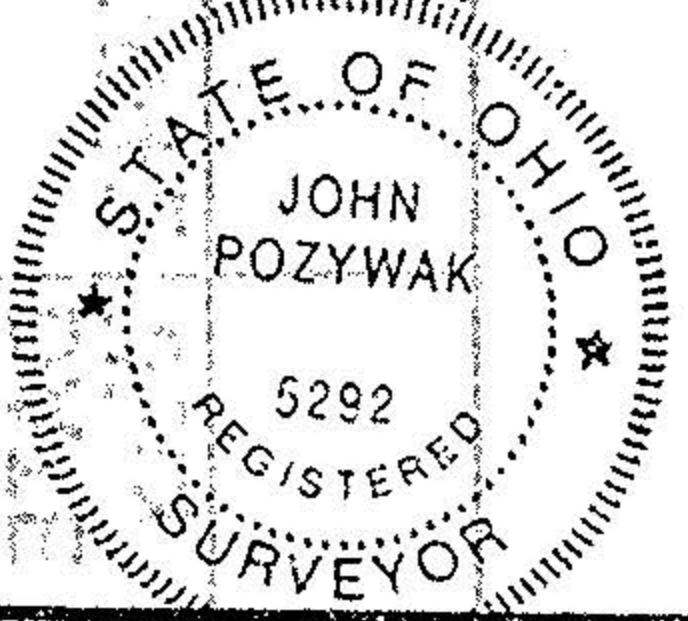

Survey of parcel split for John Eyring

Section 5

ORIGINAL LOT 026 & 7 DATE July 1993

TOWNSHIP Penfield SCALE 1" = 300'

CITY OF \_\_\_\_\_ FIELD BOOK NA

COUNTY OF LORAIN DRAWN BY J. Poe

STATE OF OHIO CHECKED BY \_\_\_\_\_

W. O. \_\_\_\_\_ FILE NO. 19-05-006