


#19133


-003

RRS
FP.


GORE
ORPHANAGE RD.

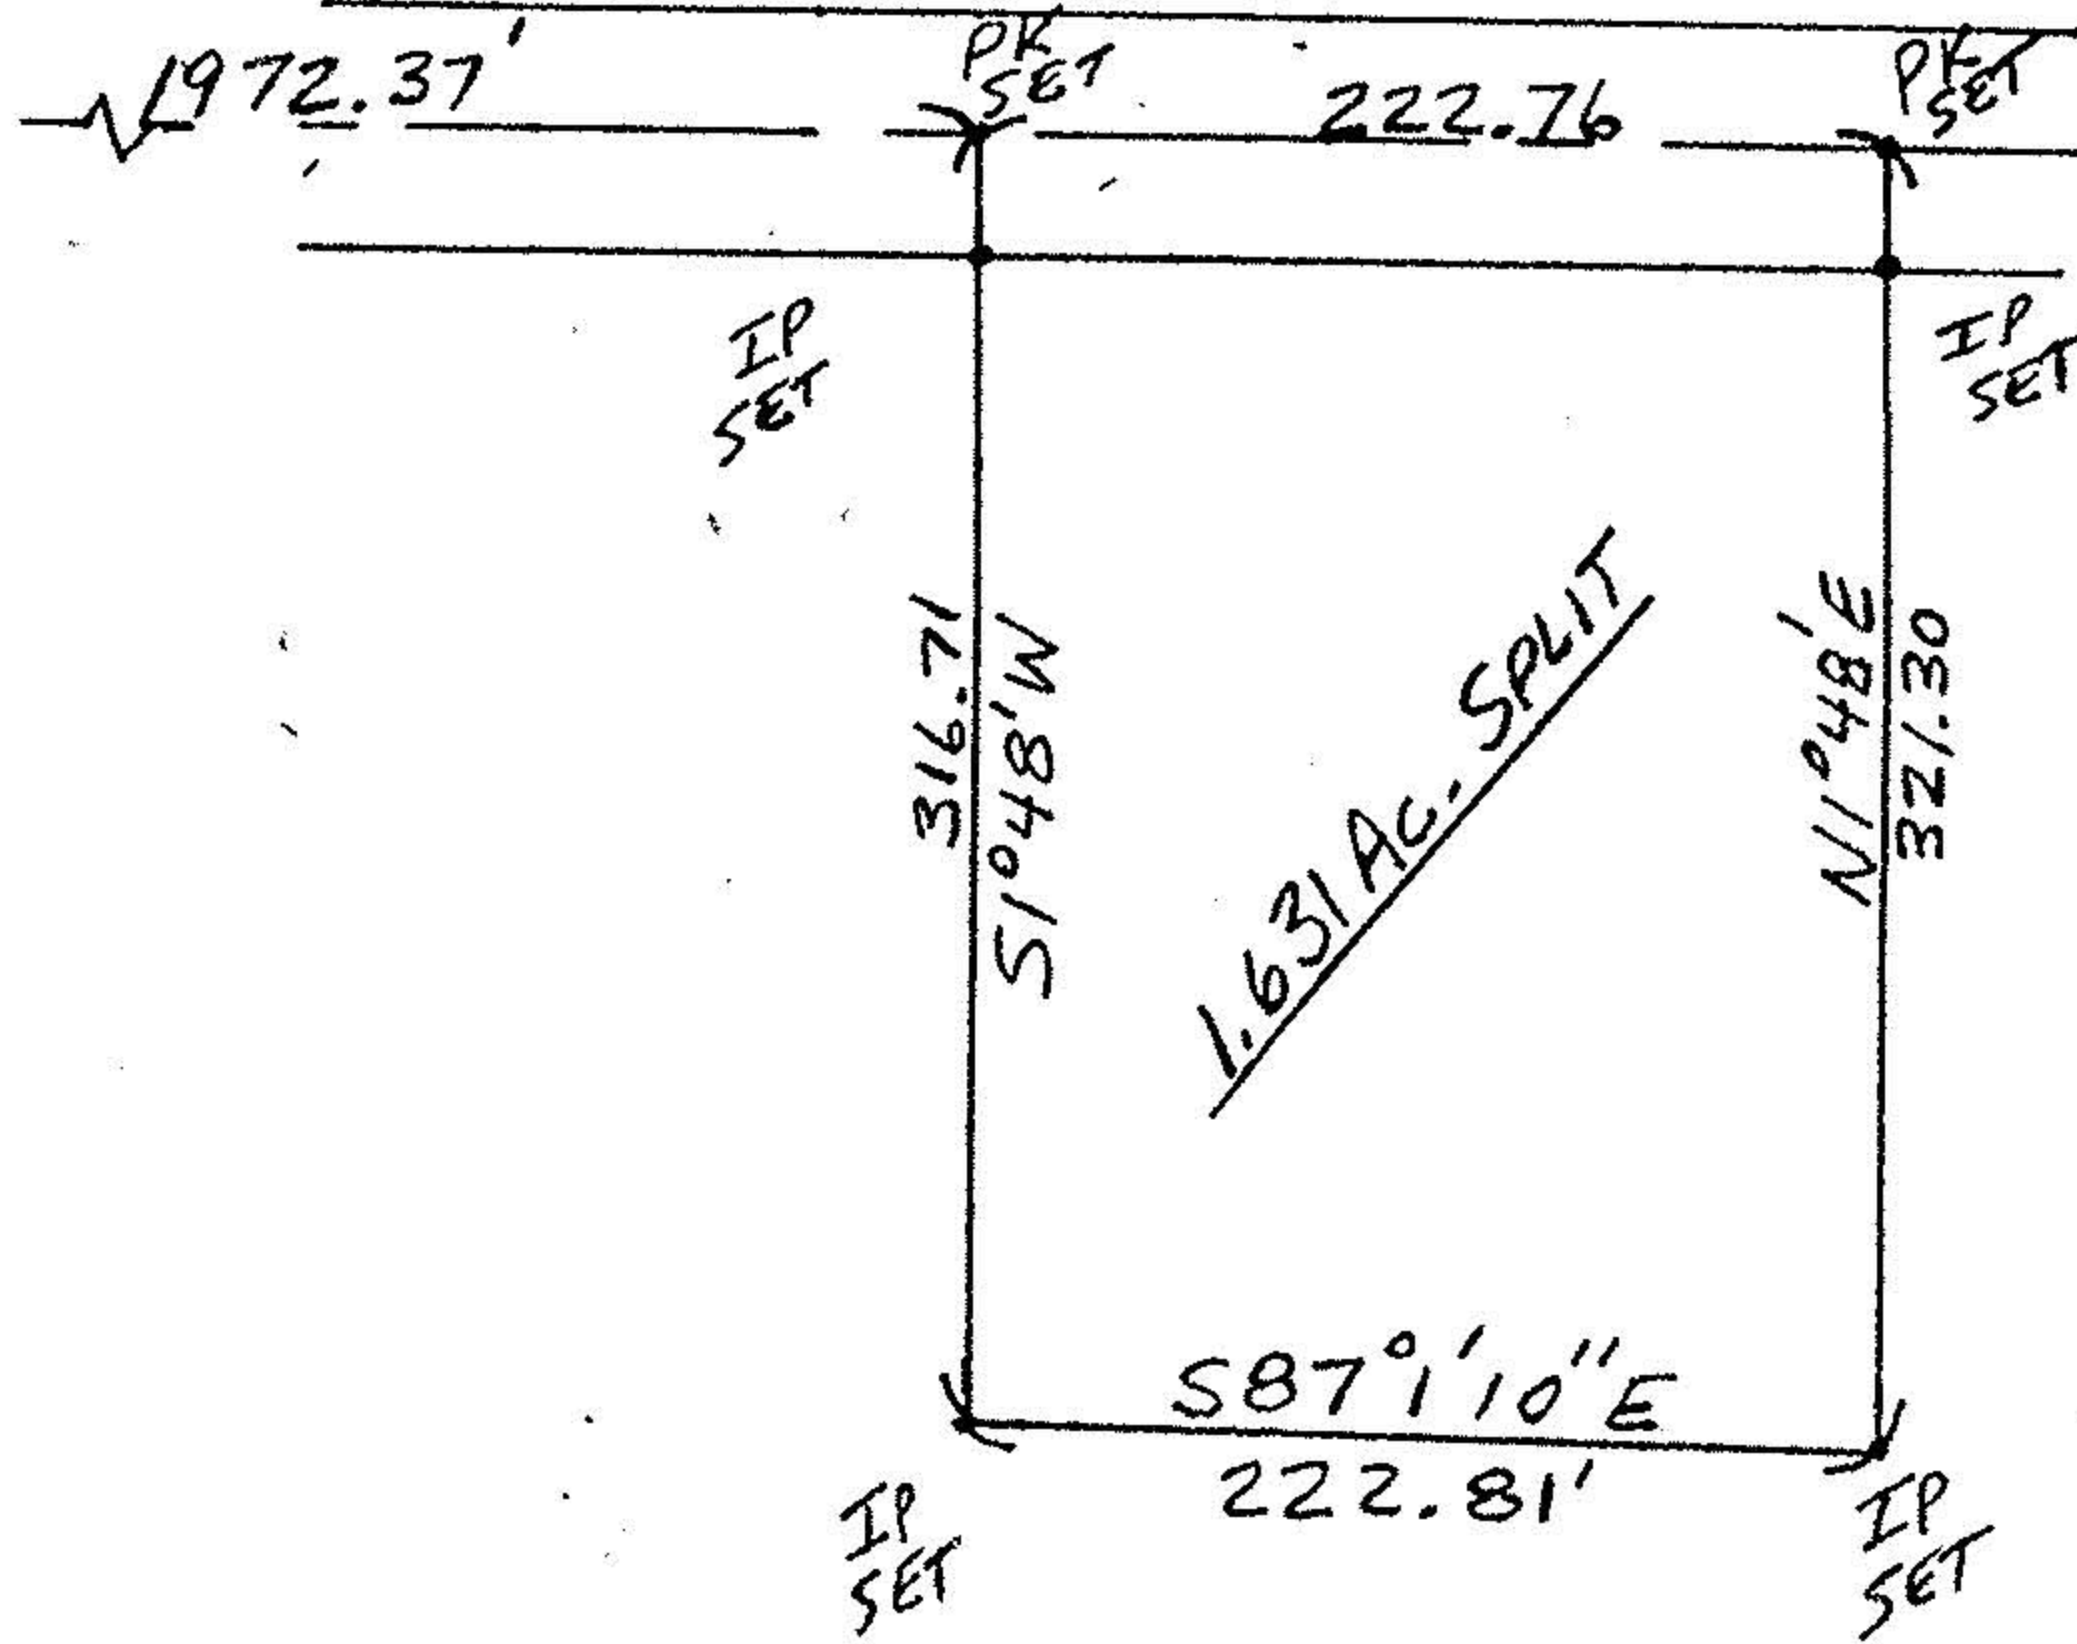

NEW LONDON EASTERN RD.
S88°12'E (60')

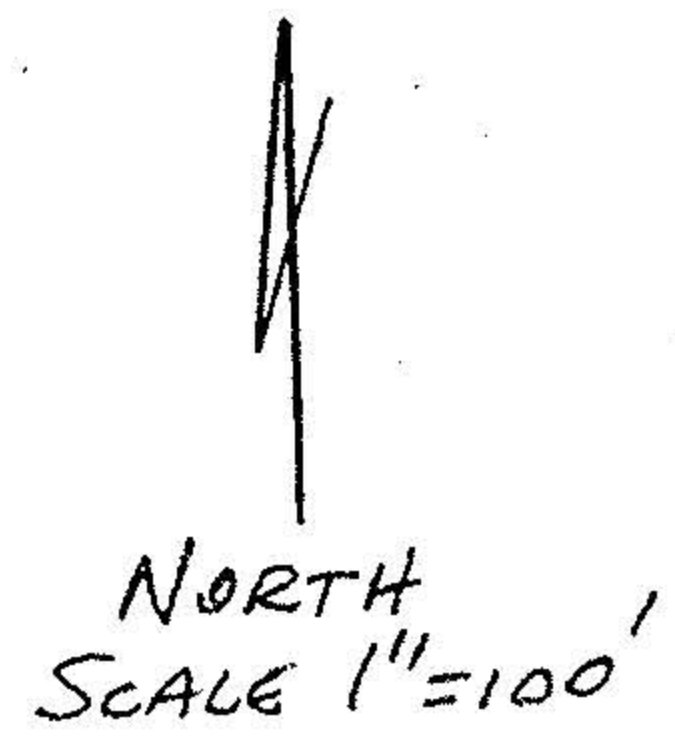

DON STOLL
 110.00 AC. OR 14.
 108.369 AC. REM.

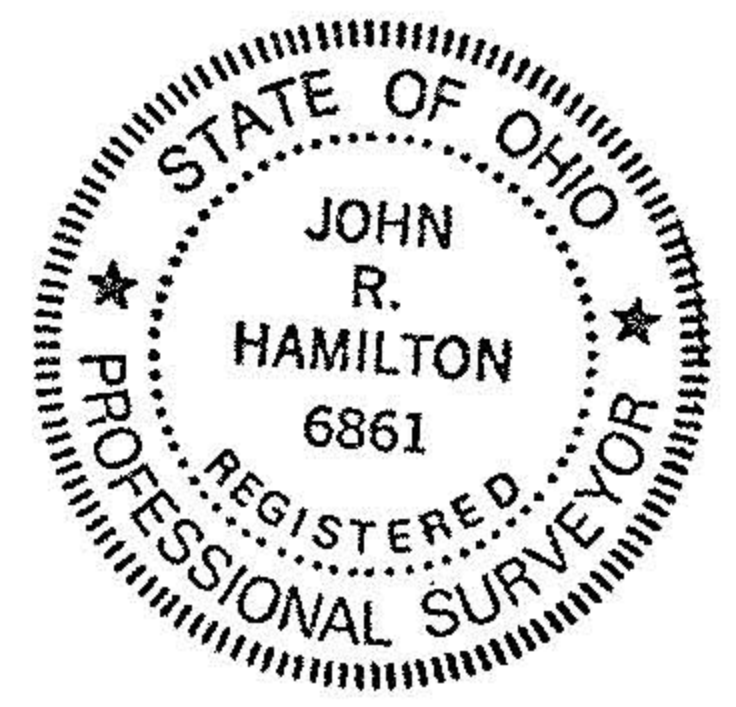

#19133

MAP OF SURVEY FOR DON STOLL
 ROCHESTER TWP. - TRACT #3 - D.L. #11
 AUG. 1990 SCALE 1"=100'
 JOHN R. HAMILTON - REG. SURV. #6861

APPROVED
LORAIN CO.
MAP DEPT.
DATE 9-24-90
PAGE 20-F
BY CAROLYN FRANCIS
VOID AFTER # 19133